DOUGLAS COUNTY SURVEYORS FILE DATA
DO NOT REMOVE FROM OFFICE

SURVEY TO CORRECT FILED SURVEY M 56-21 (C.S. 57\35)

FOR DOUG. CO. DEPT. OF PUBLIC WORKS

NARRATIVE

SURVEY TO CORRECT SURVEY MAP FILED IN COUNTY SURVEYOR RECORDS M 56-21 (C.S. 57\35). A SURVEY FILED IN COUNTY SURVEY RECORDS M 115-75 FOUND THE MONUMENT FOR THE SOUTHEAST CORNER OF THE OAKLAND TRANSFER SITE APPARENTLY DISTURBED AND OUT OF POSITION. FURTHER COMPARISON TO M 115-75 REVEALED A DIFFERENCE OF APPROXIMATELY 49 FEET BETWEEN MONUMENTS LOCATED IN THIS AREA.

THE 1\2" IRON ROD SITUATED ALONG THE EAST RIGHT-OF-WAY OF MANNING ROAD, THE 3\4" IRON PIPE SITUATED ABOUT 914 FEET EASTERLY AND THE MOST EASTERLY 3\4" IRON PIPE WERE HELD TO CONTROL THE SOUTH BOUNDARY. THIS BOUNDARY WAS INTERSECTED WITH A LINE USING RECORD BEARING FROM THE EAST 1\16 CORNER SECTIONS 32 AND 5 TO DETERMINE THE SOUTHEAST CORNER.

FENCES IN AREA RANDOM - GENERALLY WITHIN 5 FT. OF LINE.

NE 1/4 SECTION 5. T.25 S. R.5 W. W.M. (OAKLAND TRANSFER SITE)

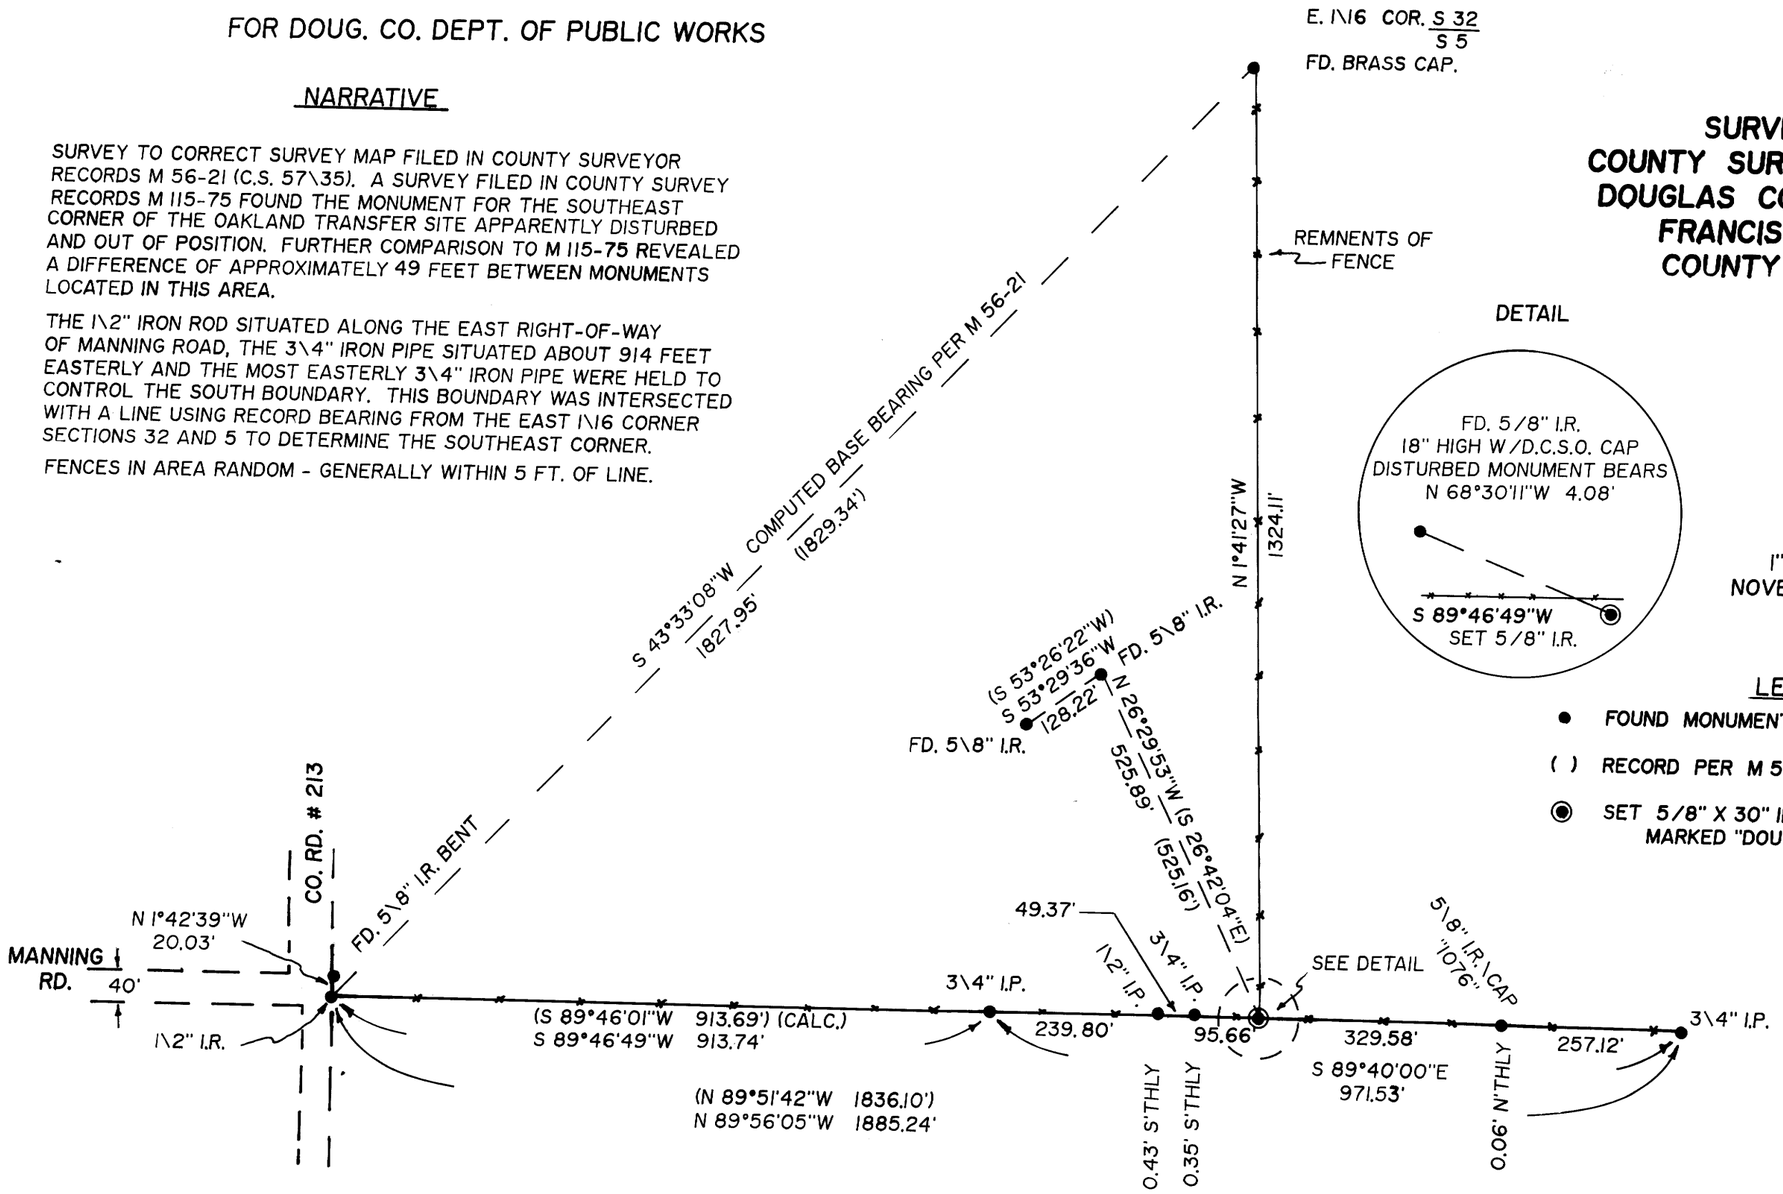

DETAIL

SURVEYED BY
COUNTY SURVEYOR'S OFFICE
DOUGLAS COUNTY, OREGON
FRANCIS L. INGRAM
COUNTY SURVEYOR

1" = 200'
NOVEMBER 1992

LEGEND

- ● FOUND MONUMENT AS DESCRIBED
- ( ) RECORD PER M 56-21 (C.S.57\35)
- ◉ SET 5/8" X 30" IRON ROD WITH ALUM. CAP MARKED "DOUGLAS CO. SURVEYOR"

REGISTERED PROFESSIONAL LAND SURVEYOR
Francis L. Ingram
OREGON JULY 11, 1989 FRANCIS L. INGRAM 902

EXPIRES 12/31/93

C S File 64/36
Map File M 116-24

C S File 64/36
Map File M 116-24