COUNTY SURVEYORS' FILE COPY
DO NOT REMOVE FROM OFFICE

FEB 19 1993

COUNTY SURVEYOR

SURVEY FOR INA BROOKS IN NE1/4 SECTION 6, T21S, R4W, W.M. DOUGLAS COUNTY, OREGON

BY

ROBERTS SURVEYING INC.
29 WEST 29TH STREET
EUGENE, OREGON 97405

NOVEMBER 4, 1992
SCALE 1" = 300'

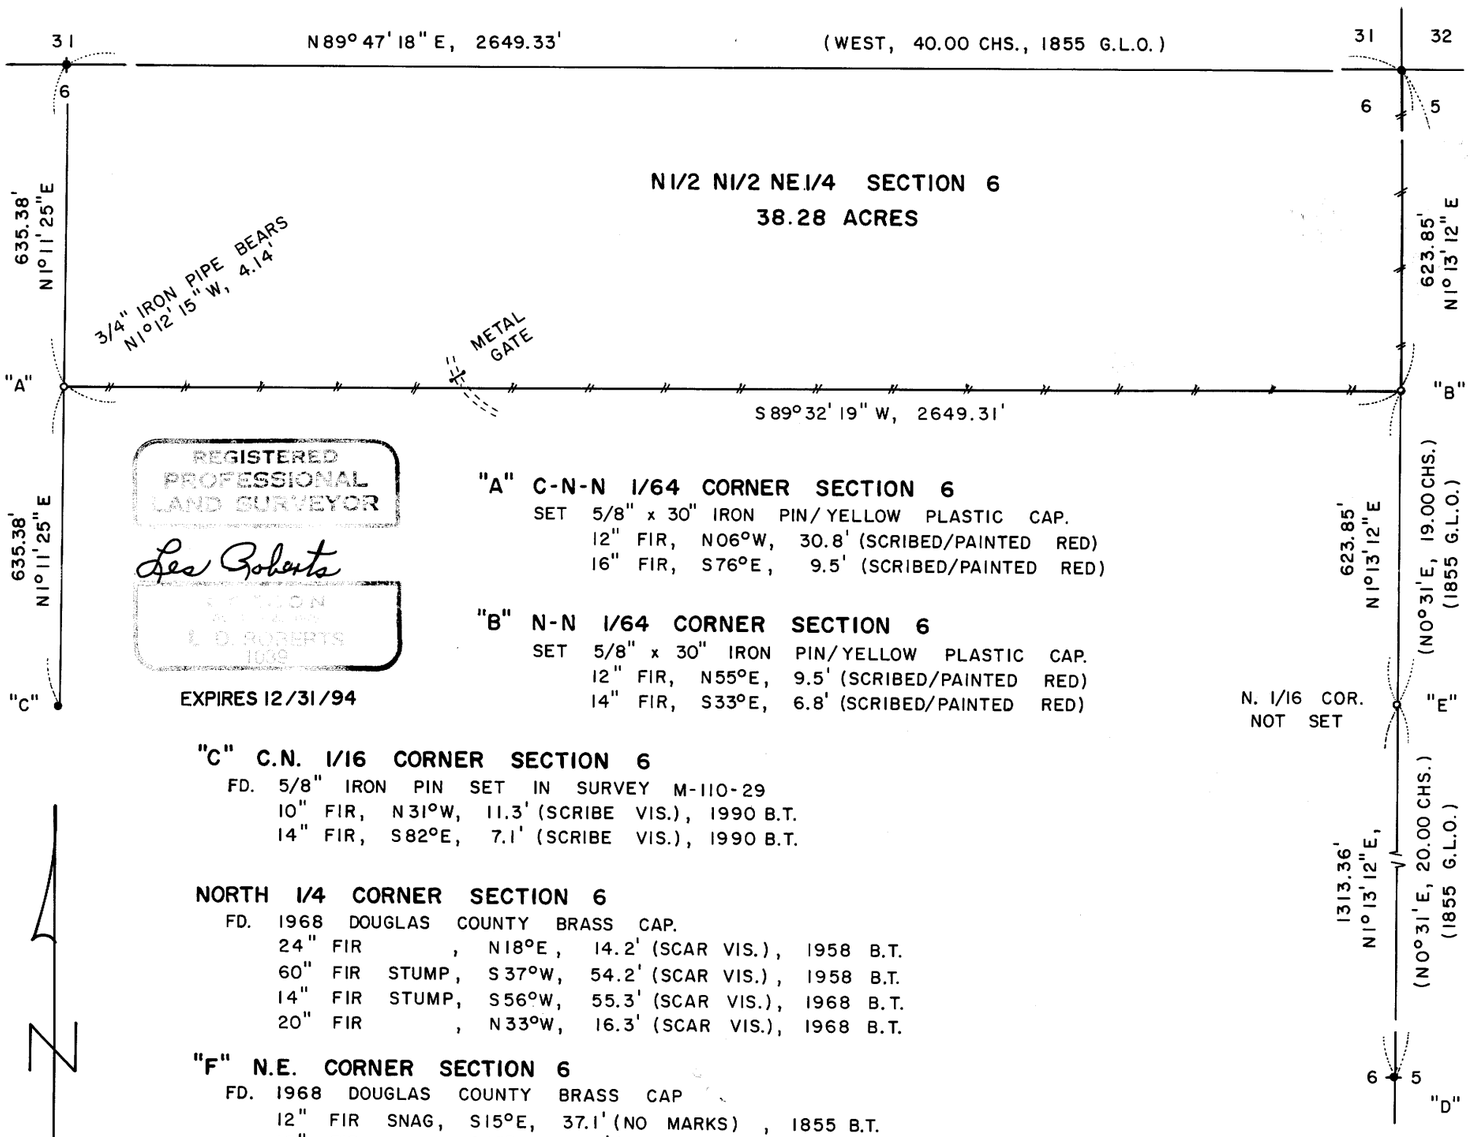

REGISTERED PROFESSIONAL LAND SURVEYOR
Les Roberts
OREGON
JANUARY 9, 1979
L. D. ROBERTS
1039
EXPIRES 12/31/94

"A" C-N-N 1/64 CORNER SECTION 6

SET 5/8" x 30" IRON PIN/YELLOW PLASTIC CAP.
12" FIR, N06°W, 30.8' (SCRIBED/PAINTED RED)
16" FIR, S76°E, 9.5' (SCRIBED/PAINTED RED)

"B" N-N 1/64 CORNER SECTION 6

SET 5/8" x 30" IRON PIN/YELLOW PLASTIC CAP.
12" FIR, N55°E, 9.5' (SCRIBED/PAINTED RED)
14" FIR, S33°E, 6.8' (SCRIBED/PAINTED RED)

"C" C.N. 1/16 CORNER SECTION 6

FD. 5/8" IRON PIN SET IN SURVEY M-110-29
10" FIR, N31°W, 11.3' (SCRIBE VIS.), 1990 B.T.
14" FIR, S82°E, 7.1' (SCRIBE VIS.), 1990 B.T.

NORTH 1/4 CORNER SECTION 6

FD. 1968 DOUGLAS COUNTY BRASS CAP.
24" FIR , N18°E, 14.2' (SCAR VIS.), 1958 B.T.
60" FIR STUMP, S37°W, 54.2' (SCAR VIS.), 1958 B.T.
14" FIR STUMP, S56°W, 55.3' (SCAR VIS.), 1968 B.T.
20" FIR , N33°W, 16.3' (SCAR VIS.), 1968 B.T.

"F" N.E. CORNER SECTION 6

FD. 1968 DOUGLAS COUNTY BRASS CAP
12" FIR SNAG, S15°E, 37.1' (NO MARKS) , 1855 B.T.
16" FIR , S45°W, 39.8' (SCAR VIS.) , 1968 B.T.
18" FIR , S27°E, 44.0' (SCAR VIS.) , 1968 B.T.
32" FIR , N05°W, 19.3' (SCAR VIS.) , 1968 B.T.
10" FIR , N89°E, 45.8' (SCRIBE VIS.), NO RECORD

"D" EAST 1/4 CORNER SECTION 6

FD. 1972 B.L.M. BRASS CAP.
18" FIR, N03°E, 23.4' (SCAR VIS.) , 1972 B.T.
34" FIR, N86°W, 27.8' (SCAR VIS.) , 1972 B.T.

LEGEND,

•	MONUMENTS FOUND AND USED FOR CONTROL
o	MONUMENTS SET, 5/8" x 30" IRON PINS WITH YELLOW PLASTIC CAPS. CAPS MARKED "ROBERTS P.L.S. 1039"
( )	DATA OF RECORD, 1855 G.L.O. SURVEY, 1971 B.L.M. SURVEY AND C.S. M-110-29
——//——	LINES MARKED WITH RED PAINTED BLAZED AND RED RIBBON.
	BASIS OF BEARING, SOLAR OBSERVATION
	DISTANCES TO B.T.'S ARE CENTER MEASURE

NARRATIVE, THE PURPOSE OF THIS SURVEY IS TO BLAZE AND PAINT THE EAST AND SOUTH LINES OF THE N1/2 N1/2 NE1/4 OF SECTION 6, T21S, R4W, W.M. THE C.N. 1/16 CORNER, THE NORTH 1/4 CORNER, THE N.E. SECTION CORNER AND THE EAST 1/4 CORNER WERE FOUND IN THE FIELD, AS SHOWN, AND USED AS CONTROL FOR THIS SURVEY. A SERIES OF CLOSED RANDOM TRAVERSES, USING A WILD T-16 THEODOLITE AND A DI-4L E.D.M., WERE RUN BETWEEN THE ABOVE MENTIONED CORNERS AND USED FOR CONTROL. THE C-N-N 1/64 CORNER, MONUMENT "A", WAS SET HALFWAY BETWEEN THE C.N. 1/16 CORNER AND THE NORTH 1/4 CORNER AS SHOWN. A PAPER POSITION WAS COMPUTED FOR THE NORTH 1/16 CORNER ON THE EAST LINE OF SECTION 6, POINT "D". SAID POSITION WAS COMPUTED BY USING SINGLE PROPORTIONATE MEASURE OF 20.00 CHAINS FOR LINE "D-E" AND 19.00 CHAINS FOR LINE "E-F", THUS THE RESULTING DISTANCE OF 1313.36 FEET FOR LINE "D-E" AND 1247.70 FEET FOR LINE "E-F". THE N-N 1/64 CORNER, MONUMENT "B", WAS SET HALFWAY BETWEEN COMPUTED POINT "E" AND FOUND N.E. SECTION CORNER "F"

SURVEY FILE M 116-48