

NARRATIVE:

PROPERTY CORNERS WERE RE-ESTABLISHED AFTER TYING FOUND MONUMENTS FROM VOL. 10, PG. 22 AND M 53-66.


FIELD CREW: NEIL HIBBS AND ROD McCALLISTER  
EQUIPMENT: NIKON DTM-A20  
OFFICE: NEIL HIBBS  
DRAFTING: SARAH MAC DONALD

LEGEND:

- SET 5/8" x 30" IRON ROD W/ CAP STAMPED "i.e. ENGINEERING"
- FOUND 5/8" IRON ROD PER M 53-66 UNLESS OTHERWISE NOTED
- FOUND 1" IRON ROD PER VOL.10, PG. 22
- ( ) RECORD PER VOL. 10, PG. 22
- [ ] RECORD PER M 53-66
- △ COMPUTED POINT

ARC INFORMATION:

- (A) R = 498.22'  
D = 11° 30' 00"  
L = 330.10'  
CH = N 11° 52' 51" W 324.10'
- (B) R = 473.22'  
D = 12° 06' 28"  
L = 79.88'  
CH = N 08° 42' 47" W 79.79'
- (C) R = 473.22'  
D = 12° 06' 28"  
L = 90.97'  
CH = N 01° 42' 35" E 90.83'

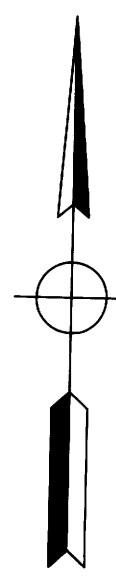

COUNTY SURVEYORS FILE DATA  
DO NOT REMOVE FROM OFFICE

	<b>SURVEY</b>	
	TO RE-ESTABLISH PROPERTY CORNERS OF LOT 2, BLOCK 2, WESTERN TERRACE IN: SW 1/4 SW 1/4 SECTION 19, TOWNSHIP 27 SOUTH, RANGE 5 WEST, WILLAMETTE MERIDIAN, DOUGLAS COUNTY, OREGON	
SURVEYED FOR: CAROL PFLANTZ 1164 S.E. KANE ROSEBURG, OREGON 97470	SURVEYED BY:  1205 S.E. Court Street Roseburg, Oregon 97470 PHONE (503) 673-0166 FAX (503) 440-9392	
EXPIRES 12-31-93	SCALE: 1" = 30'	DATE: JULY 1993
		PAGE: 1 OF 1