MAP FILE M119-29

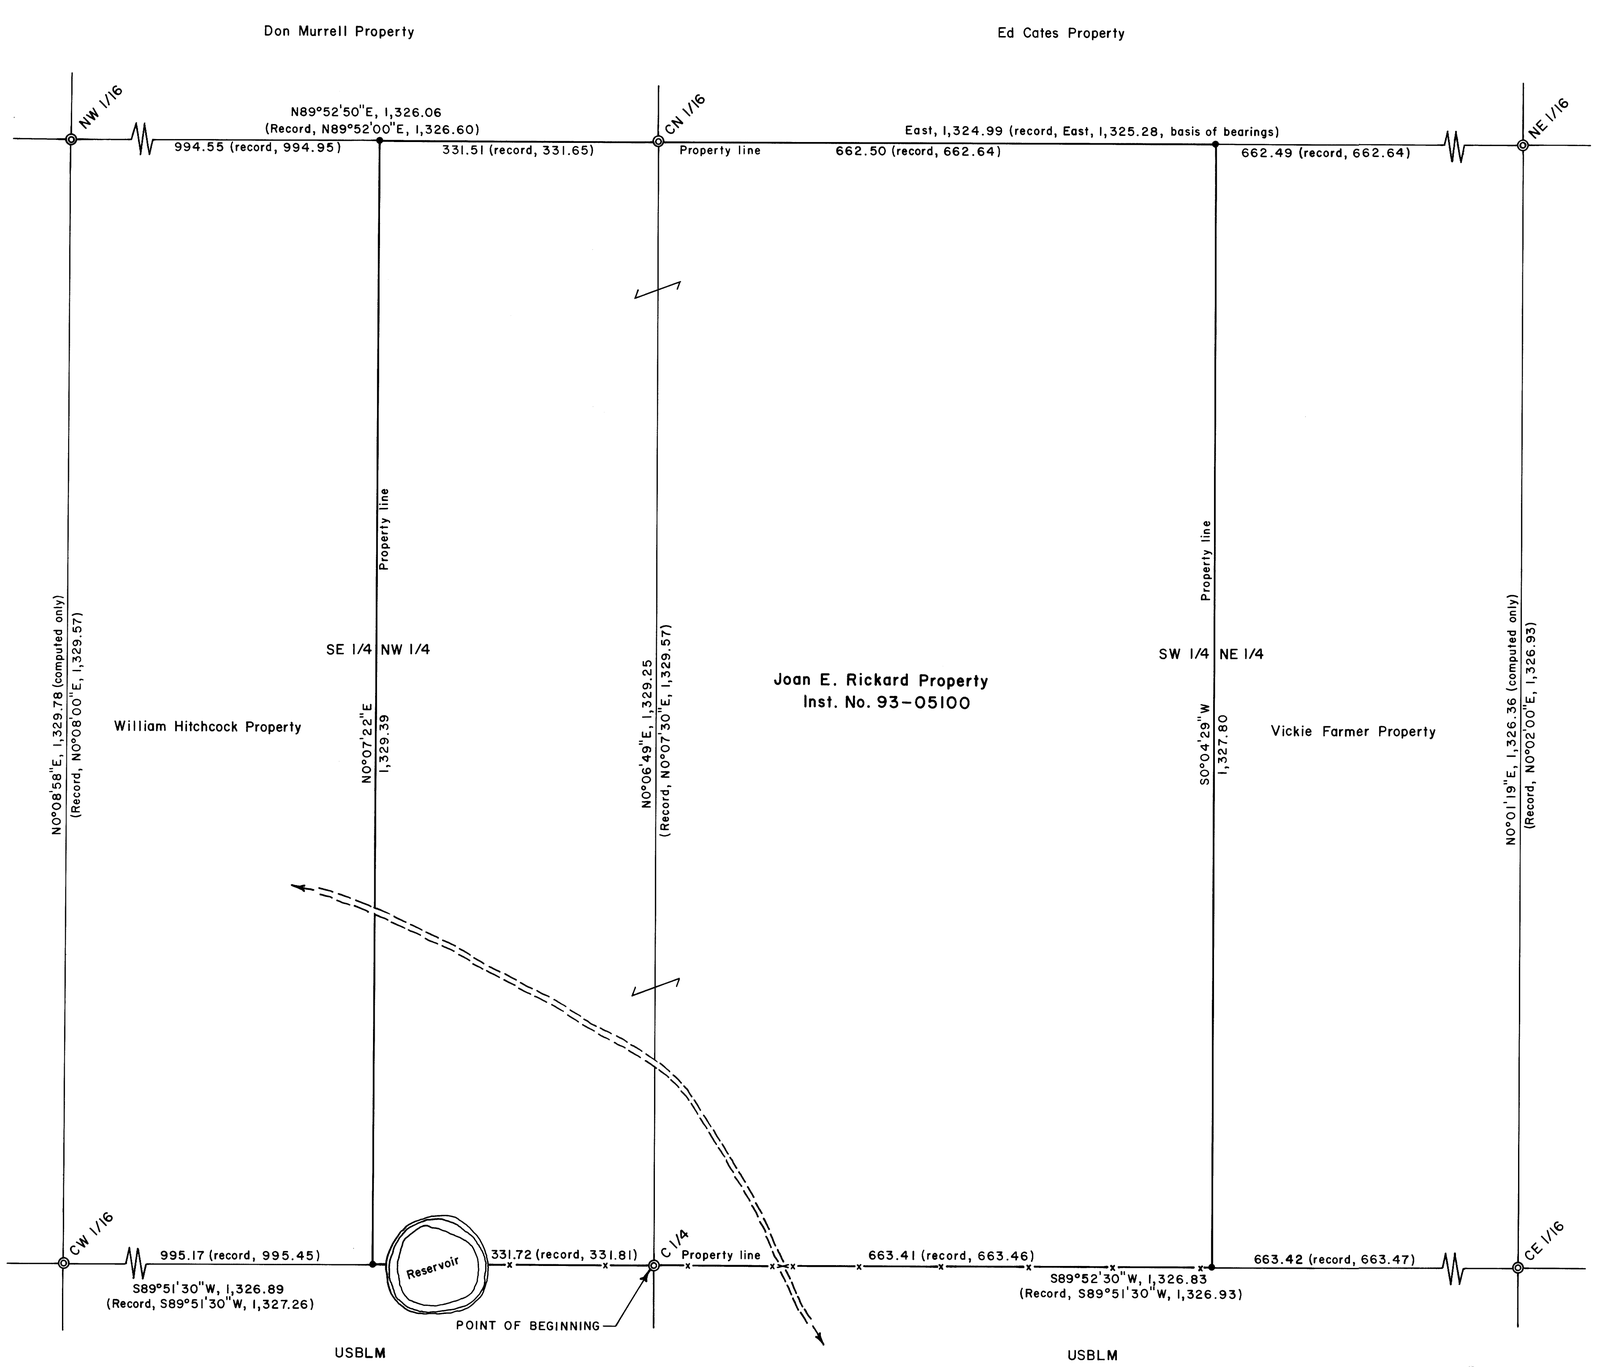

FILED
Date: 6-21-94 By: JC
This survey consists of:
Map: M119-29
Narrative:
Corner Rpt:
DOUGLAS COUNTY SURVEYOR

Basis of bearings is north line of SW 1/4 NE 1/4

100 0 100 200
Scale: 1" = 100 ft.

LEGEND

Corner found, USBLM brass cap	◎
Corner set, 5/8" x 30" iron rod with aluminum cap mkd. "Shaner Engr. RLS 430"	•
Property line marked with 6 ft. red steel fence posts & trees blazed and painted red	———
Fence	—x——x—
Gate	x—x
Access road	======

NARRATIVE:

The property line survey was accomplished to set the property corners and to mark the property lines for logging and fencing purposes. The U.S. Bureau of Land Management subdivided the section in 1990 and set the interior corners. We tied these USBLM corners shown and proportioned the distances to set the Rickard corners.

The survey was done in June, 1994, using a Jena 0°00'01" theodolite and a Mac II electronic distance meter. The USBLM corners were found to be as described in their 1990 survey notes.

REGISTERED PROFESSIONAL LAND SURVEYOR
Bruce A Shaner
OREGON OCT. 4, 1957
BRUCE A. SHANER 430
Expires Dec. 31, 1994

PROPERTY LINE SURVEY
in the N 1/2 of Section 35, T29S, R9W, W.M., Douglas County, Oregon

For: Joan E. Rickard
1417 NW 202nd Avenue
Camas, Washington 98607

By: Shaner Engineering, Inc.
P. O. Box 1430
Roseburg, Oregon 97470

June 20, 1994

MAP FILE M119-29