COUNTY SURVEYORS FILE DATA
DO NOT REMOVE FROM OFFICE

FILED
Date: 9-25-95 By: JC
This survey consists of:
Map: M 119 - 68
Narrative:
Corner Rpt:
DOUGLAS COUNTY
SURVEYOR CB

MAP FILE M 119-68

PROPERTY LINE SURVEY IN THE WEST 1/2 OF SECTION 26. TOWNSHIP 30 SOUTH, RANGE 6 WEST. W.M.

for Thomas and Carolyn Ireland

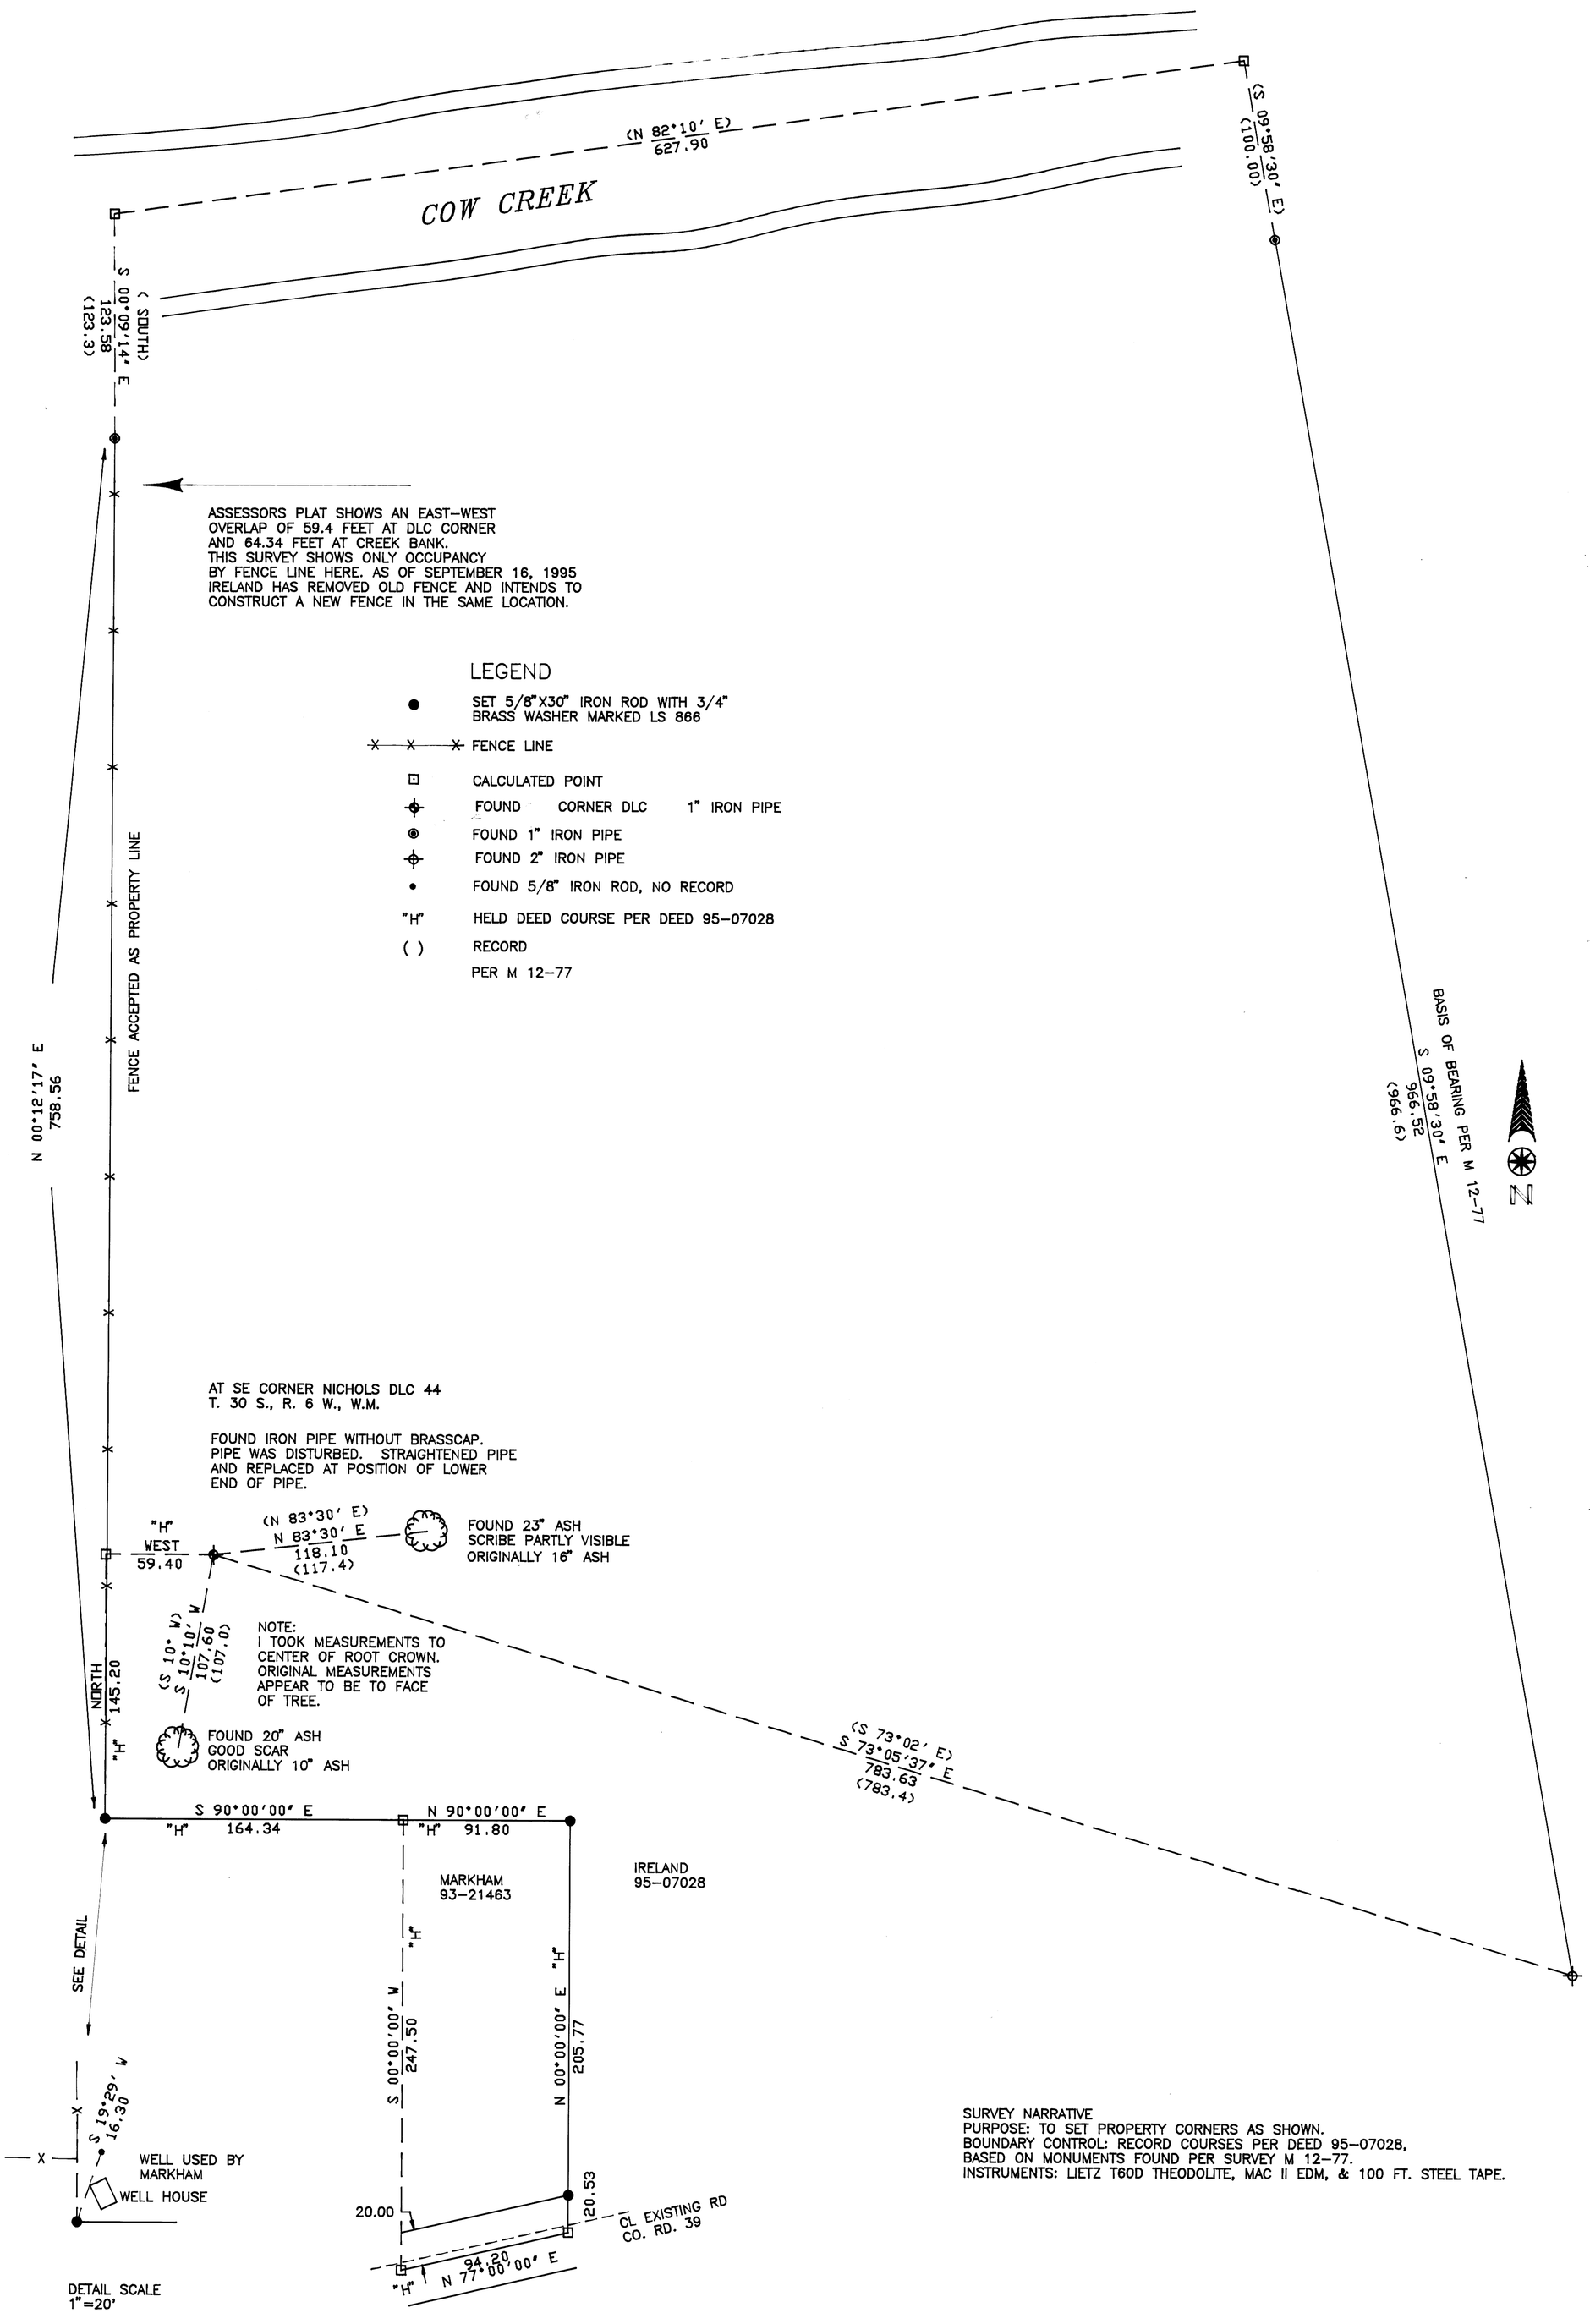

SURVEY NARRATIVE
PURPOSE: TO SET PROPERTY CORNERS AS SHOWN.
BOUNDARY CONTROL: RECORD COURSES PER DEED 95–07028,
BASED ON MONUMENTS FOUND PER SURVEY M 12–77.
INSTRUMENTS: LIETZ T60D THEODOLITE, MAC II EDM, & 100 FT. STEEL TAPE.

REGISTERED
OREGON
LAND SURVEYOR
JULY 12, 1968
WILLIAM J. RUPPERT
866
MY REGISTRATION EXPIRES 12/31/1996

Surveyed by:

WILLIAM J. RUPPERT
P.O. BOX 1564
MYRTLE CREEK, OR 97457

SCALE 1"=50'
June 1995
SHEET 1 OF 1

MAP FILE M 119-68