8-611W

COUNTY SURVEYORS FILE DATA
DO NOT REMOVE FROM OFFICE

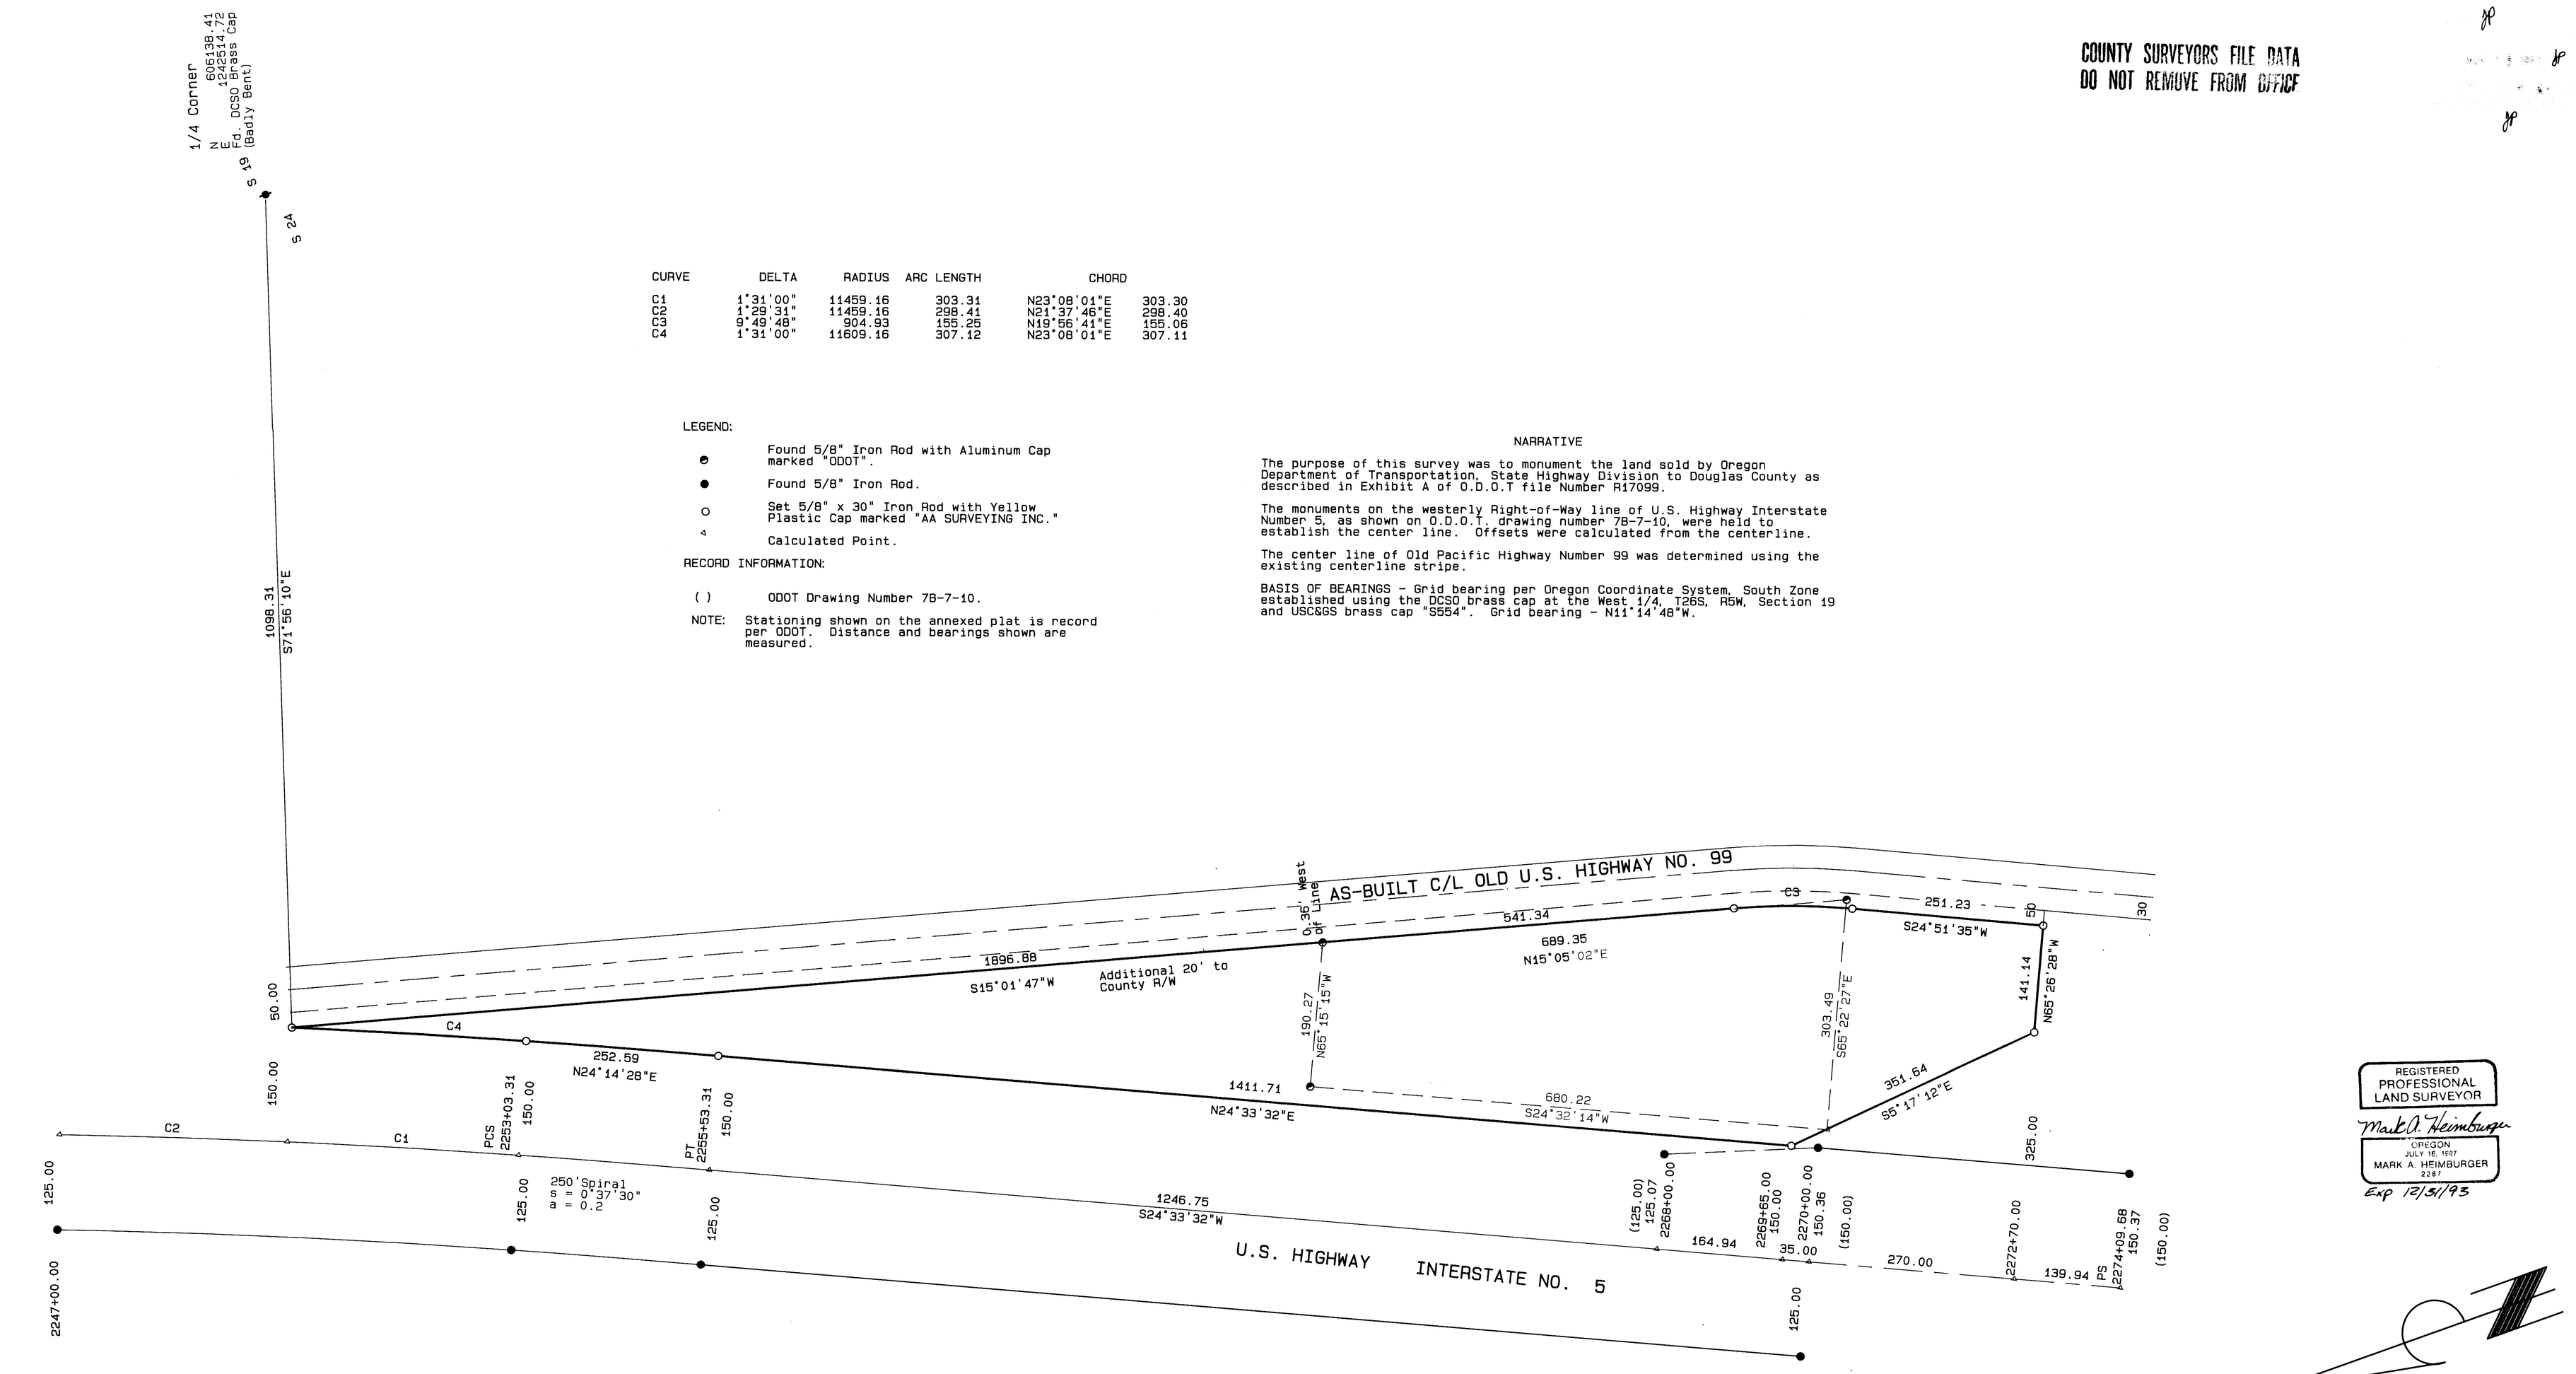

CURVE	DELTA	RADIUS	ARC LENGTH	CHORD	
C1	1°31'00"	11459.16	303.31	N23°08'01"E	303.30
C2	1°29'31"	11459.16	298.41	N21°37'46"E	298.40
C3	9°49'48"	904.93	155.25	N19°56'41"E	155.06
C4	1°31'00"	11609.16	307.12	N23°08'01"E	307.11

LEGEND:

- ◓ Found 5/8" Iron Rod with Aluminum Cap marked "ODOT".
- ● Found 5/8" Iron Rod.
- ○ Set 5/8" x 30" Iron Rod with Yellow Plastic Cap marked "AA SURVEYING INC."
- ◁ Calculated Point.

RECORD INFORMATION:

- ( ) ODOT Drawing Number 7B-7-10.

NOTE: Stationing shown on the annexed plat is record per ODOT. Distance and bearings shown are measured.

NARRATIVE

The purpose of this survey was to monument the land sold by Oregon Department of Transportation, State Highway Division to Douglas County as described in Exhibit A of O.D.O.T file Number R17099.

The monuments on the westerly Right-of-Way line of U.S. Highway Interstate Number 5, as shown on O.D.O.T. drawing number 7B-7-10, were held to establish the center line. Offsets were calculated from the centerline.

The center line of Old Pacific Highway Number 99 was determined using the existing centerline stripe.

BASIS OF BEARINGS - Grid bearing per Oregon Coordinate System, South Zone established using the DCSO brass cap at the West 1/4, T26S, R5W, Section 19 and USC&GS brass cap "S554". Grid bearing - N11°14'48"W.

REGISTERED PROFESSIONAL LAND SURVEYOR
Mark A. Heimburger
OREGON
JULY 16, 1937
MARK A. HEIMBURGER
2287
Exp 12/31/93

PROPERTY SURVEY

In the East 1/2, Section 24, T26S, R6W, W.M.
For Douglas County Department of Public Works
5 NOV 1993

0 100 200 300
1 inch : 100 feet
PAGE 1 OF 1

COUNTY SURVEYORS FILE DATA
DO NOT REMOVE FROM OFFICE

AA SURVEYING SERVICE, INC - 2566 N. STEPHENS STREET - ROSEBURG, OREGON 97470 - TEL (503) 672-2096

1422-93

MAP FILE M113-8