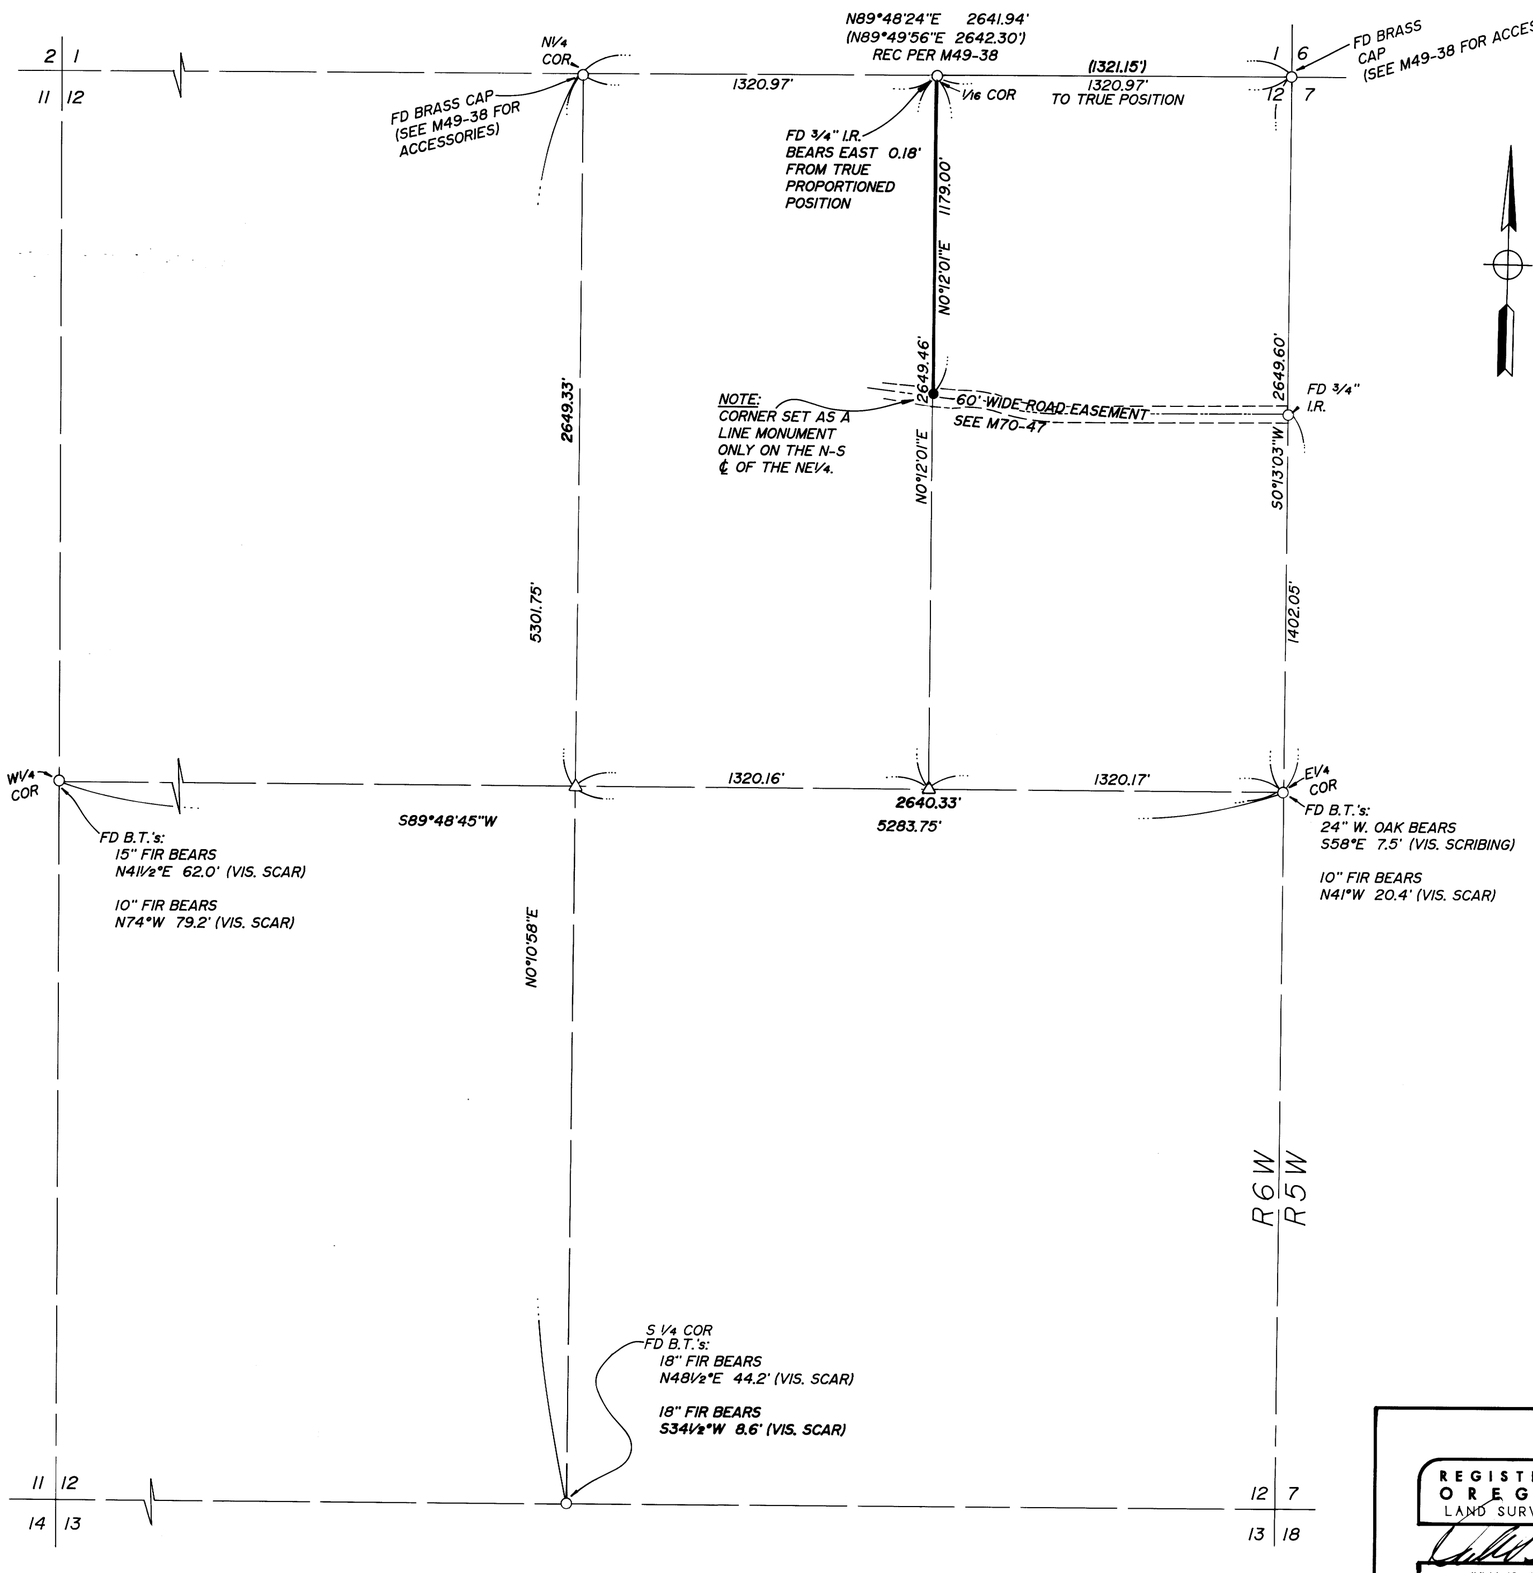

FILED
Date: 8/5/94 By: BC
This survey consists of:
Map: M 120-42
Narrative: ____
Corner Rpt: ____

JC DOUGLAS COUNTY JC
SURVEYOR

MAP FILE M 120-42

LEGEND

- ● SET 5/8" x 30" I.R. w/CAP MARKED "i.e. ENGINEERING" UNLESS NOTED OTHERWISE
- ○ FD BRASS CAP UNLESS NOTED OTHERWISE
- △ COMPUTED POINT
- ——— FLAGGED LINE

NARRATIVE:

SURVEY TO LOCATE AND FLAG THE NORTH-SOUTH CENTERLINE OF THE NE1/4 OF SECTION 12 AS SHOWN. BEARINGS ARE BASED ON G.P.S. OBSERVATION USING TRIMBLE 4000 ST RECEIVERS, ROTATING FROM GRID TO TRUE (⊖=-1°57'05").

FIELD CREW: NEIL HIBBS & DAN HOLBORROW
OFFICE: ROMEY WARE
DRAFTING: BETH MORGAN

REGISTERED OREGON LAND SURVEYOR
JULY 12, 1968
DONALD A. BENTZ
839
EXPIRES 12-31-95

SURVEY

IN: NE1/4 SEC 12, T24S, R6W, W.M., DOUGLAS COUNTY, OREGON

SURVEYED FOR:
RUSS MILLER
7494 MOJAVE TROPICO
MOJAVE, CA 973501

SURVEYED BY:
i.e. ENGINEERING
548 S.E. Jackson - Suite 3
Roseburg, Oregon 97470
PHONE (503) 673-0166
FAX (503) 440-9392

SCALE: 1"=400' | DATE: JULY 1994 | 994-01 | PAGE: 1 OF 1

MAP FILE M120-42

COUNTY SURVEYORS FILE DATA
DO NOT REMOVE FROM OFFICE