FILED

Date: 12/29/94 By: DP

This survey consists of:

Map: M 121-23

Narrative: _____

Corner Rpt: _____

DOUGLAS COUNTY
SURVEYOR

MAP FILE M 121-23

LEGEND

- ● SET 5/8" x 30" I.R. w/CAP MARKED "I.e. ENGINEERING" UNLESS NOTED OTHERWISE
- ○ FD 3/4" I.R. UNLESS NOTED OTHERWISE
- ( ) RECORD DATA PER "FOURTH ADDITION TO OVERLOOK"
- [ ] RECORD DATA PER "SKYLINE TERRACE"

NARRATIVE:

SURVEY TO ADJUST LOT LINE BETWEEN LOT 7, "FOURTH ADDITION TO OVERLOOK" (V12, P57) AND LOT 1, BLOCK 1, "SKYLINE TERRACE" (V15, P22). THE MOST WESTERLY CORNER OF SAID LOT 1 WAS SET AT PROPORTIONATE DISTANCE BETWEEN FOUND MONUMENTS ON THE SOUTHEASTERLY LINE OF SAID LOT 7.

FIELD CREW: NEIL HIBBS & DAVE WILLIAMS
EQUIPMENT: NIKON TOTAL STATION
OFFICE: ROMEY WARE
DRAFTING: BETH MORGAN

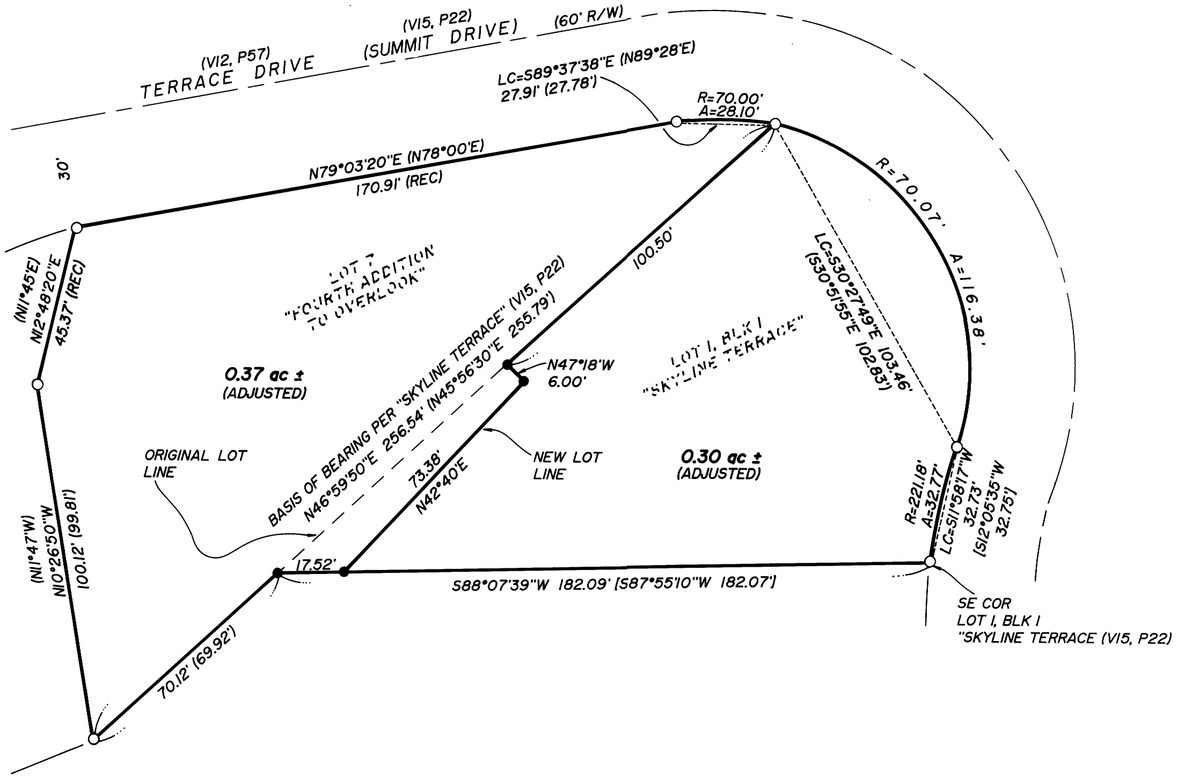

APPROVAL:

_____ 12-8-94
COMMUNITY DEVELOPMENT DIRECTOR — DATE
CITY OF ROSEBURG

ZONE: R-1-10
COMP. PLAN: LOW DENSITY RESIDENTIAL
WATER: CITY OF ROSEBURG
SEWER: R.U.S.A.

COUNTY SURVEYORS FILE DATA
DO NOT REMOVE FROM OFFICE

REGISTERED
OREGON
LAND SURVEYOR
JULY 12, 1966
DONALD A. BENTZ
839
EXPIRES 12-31-95

LOT LINE ADJUSTMENT

OF LOT 1, BLK 1, "SKYLINE TERRACE" & LOT 7, "FOURTH ADDITION TO OVERLOOK"
IN: SE¼ SEC 19, T27S, R5W, W.M.,
DOUGLAS COUNTY, OREGON

SURVEYED FOR:
DAVE LONGTIN
295 SE TERRACE DRIVE
ROSEBURG, OREGON 97470
(503) 672-8661

SURVEYED BY:
i.e. ENGINEERING
548 S.E. Jackson Suite 3
Roseburg, Oregon 97470
PHONE (503) 673-0166
FAX (503) 440-9392

SCALE: 1"=30' | DATE: NOV. 1994 | 991-01 | PAGE: 1 OF 1

MAP FILE M 121-23

BLA-94-9