SURVEY FOR BOUNDARY LINE ADJUSTMENT LOCATED IN SECTION 12, T.24S., R.6 W., W.M., DOUGLAS COUNTY, OREGON

FOR· CHARLES YOUNGER

DATE· DECEMBER, 1994

SCALE· 1" = 200'

BY· ROBERT L. DOLAN
3614 NONPARIEL RD.
SUTHERLIN, OR. 97479

Legend·
- ○ FD. 5/8" IRON ROD OR AS NOTED
- ◎ FD BRASS CAP 1/4 COR. S. 11-12 PLS 544 1973
- ◑ POINT COMPUTED AT RECORD BEARING AND DISTANCE AS PER M 115-49
- ● SET 5/8" x 30" IRON ROD W/CAP (LS 076)
- (REC.) RECORD DATA AS PER M115-49

FILED
Date: 2-14-95 By: AP
This survey consists of:
Map: M121-48
Narrative:
Corner Rpt:
DOUGLAS COUNTY SURVEYOR

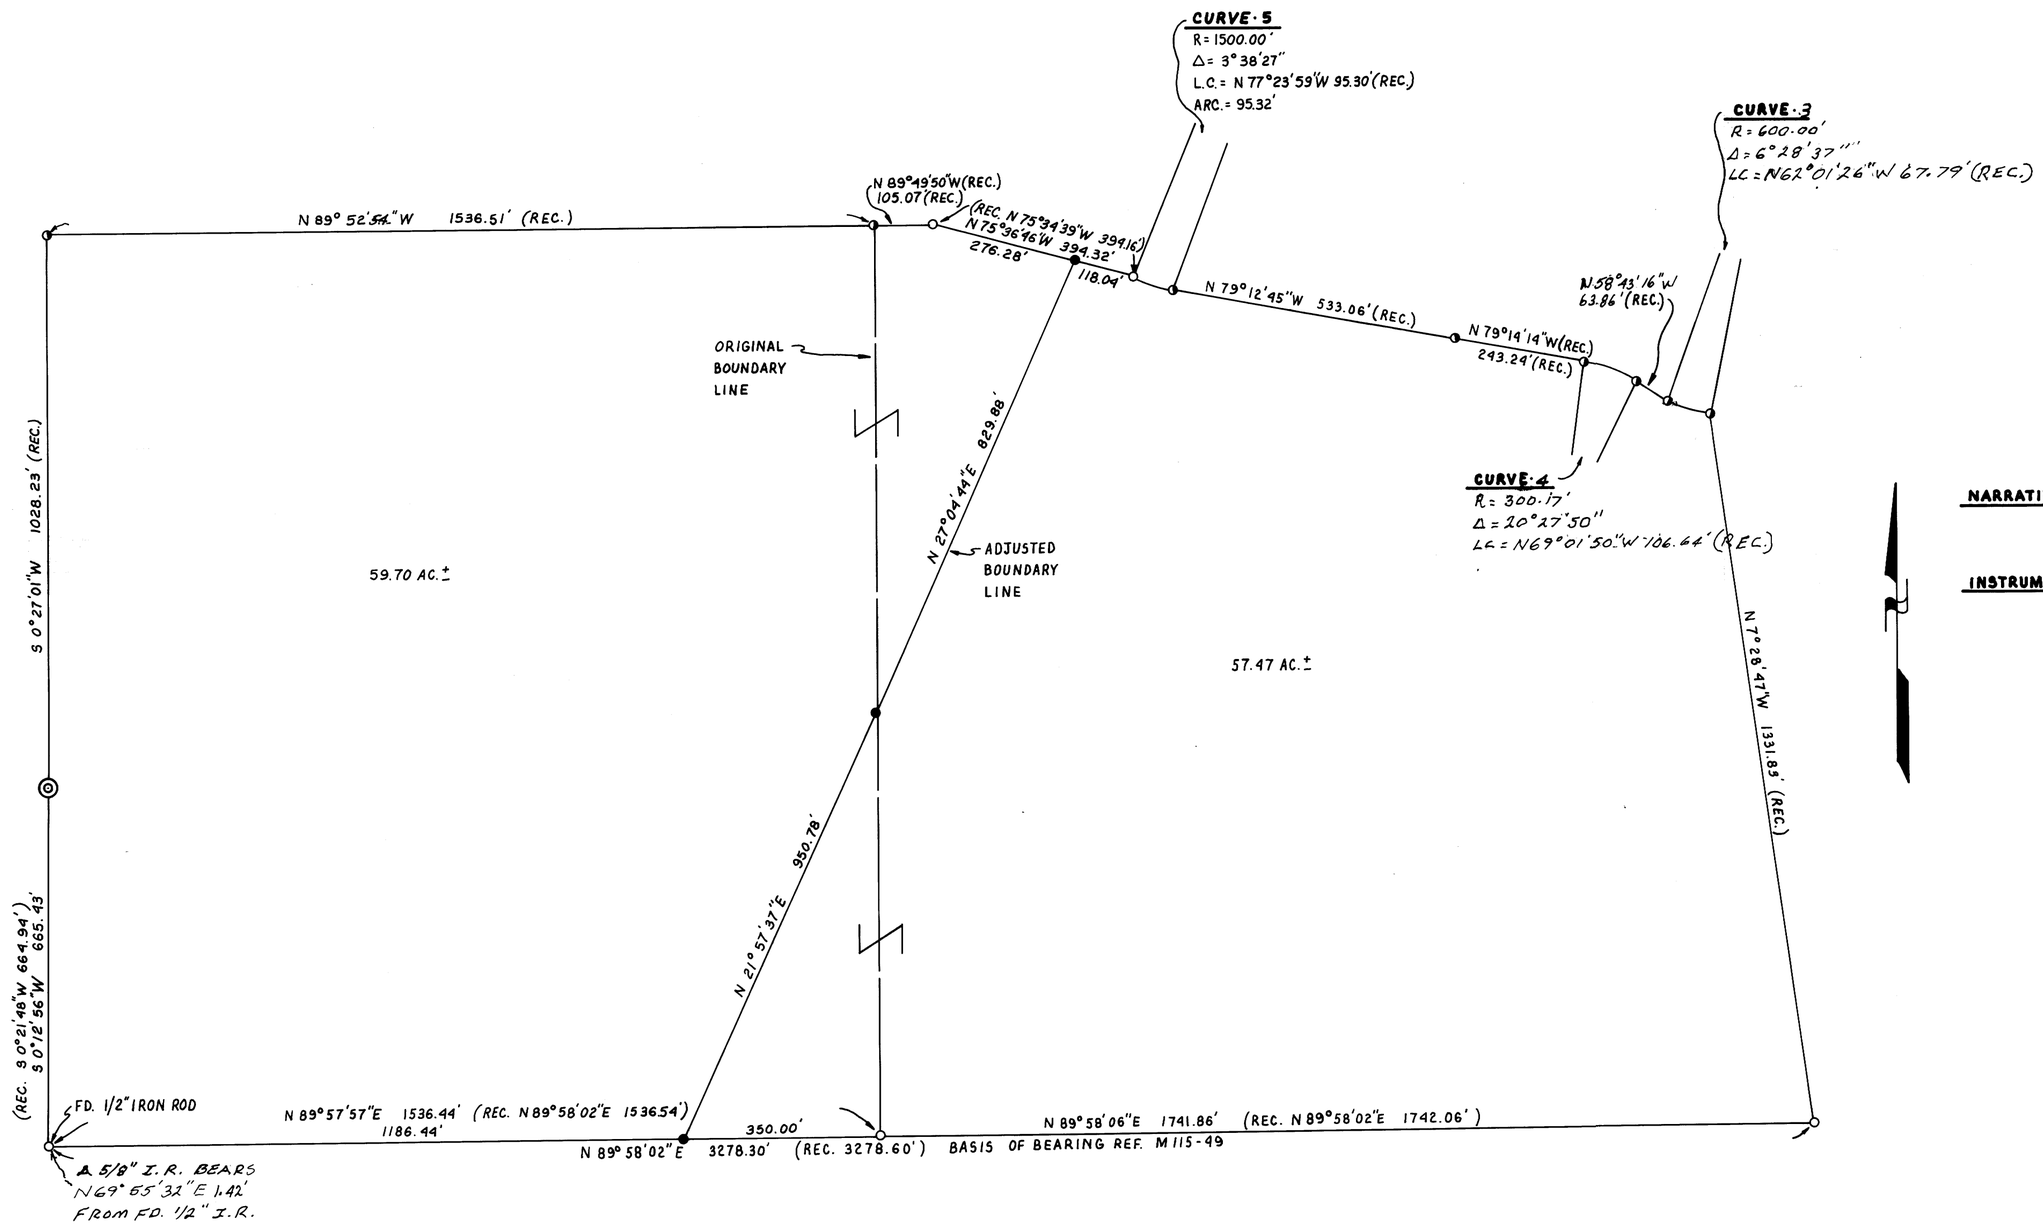

NARRATIVE· BOUNDARY LINE ADJUSTMENT SURVEY. MONUMENTS SET FROM FOUND MONUMENTS.

INSTRUMENT· NIKON DTM-A10LG TOTAL STATION

REGISTERED PROFESSIONAL LAND SURVEYOR
Robert L Dolan
OREGON
July 30, 1976
ROBERT L. DOLAN
1076
EXP. 12-31-95

APPROVAL: Keith L. Cubic 12/14/94
DOUGLAS COUNTY PLANNING DIRECTOR — DATE
P.D. FILE NO. 94-191

COUNTY SURVEYORS FILE DATA
DO NOT REMOVE FROM OFFICE

MAP FILE M121-48