MAP FILE M121-5

FILED
Date: 11-22-94 By: JC
This survey consists of:
Map: M 121-5
Narrative:
Corner Rpt:
JC DOUGLAS COUNTY SURVEYOR JC

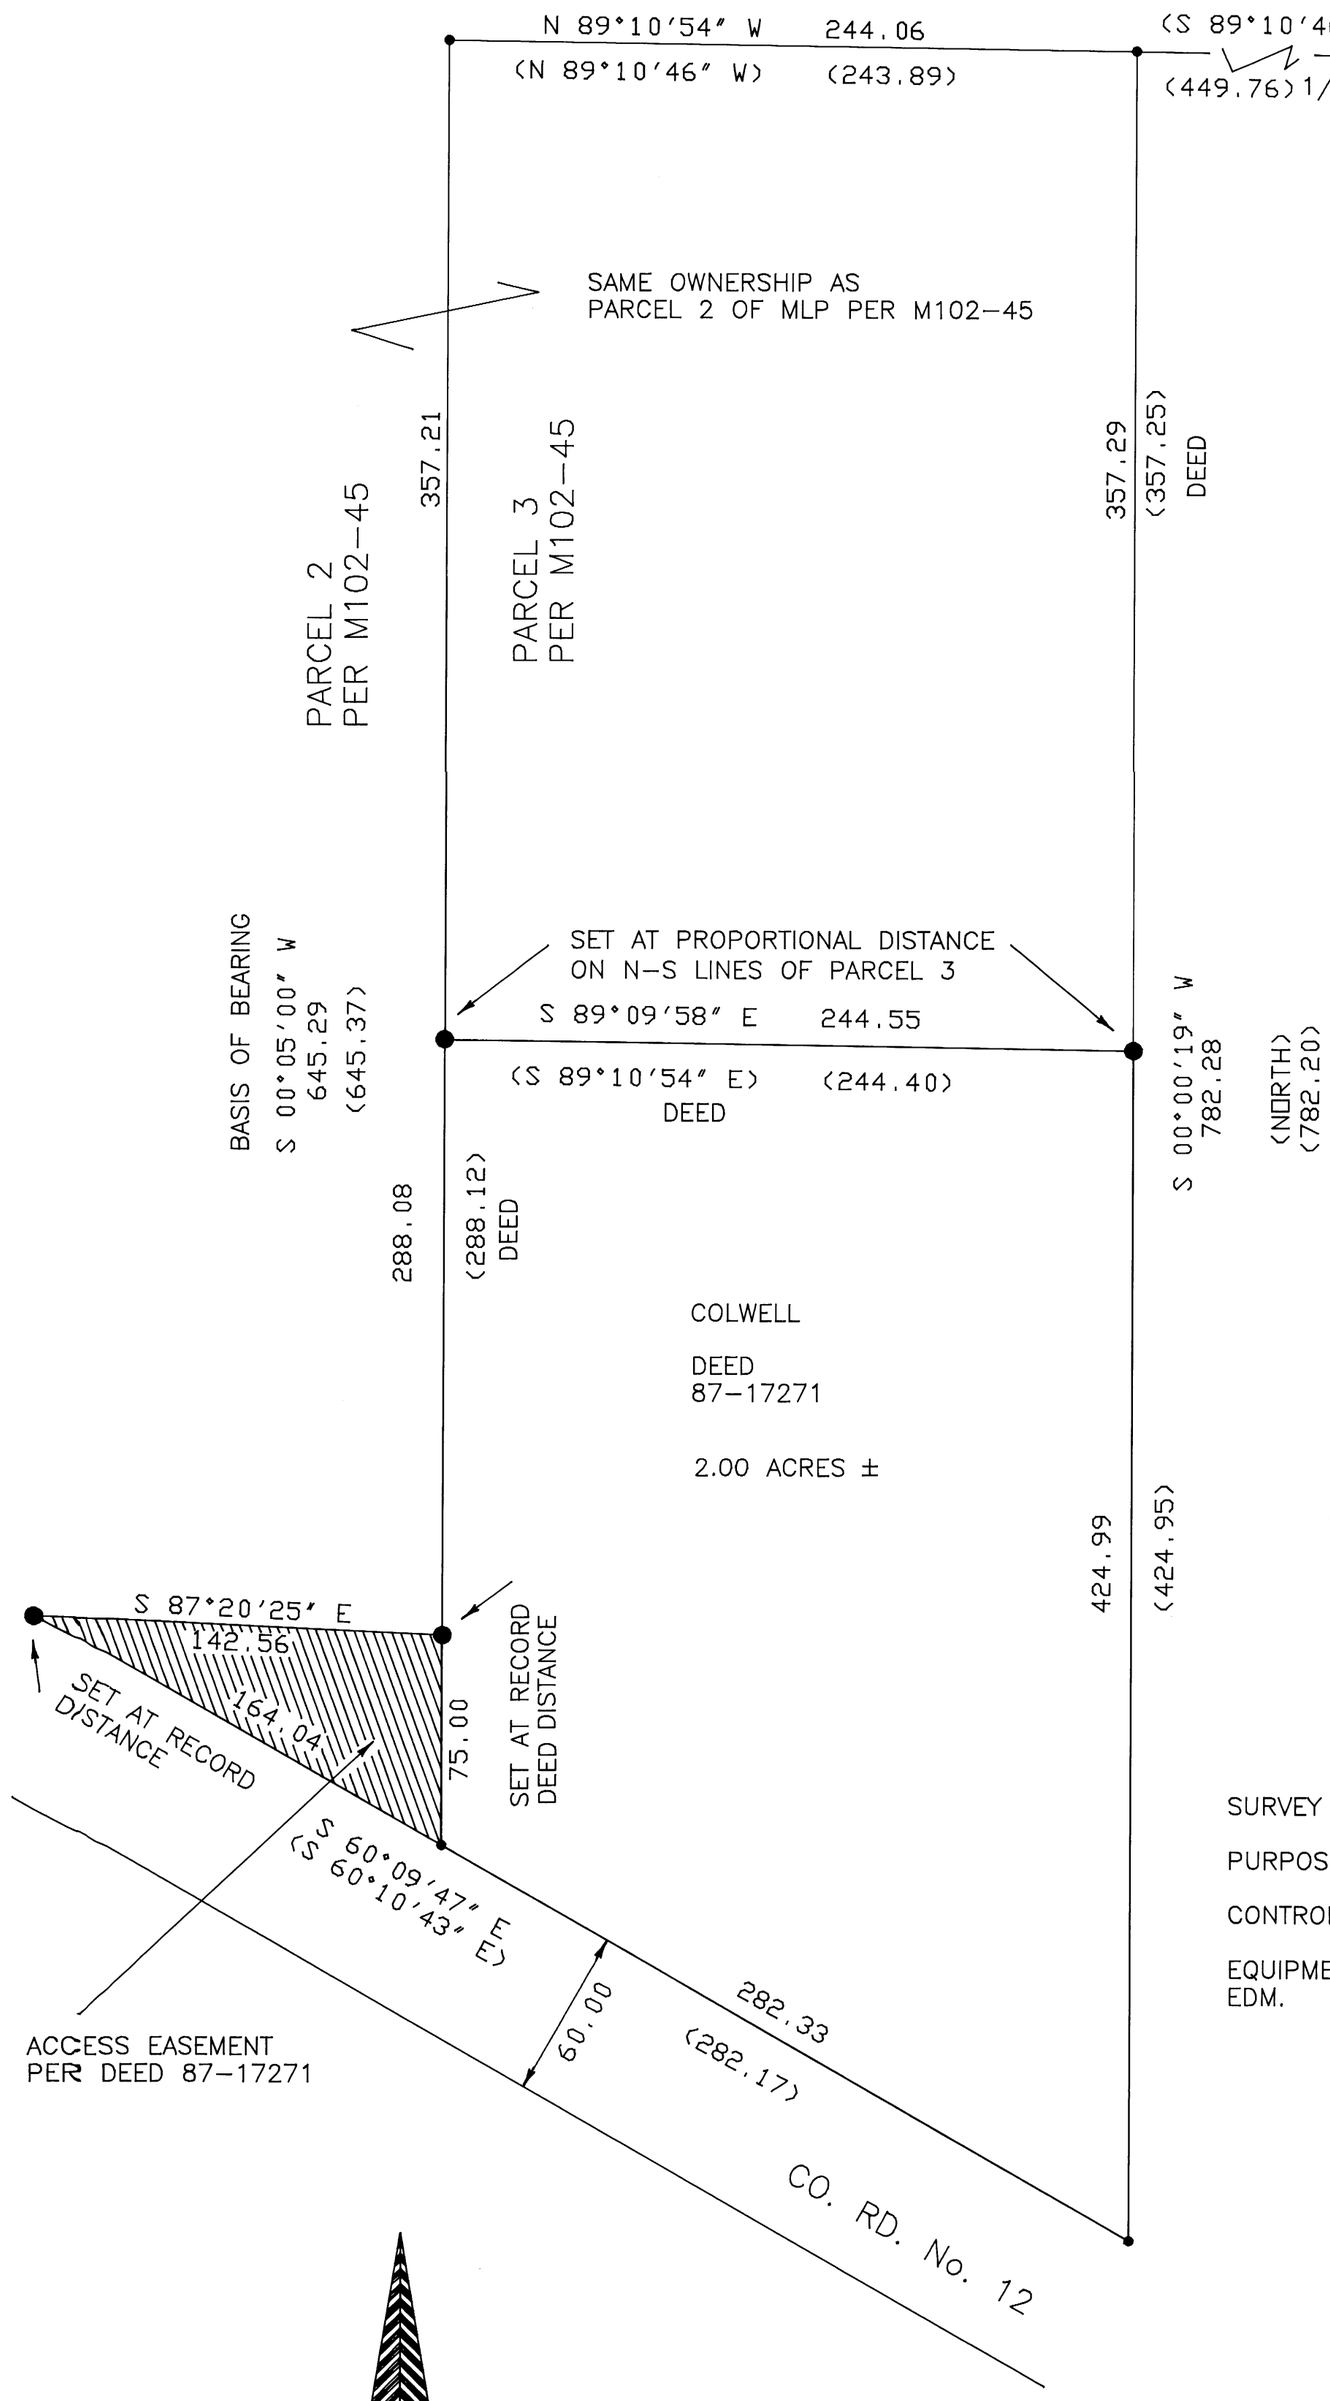

SURVEY TO SET PROPERTY CORNERS IN SE 1/4 SECTION 20 T 32 S, R 5 W, WM

for Pat & Sheri Colwell

LEGEND

- • FOUND 5/8" IRON ROD WITH 1.5" CAP MARKED LS 866
- ⊙ FOUND 1/2" IRON PIPE
- ● SET 5/8"X30" IRON ROD WITH 3/4" BRASS WASHER MARKED LS 866
- ( ) RECORD DEED # 87-17271

SURVEY NARRATIVE:

PURPOSE: TO SET PROPERTY CORNERS PER DEED 87-17271.

CONTROL: SURVEY BASED ON M102-45.

EQUIPMENT: LIETZ T60D THEODOLITE, 100 FT. STEEL TAPE, MAC II EDM.

REGISTERED OREGON LAND SURVEYOR
JULY 12, 1968
WILLIAM J. RUPPERT
866
MY REGISTRATION EXPIRES 12/31/1994

BY:
WILLIAM J. RUPPERT
P.O. BOX 1564
MYRTLE CREEK, OR 97457

NOVEMBER 1994

COUNTY SURVEYORS FILE DATA
DO NOT REMOVE FROM OFFICE

MAP FILE M121-5