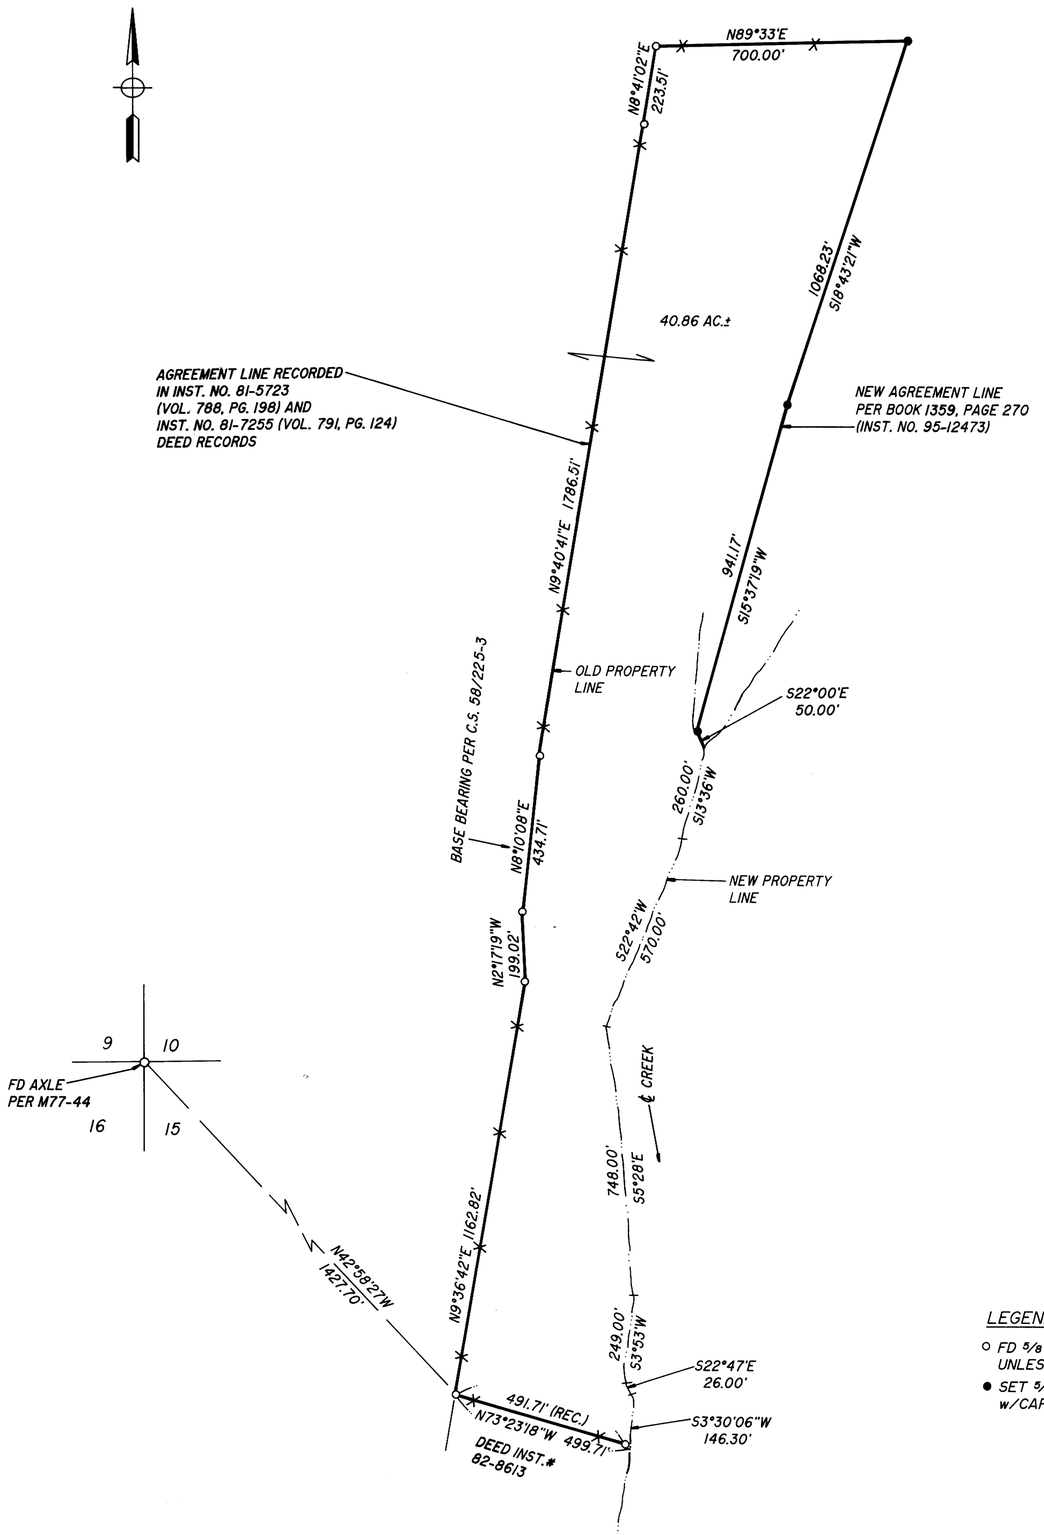

LEGEND:

- ○ FD 5/8" I.R. UNLESS OTHERWISE NOTED
- ● SET 5/8" x 30" I.R. w/CAP MKD "i.e. ENG."

COUNTY SURVEYORS FILE DATA
DO NOT REMOVE FROM OFFICE

FILED
Date: 9-26-95 By: MP
This survey consists of:
Map: M122-51
Narrative:
Corner Rpt:
DOUGLAS COUNTY SURVEYOR

MAP FILE M122-51

NARRATIVE:

SURVEY TO TRANSFER A PORTION OF THAT PROPERTY DESCRIBED IN INST. NO. 69-13468 (VOL. 437, PG. 817) DEED RECORDS OF DOUGLAS COUNTY, OREGON TO THE ADJACENT PARCELS LYING TO THE WEST. THE NORTHEAST MONUMENTS SET IN THE FENCELINE CONTROLS THE EAST LINE ALIGNMENT ONLY AND SHOULD NOT BE USED TO DETERMINE THE NORTH LINE OF THE 40.86 AC. PARCEL. QUITCLAIM DEEDS SHOULD BE EXERCISED ON THE NORTH FENCE LINE OR THE DEEDED LINE SURVEYED IF IT SHOULD EVER BE NEEDED.
FOR RECORD SURVEY SEE M83-8, C.S. 58/225-3.

FIELD CREW: NEIL HIBBS & DAN SHEPHERD
OFFICE COMPUTATIONS: ROMEY WARE
DRAFTING: TIM ADAMS

APPROVAL:

Keith L. Cubic 9/26/95
DOUGLAS COUNTY PLANNING DIRECTOR — DATE

PLANNING DEPT. FILE NO: BLA 95-142

REGISTERED OREGON LAND SURVEYOR
JULY 12, 1968
DONALD A. BENTZ
839
EXPIRES 12-31-95

PROPERTY LINE ADJUSTMENT

IN THE SW1/4 OF SEC. 10 AND THE NW1/4 OF SEC. 15,
T27S, R5W, W.M.,
DOUGLAS COUNTY, OREGON

SURVEYED FOR:
BOB CARRICO
408 TEMPLE BROWN RD.
ROSEBURG, OREGON 97470

SURVEYED BY:
i.e. ENGINEERING
548 S.E. Jackson Suite 3
Roseburg, Oregon 97470
PHONE (503) 673-0166
FAX (503) 440-9392

SCALE: 1" = 300' | DATE: MAY 1995 | 753-04 | PAGE: 1 OF 1

MAP FILE M122-51