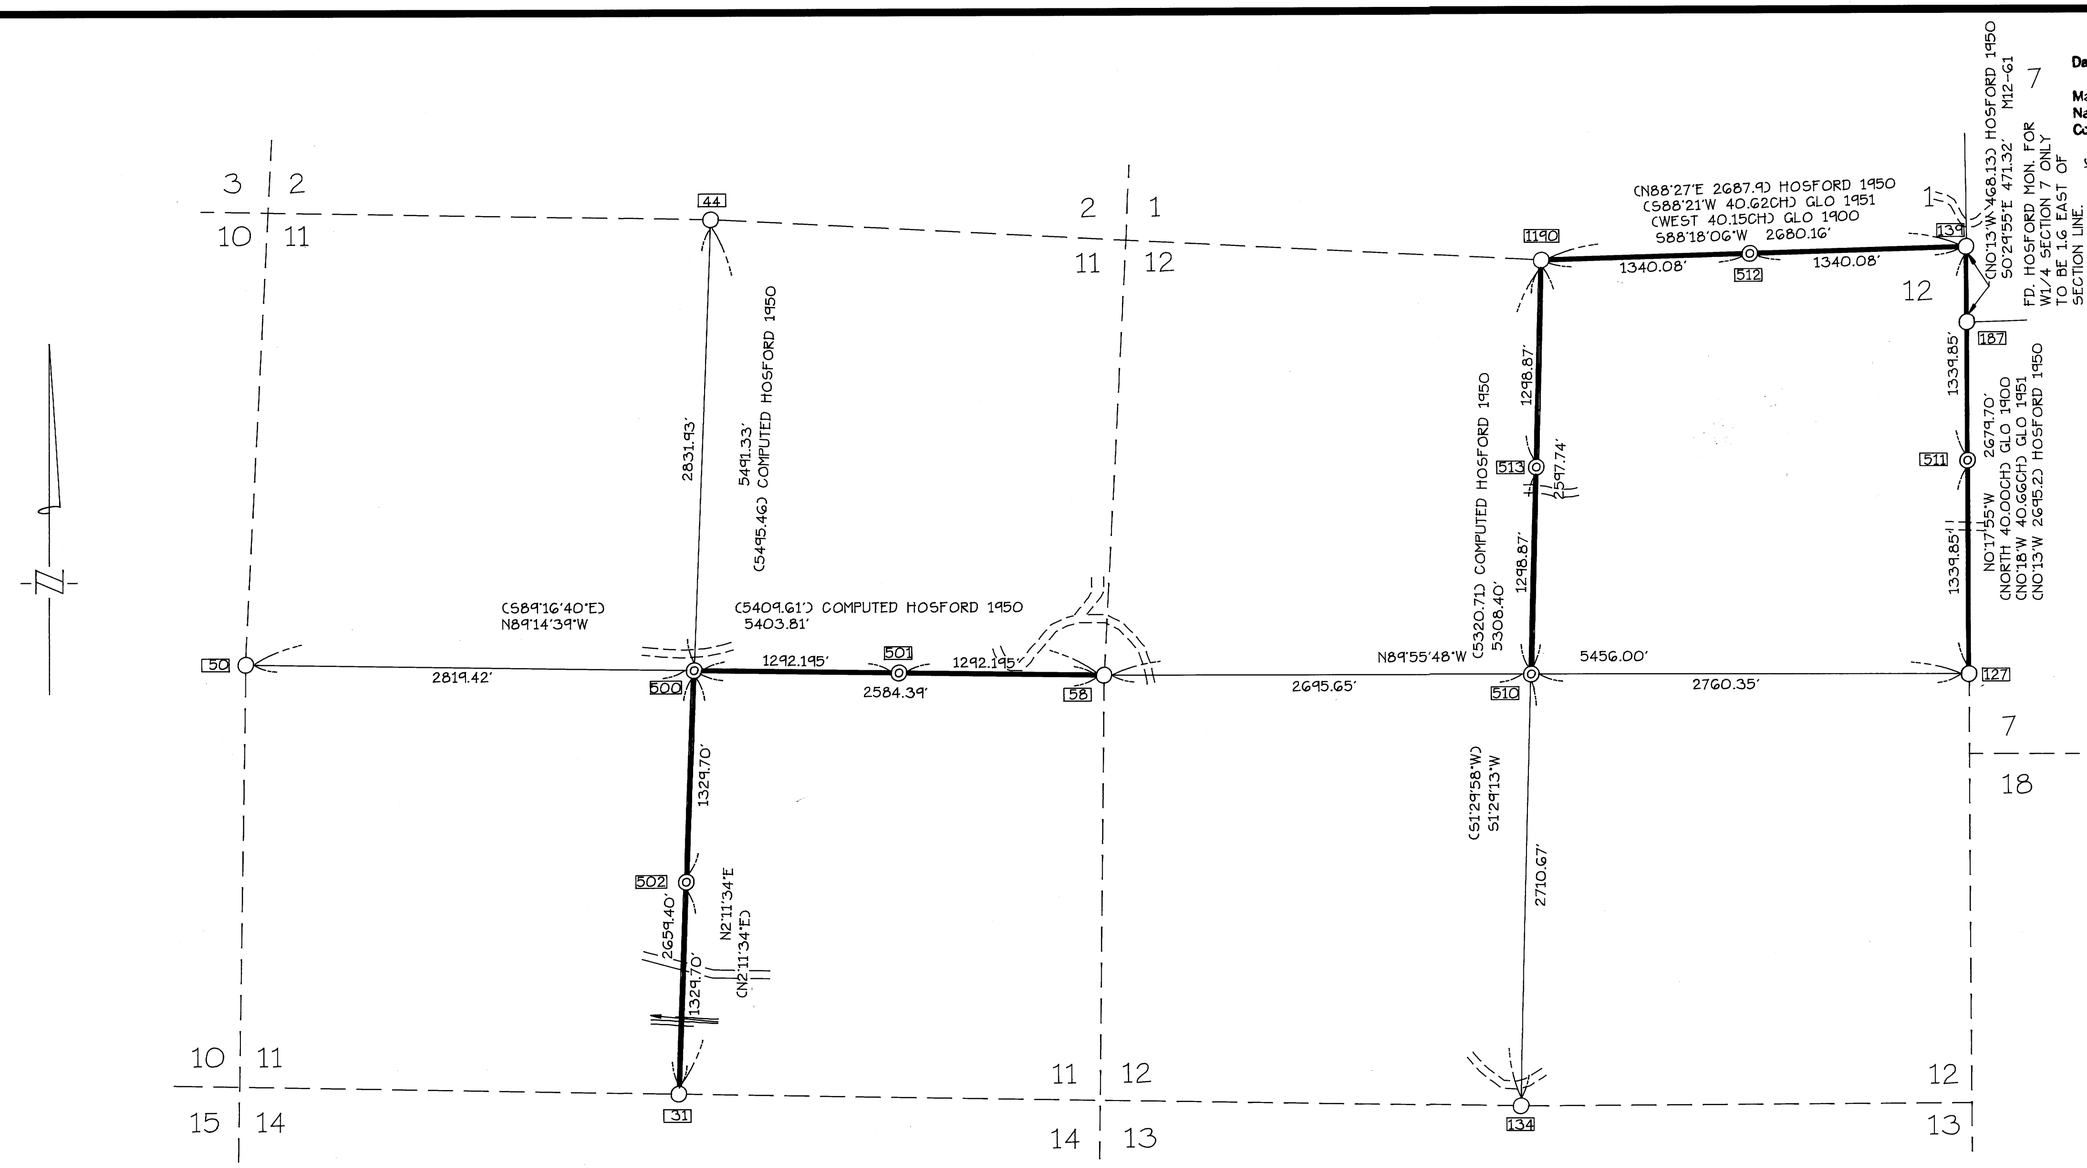

FILED
Date: 12/11/95 By: BC
This survey consists of:
Map: M123-3A
Narrative:
Corner Rpt:
DOUGLAS COUNTY SURVEYOR

MAP FILE M123-3A

REGISTERED PROFESSIONAL LAND SURVEYOR
OREGON
JULY 14, 1972
STEVEN P. NESS
811
RENEWAL DATE: DEC. 31, 1996

SURVEY FOR
WEYERHAEUSER COMPANY
IN
SE 1/4, SECTION 11 AND NE 1/4 SECTION 12 T25S. R2W. W.M.
DOUGLAS COUNTY, OREGON
MAP 25 02 TL 2700 AND TL 2900
OCTOBER 20, 1995
SCALE: 1"=600'

FORD-NESS-FASSBENDER
LAND SURVEYING
CONSTRUCTION SUPERVISION * WATER RIGHTS EXAMINATIONS
P.O.Box 22735
EUGENE, OR. 97402
1120 Bailey Hill Rd., No. 1
Eugene, OR 97402
(541) 344-1852
Fax (541) 344-9923

DWG.NO. RC 3032

NARRATIVE:

THIS SURVEY WAS PERFORMED AT THE REQUEST OF THE WEYERHAEUSER COMPANY TO MARK AND MONUMENT SOME OF THE BOUNDARY LINES OF THEIR OWNERSHIP IN SECTIONS 11 AND 12. THE CONTROLLING CORNERS NECESSARY TO SUBDIVIDE THESE SECTIONS WERE FOUND AND TIED IN A CLOSED TRAVERSE SCHEME. THE "1973 MANUAL OF SURVEY INSTRUCTIONS" WAS USED AS A REFERENCE TO PROPERLY SUBDIVIDE SECTIONS 11 AND 12.

THE BASIS OF BEARING FOR THIS SURVEY IS THE NORTH-SOUTH CENTERLINE OF SECTION 11 COMPUTED FROM DATA ON CSF #M G-45 BY V. W. HOSFORD AS BEING S2°11'34"W.

LEGEND:

MONUMENT FOUND, AS DESCRIBED .....
MONUMENT SET, AS DESCRIBED.....
LINES MARKED WITH ORANGE PAINTED BLAZES AND ORANGE FLAGGING.....
RECORD DATA.....
PAVED ROAD.....
GRAVEL ROAD.....
CORNER NUMBER.....
GLO..... GOVERNMENT LAND OFFICE
BLM..... BUREAU OF LAND MANAGEMENT
CSF..... COUNTY SURVEY FILE
EAST FORK ROCK CREEK.....

REFERENCES:

1. CSF #M G-45
2. CSF #M 12-G1
3. CSF #M G2-74
4. CSF #M 114-57

MAP FILE M123-3A