COUNTY SURVEYORS FILE DATA
DO NOT REMOVE FROM OFFICE

BOUNDARY LINE ADJUSTMENT

IN THE NW 1/4, SECTION 28 AND THE NE 1/4, SECTION 29
TOWNSHIP 26 SOUTH, RANGE 6 WEST, WILLAMETTE MERIDIAN
FOR WYLE & JUDY WOOD MARCH, 1996

FILED
Date: 4/15/96 By: AC
This survey consists of:
Map: M123-50
Narrative:
Corner Rpt:
DOUGLAS COUNTY SURVEYOR

MAP FILE M123-50

LEGEND:

- ● Found 5/8" Iron Rod or as noted.
- ▲ Calculated Point
- ⊙ Set 5/8" x 30" Iron Rod with Yellow Plastic Cap marked "AA SURVEYING INC."

RECORD INFORMATION:

- ( ) M43-36
- { } Partition Plat 1990-0009

NARRATIVE

The purpose of this survey was to monument the adjusted boundary of the property described as Parcel 1 in Deed Reference Number 93-15175 and Parcel 2 of Partition Plat Number 1990-0009 of the Deed Records of Douglas County.

The monuments shown were used to contol the boundary and the common boundary was adjusted per tentitive plan as recorded in Douglas County Planning Department File Number 94-324.

APPROVAL

Approved: April 15, 1996.

By: Dave Kanamond, For Keith L. Cutler
Douglas County Planning Director

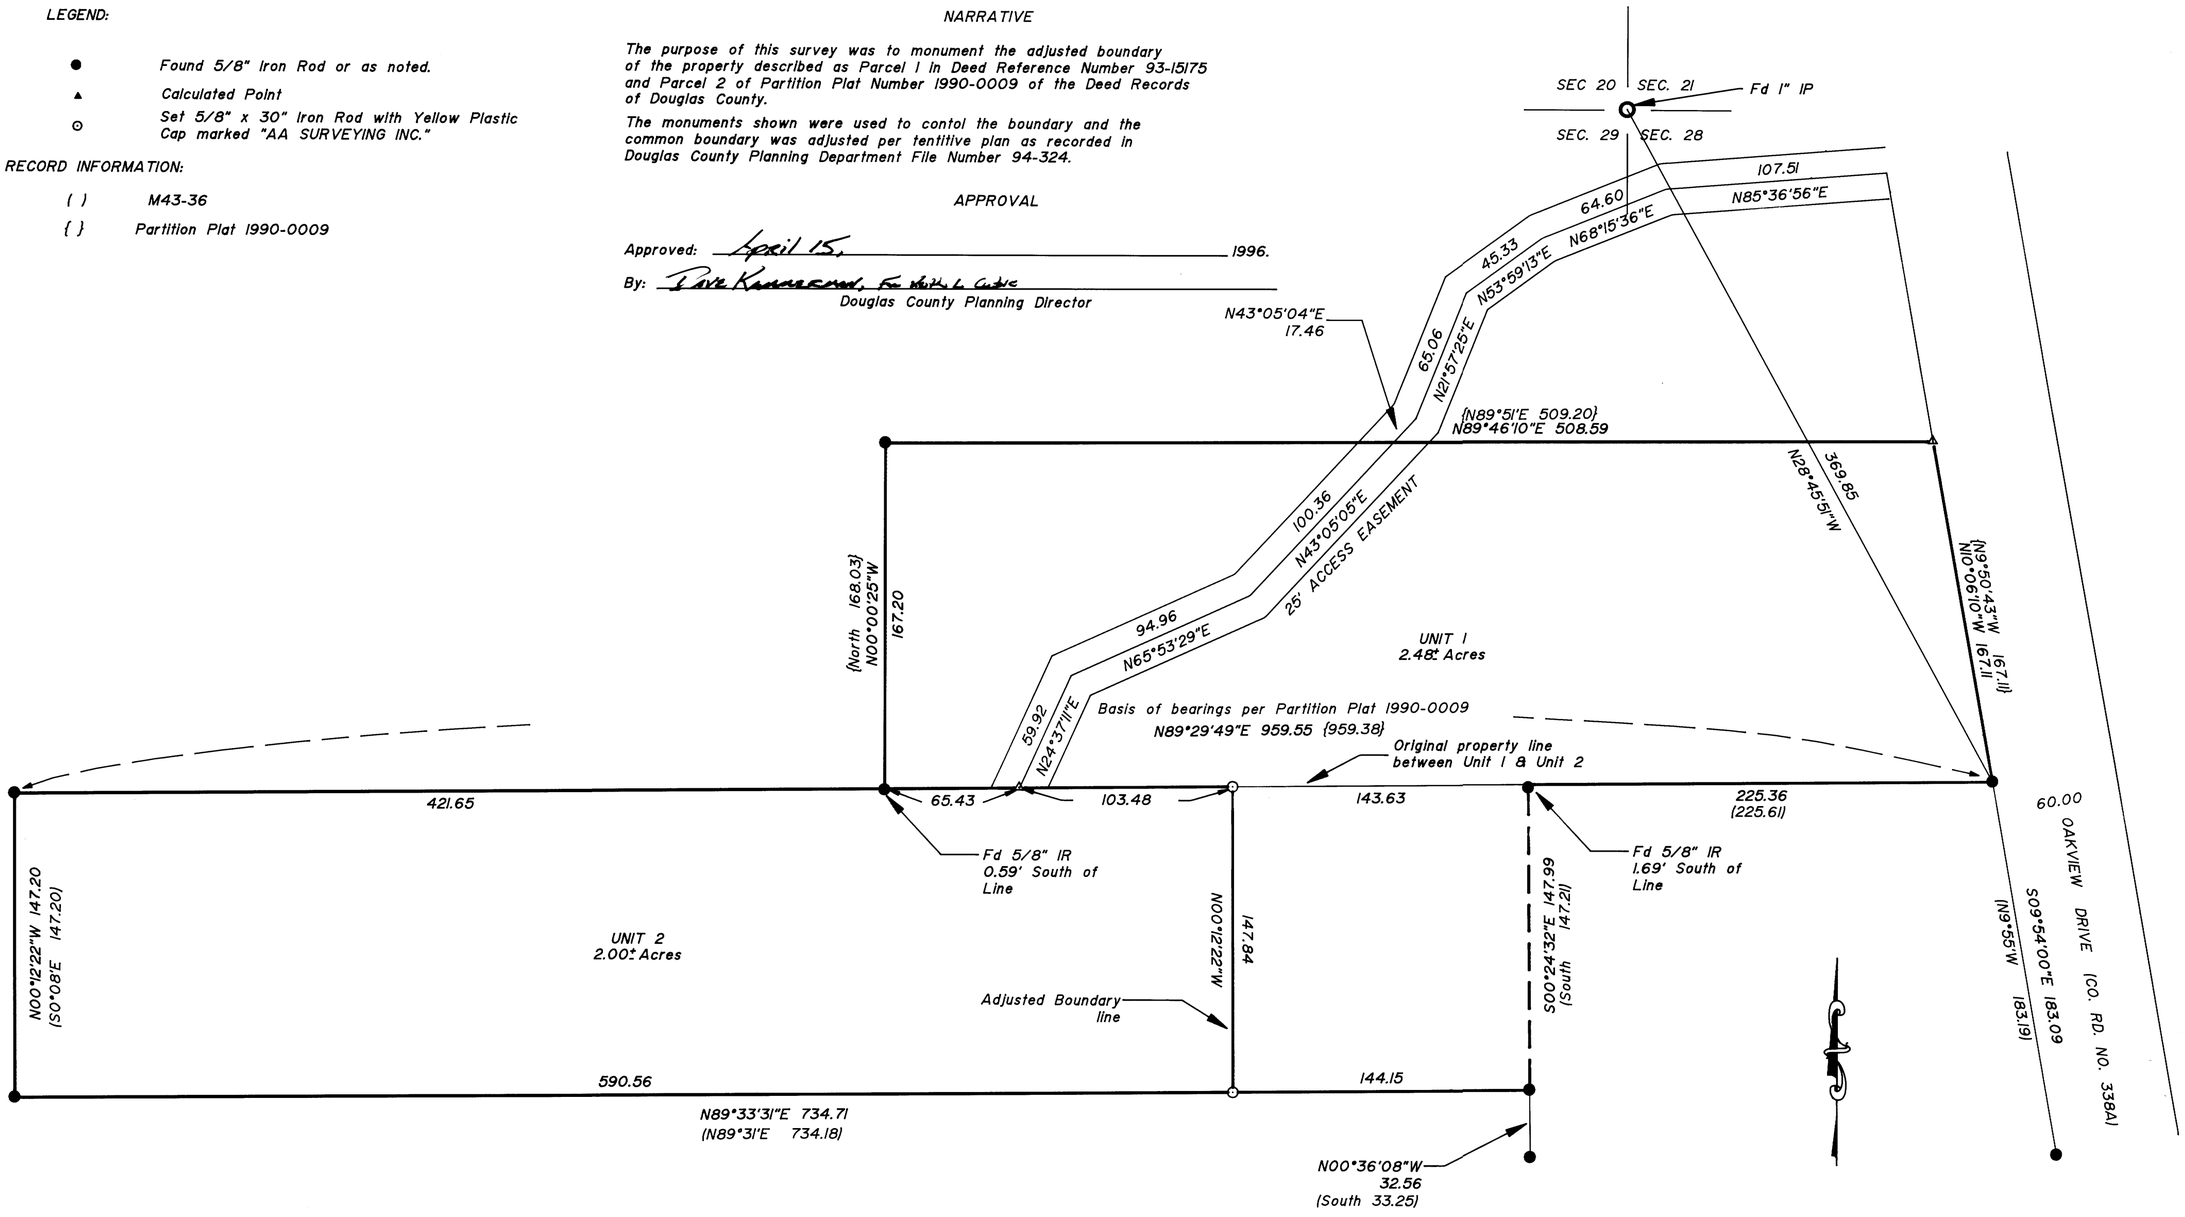

REGISTERED
PROFESSIONAL LAND SURVEYOR
OREGON
JULY 14, 1978
RONALD A. QUIMBY
1654
EXP 12/31/97

AA SURVEYING SERVICE, INC.
3076 EAST DIAMOND LAKE BLVD.
ROSEBURG, OREGON 97470
TEL (503)672-2096
FAX (503)672-0611

MAP FILE M123-50