FILED
Date: 5/28/96 By: BC
This survey consists of:
Map: M123-78
Narrative:
Corner Rpt:
DOUGLAS COUNTY SURVEYOR

MAP FILE M123-78

COUNTY SURVEYORS FILE DATA
DO NOT REMOVE FROM OFFICE

NARRATIVE:

SURVEY TO MONUMENT AND DESCRIBE A PORTION OF PROPERTY DESCRIBED IN INSTRUMENT NO. 318110 AS RECORDED IN THE DEED RECORDS OF DOUGLAS COUNTY, OREGON, AS REQUESTED BY THE OREGON DEPARTMENT OF TRANSPORTATION. THE EAST LINE OF SUBJECT SURVEY WAS ESTABLISHED BY LOCATING MONUMENTS PER SURVEY M 9-66 (DOUGLAS COUNTY SURVEYOR'S OFFICE) AND EXTENDING NORTHERLY TO A FENCE CORNER. THENCE BEARING WEST THEREFROM AND INTERSECTING THE WEST LINE OF SECTION 17 TO ESTABLISH THE NORTH LINE. OTHER SURVEY OF RECORD IS RICE HILL ESTATES - PHASE 4 AS RECORDED IN VOLUME 15, PAGE 23. BASIS OF BEARING PER GPS OBSERVATIONS.

FIELD CREW: DAVE WILLIAMS & ROD McCALLISTER
EQUIPMENT: NIKON TOTAL STATION AND 4000ST GPS RECEIVERS
OFFICE: ROMEY WARE
DRAFTING: TIM ADAMS

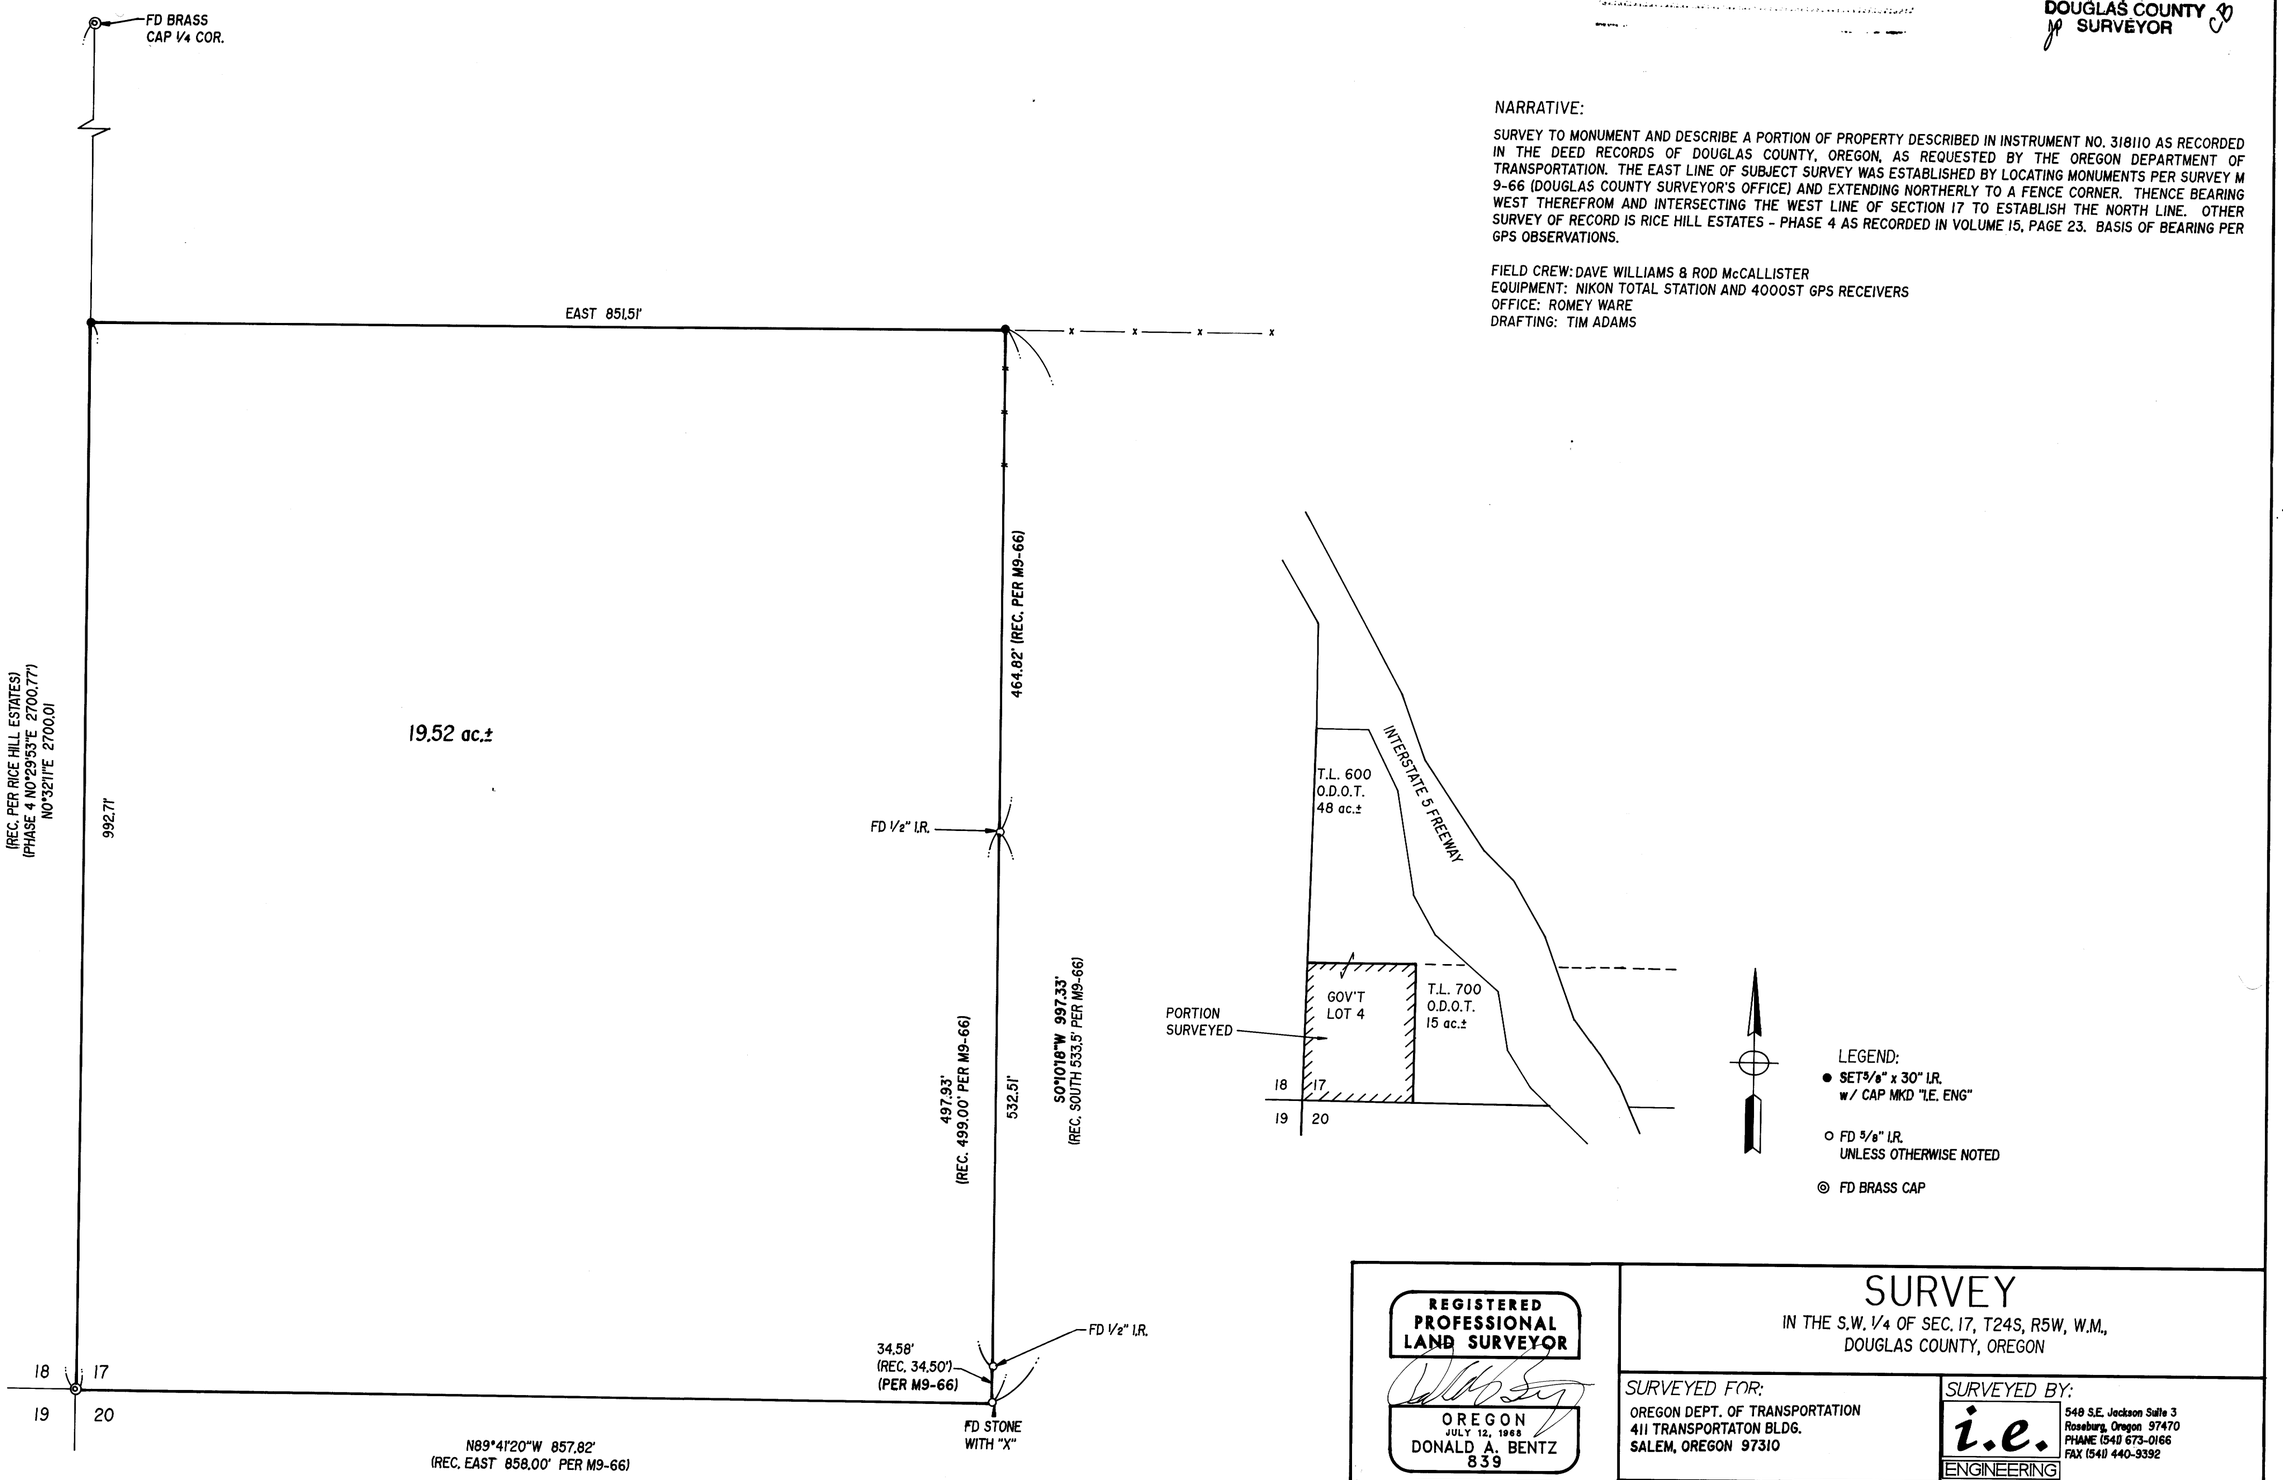

REGISTERED PROFESSIONAL LAND SURVEYOR
OREGON
JULY 12, 1968
DONALD A. BENTZ
839
EXPIRES 12-31-97

SURVEY

IN THE S.W. 1/4 OF SEC. 17, T24S, R5W, W.M.,
DOUGLAS COUNTY, OREGON

SURVEYED FOR:
OREGON DEPT. OF TRANSPORTATION
411 TRANSPORTATON BLDG.
SALEM, OREGON 97310

SURVEYED BY:
i.e. ENGINEERING
549 S.E. Jackson Suite 3
Roseburg, Oregon 97470
PHONE (541) 673-0166
FAX (541) 440-9392

SCALE: 1" = 100' | DATE: MAR. 6, 1996 | 1245-01 | PAGE: 1 OF 1

MAP FILE M123-78