MAP FILE M124-5

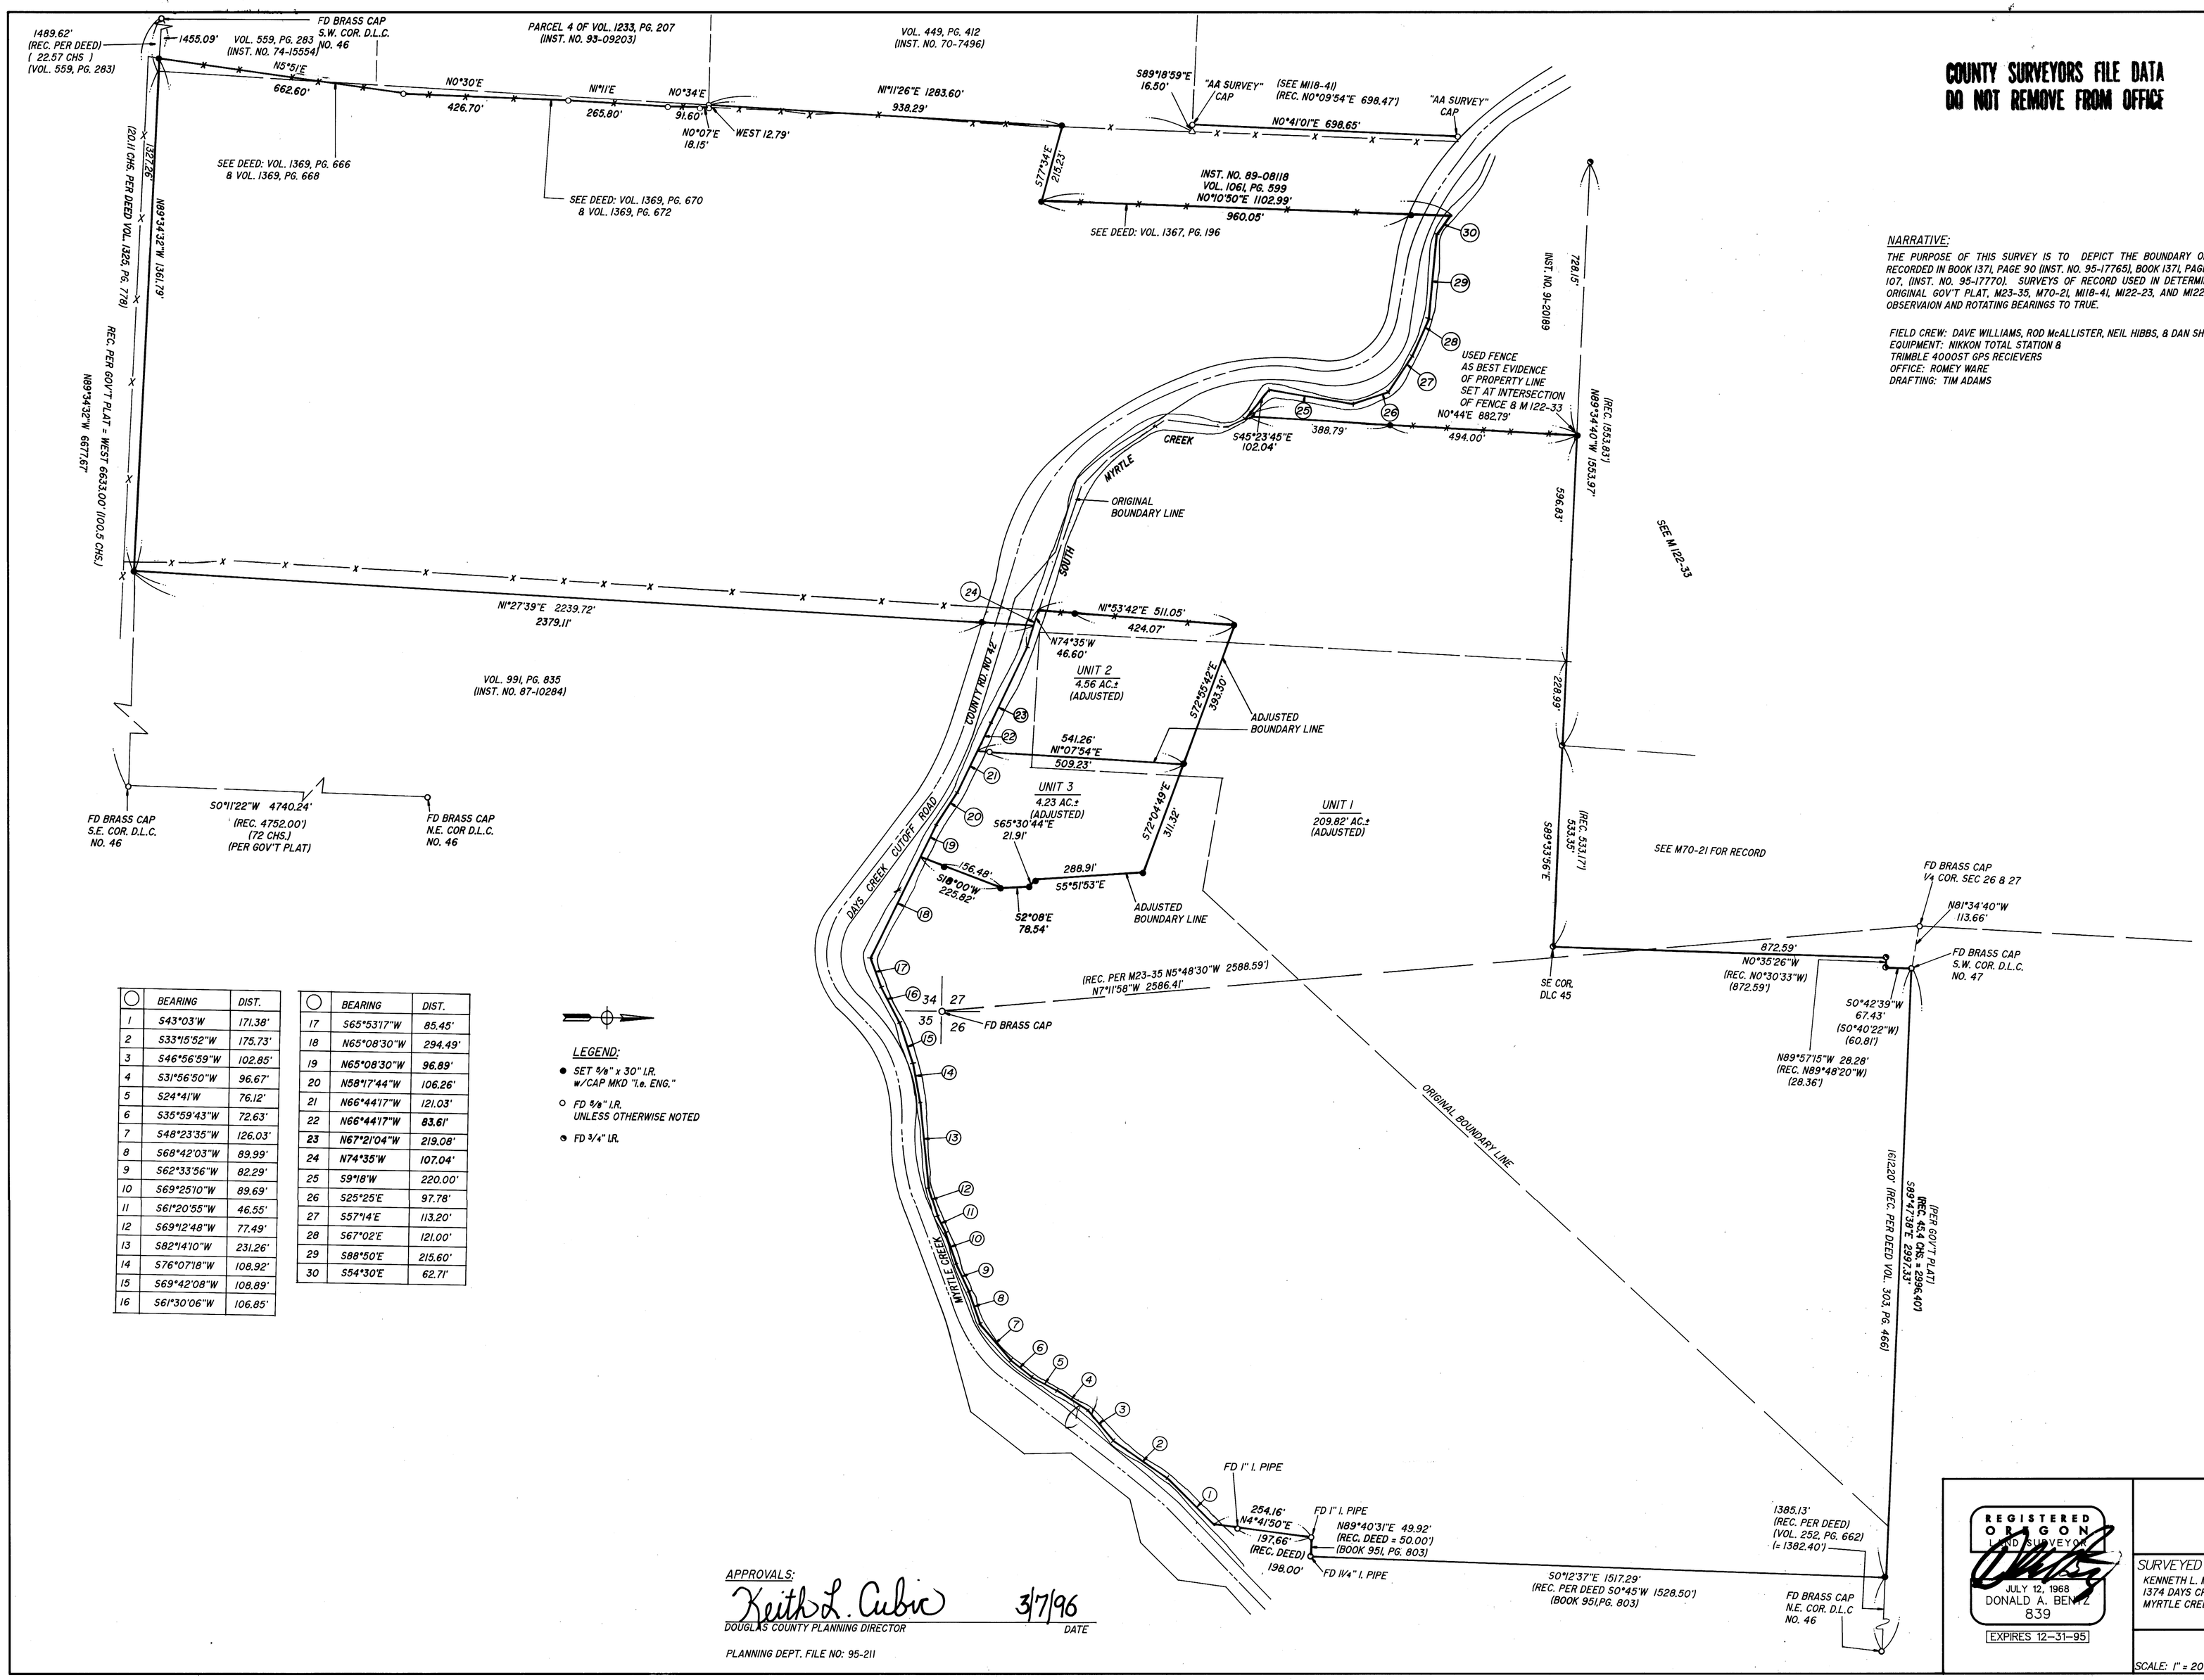


| | BEARING | DIST. |
|---|---|---|
| 1 | S43°03'W | 171.38' |
| 2 | S33°15'52"W | 175.73' |
| 3 | S46°56'59"W | 102.85' |
| 4 | S31°56'50"W | 96.67' |
| 5 | S24°41'W | 76.12' |
| 6 | S35°59'43"W | 72.63' |
| 7 | S48°23'35"W | 126.03' |
| 8 | S68°42'03"W | 89.99' |
| 9 | S62°33'56"W | 82.29' |
| 10 | S69°25'10"W | 89.69' |
| 11 | S61°20'55"W | 46.55' |
| 12 | S69°12'48"W | 77.49' |
| 13 | S82°14'10"W | 231.26' |
| 14 | S76°07'18"W | 108.92' |
| 15 | S69°42'08"W | 108.89' |
| 16 | S61°30'06"W | 106.85' |

| | BEARING | DIST. |
|---|---|---|
| 17 | S65°53'17"W | 85.45' |
| 18 | N65°08'30"W | 294.49' |
| 19 | N65°08'30"W | 96.89' |
| 20 | N58°17'44"W | 106.26' |
| 21 | N66°44'17"W | 121.03' |
| 22 | N66°44'17"W | 83.61' |
| 23 | N67°21'04"W | 219.08' |
| 24 | N74°35'W | 107.04' |
| 25 | S9°18'W | 220.00' |
| 26 | S25°25'E | 97.78' |
| 27 | S57°14'E | 113.20' |
| 28 | S67°02'E | 121.00' |
| 29 | S88°50'E | 215.60' |
| 30 | S54°30'E | 62.71' |

LEGEND:

- ● SET 5/8" x 30" I.R. w/CAP MKD "i.e. ENG."
- ○ FD 5/8" I.R. UNLESS OTHERWISE NOTED
- ◔ FD 3/4" I.R.

APPROVALS:

Keith L. Cubic 3/7/96

DOUGLAS COUNTY PLANNING DIRECTOR — DATE

PLANNING DEPT. FILE NO: 95-211

**COUNTY SURVEYORS FILE DATA**
**DO NOT REMOVE FROM OFFICE**

FILED
Date: 3-7-96 By: AP
This survey consists of:
Map: M 124-5
Narrative:
Corner Rpt:
DOUGLAS COUNTY SURVEYOR

NARRATIVE:

THE PURPOSE OF THIS SURVEY IS TO DEPICT THE BOUNDARY OF THOSE PROPERTIES ADJUSTED PER DEEDS RECORDED IN BOOK 1371, PAGE 90 (INST. NO. 95-17765), BOOK 1371, PAGE 93, (INST. NO. 95-17766) AND BOOK 1371, PAGE 107, (INST. NO. 95-17770). SURVEYS OF RECORD USED IN DETERMINING SUBJECT SURVEY PERIMETERS ARE THE ORIGINAL GOV'T PLAT, M23-35, M70-21, M118-41, M122-23, AND M122-34. BASIS OF BEARING WAS BASED ON GPS OBSERVAION AND ROTATING BEARINGS TO TRUE.

FIELD CREW: DAVE WILLIAMS, ROD McALLISTER, NEIL HIBBS, & DAN SHEPERD
EQUIPMENT: NIKKON TOTAL STATION & TRIMBLE 4000ST GPS RECIEVERS
OFFICE: ROMEY WARE
DRAFTING: TIM ADAMS

REGISTERED OREGON LAND SURVEYOR
JULY 12, 1968
DONALD A. BENTZ
839
EXPIRES 12-31-95

# BOUNDARY LINE ADJUSTMENT

IN SEC. 26, 27, 34, & 35 OF T29S, R5W, W.M., DOUGLAS COUNTY, OREGON

SURVEYED FOR:
KENNETH L. McFARLAND & BILL E. McFARLAND
1374 DAYS CREEK CUTOFF RD.
MYRTLE CREEK, OR 97457

SURVEYED BY:
i.e. ENGINEERING
548 S.E. Jackson Suite 3
Roseburg, Oregon 97470
PHONE (503) 673-0166
FAX (503) 440-9392

SCALE: 1" = 200' | DATE: JULY 1995 | 1113-05 | PAGE: 1 OF 1

MAP FILE M124-5