MAP FILE M127-22

FILED

Date: 1-17-97 By: JP

This survey consists of:

Map: M127-22

Narrative: _____

3 Corner Rpt: CS 65/15-5A-C

DOUGLAS COUNTY SURVEYOR JP CB

COUNTY SURVEYORS FILE DATA
DO NOT REMOVE FROM OFFICE

Basis of bearings is section line

Scale: 1" = 200 ft.

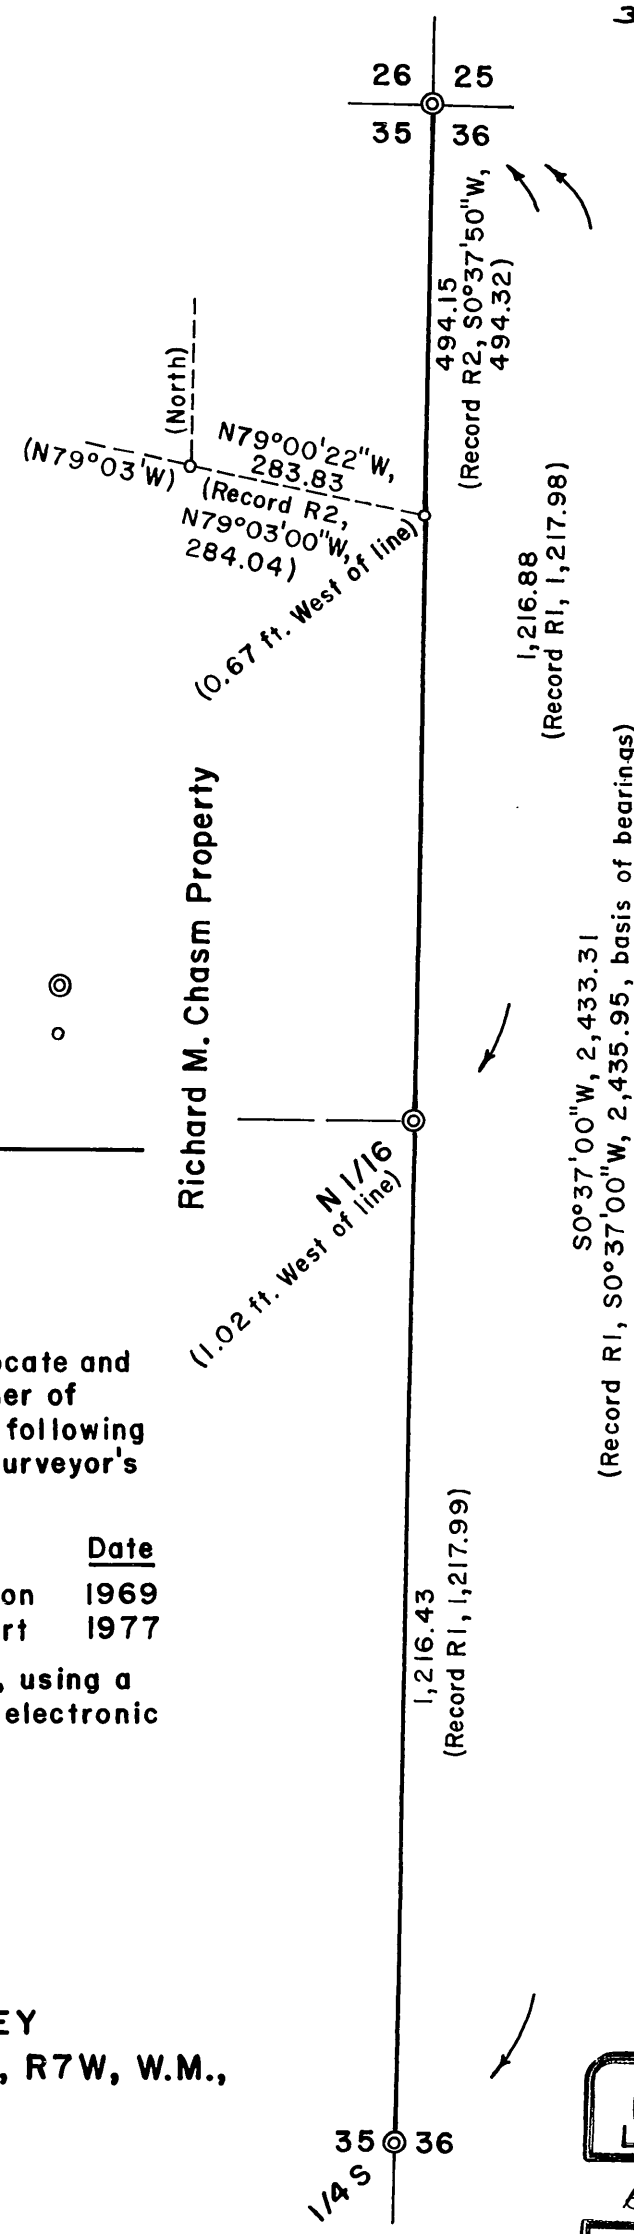

LEGEND

Corner found, brass cap ◎

Corner found, 3/4" iron rod o

Property line marked with blazes, orange paint and 6 ft. steel fence posts ——

NARRATIVE

The purpose of the survey was to locate and mark the property line from the NE corner of Section 35 to the east 1/4 corner. The following surveys, on file at the Douglas County Surveyor's Office, were referred to:

Ref. No. (R)	Map File No.	Surveyor	Date
1	M33-57	James W. Byron	1969
2	M63-76	Wm. J. Ruppert	1977

The survey was done in July, 1997, using a Jena 0°00'01" theodolite and a Mac II electronic distance meter.

PROPERTY LINE SURVEY
in the NE 1/4 of Section 35, T28S, R7W, W.M.,
Douglas County, Oregon

For: Richard M. Chasm
P.O. Box 51
Dillard, Oregon 97432

By: Shaner Engineering, Inc.
P.O. Box 1430
Roseburg, Oregon 97470

July 16, 1997

REGISTERED PROFESSIONAL LAND SURVEYOR

Bruce A Shaner

OREGON
OCT. 4, 1957
BRUCE A. SHANER
430

Renews June 30, 1998

MAP FILE M 127-22