COUNTY SURVEYORS FILE DATA
DO NOT REMOVE FROM OFFICE

FILED
Date: 9-11-97 By: JP
This survey consists of:
Map: M127-47
Narrative:
Corner Rpt:
DOUGLAS COUNTY SURVEYOR

MAP FILE M127-47

SURVEY LOCATED IN PORTIONS OF THE SW1/4,SW1/4, SECTION 18 AND THE NW1/4,NW1/4 SECTION 19, T22S, R12W AND PORTIONS OF THE NE1/4, NE1/4, SECTION 24 AND THE SE1/4,SE1/4, SECTION 13, T22S, R13W. W.M.
DOUGLAS COUNTY, OREGON

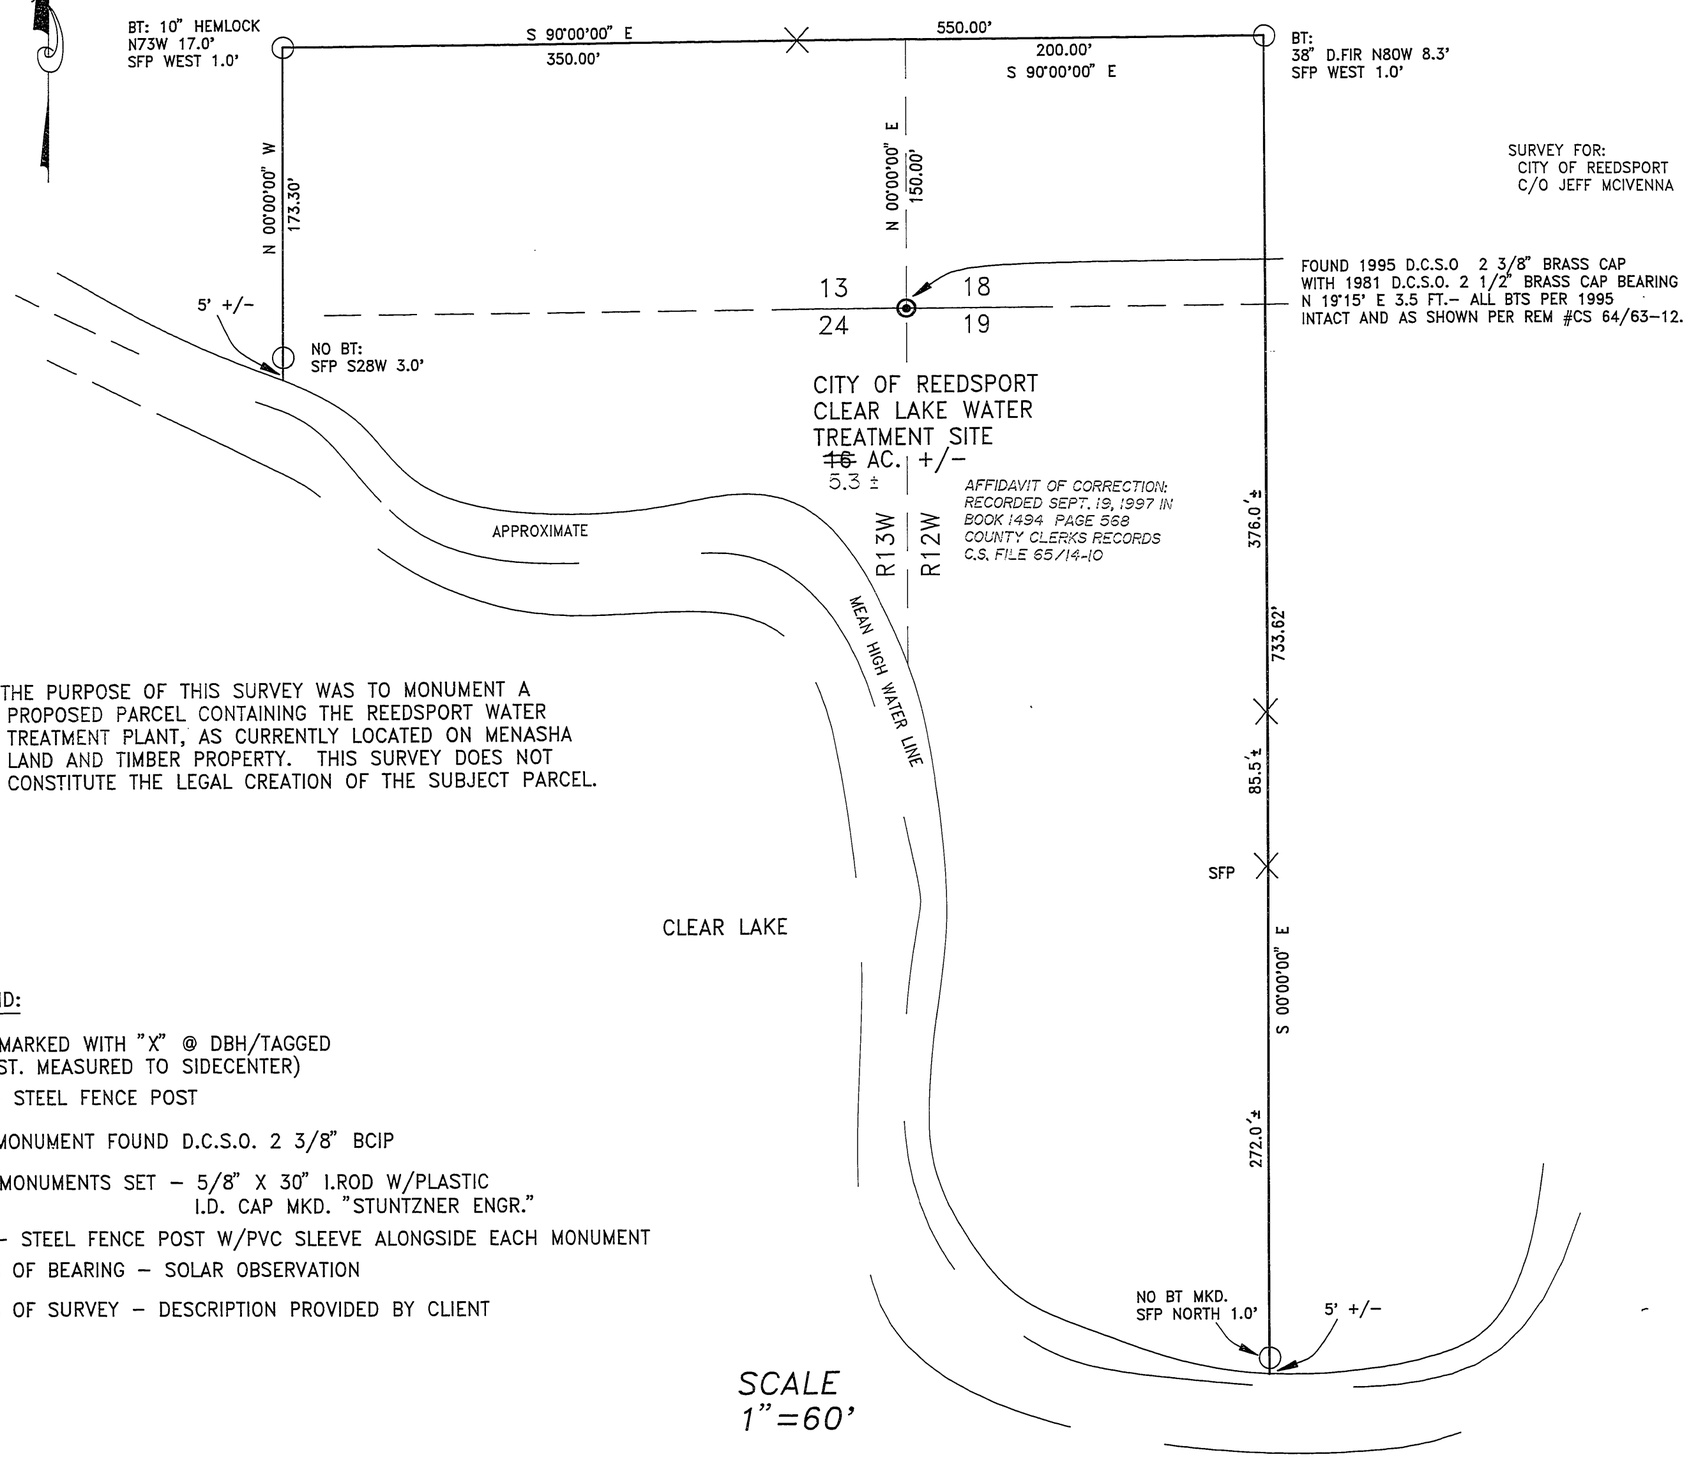

NARRATIVE: THE PURPOSE OF THIS SURVEY WAS TO MONUMENT A PROPOSED PARCEL CONTAINING THE REEDSPORT WATER TREATMENT PLANT, AS CURRENTLY LOCATED ON MENASHA LAND AND TIMBER PROPERTY. THIS SURVEY DOES NOT CONSTITUTE THE LEGAL CREATION OF THE SUBJECT PARCEL.

LEGEND:

BTS. MARKED WITH "X" @ DBH/TAGGED (DIST. MEASURED TO SIDECENTER)

X's – STEEL FENCE POST

⊙ – MONUMENT FOUND D.C.S.O. 2 3/8" BCIP

○ – MONUMENTS SET – 5/8" X 30" I.ROD W/PLASTIC I.D. CAP MKD. "STUNTZNER ENGR."

SFP – STEEL FENCE POST W/PVC SLEEVE ALONGSIDE EACH MONUMENT

BASIS OF BEARING – SOLAR OBSERVATION

BASIS OF SURVEY – DESCRIPTION PROVIDED BY CLIENT

SCALE
1"=60'

REGISTERED
PROFESSIONAL
LAND SURVEYOR
OREGON
July 25,1995
Thomas M. Hoshall
2727
EXPIRES 6/30/99

Stuntzner Engineering
& Forestry, L.L.C.
ENGINEERING * LAND SURVEYING * FORESTRY
PLANNING * WATER RIGHTS
705 South 4th St.
Post Office Box 118
Coos Bay, Oregon 97420
Phone: (541) 267-2872
Fax: (541) 267-0588

Drawn By:	JIM PEX	Date:	9-3-97
Checked By:	TOM HOSHALL	Drawing No.:	97-157
Designed By:	TOM HOSHALL	Revised:	
Job Name:	CLEAR LAKE SURVEY	Sheet 1 of 1	

MAP FILE M127-47