COUNTY SURVEYORS FILE DATA
DO NOT REMOVE FROM OFFICE

FILED
Date: 10/2/1997 By: JP
This survey consists of: 3 Sht.
Map: M 127-58 A
Narrative:
Corner Rpt:
DOUGLAS COUNTY
JP SURVEYOR

MAP FILE M 127-58A

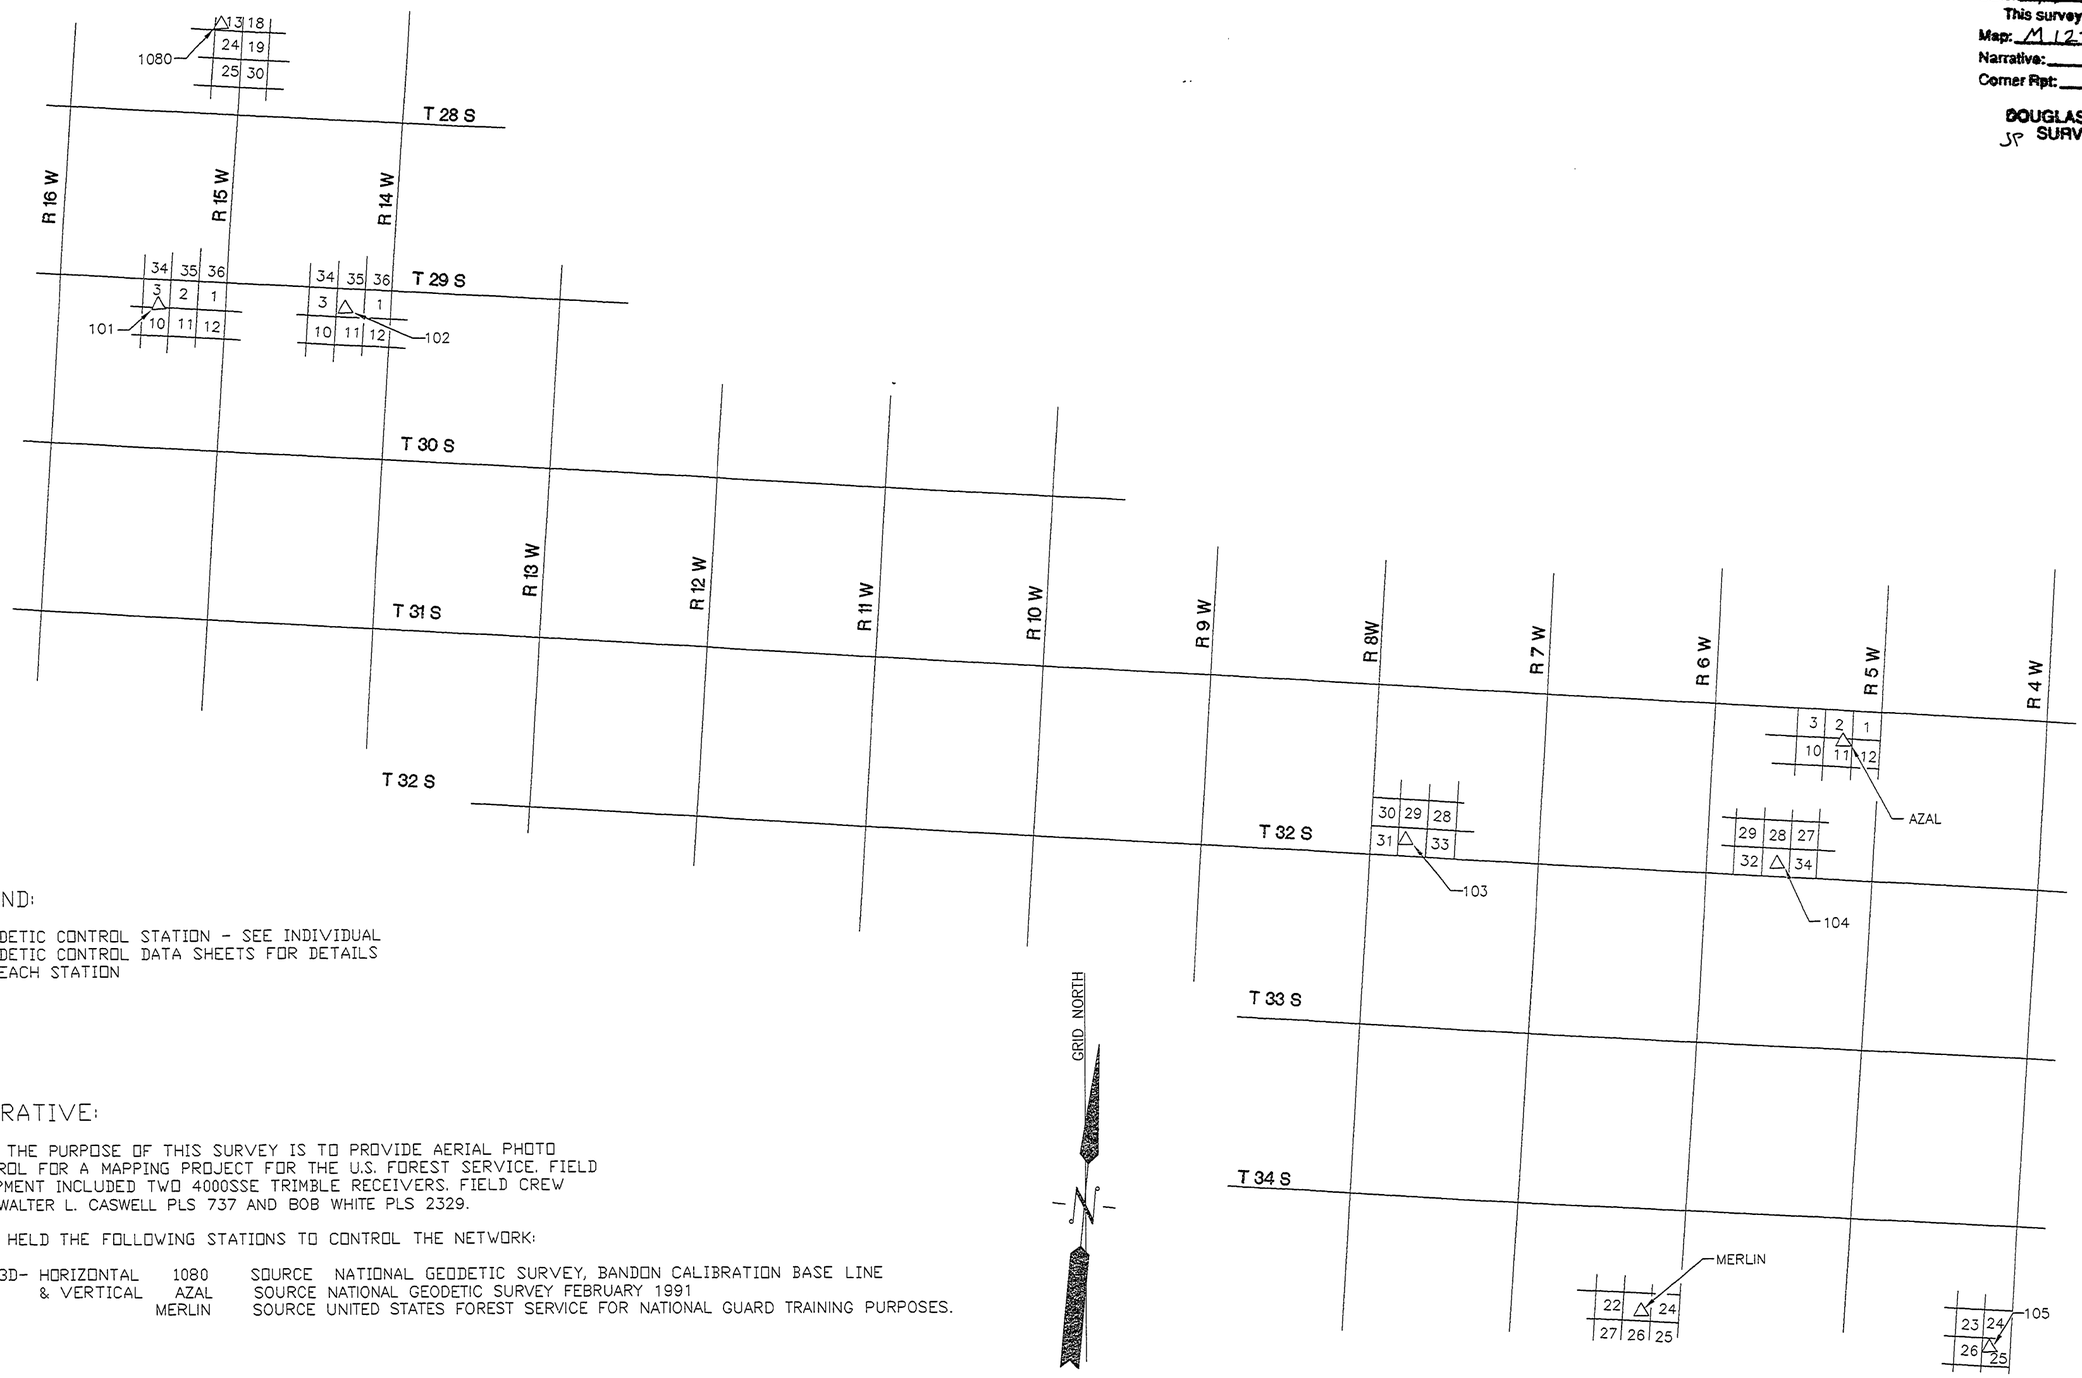

LEGEND:

△ GEODETIC CONTROL STATION - SEE INDIVIDUAL GEODETIC CONTROL DATA SHEETS FOR DETAILS ON EACH STATION

NARRATIVE:

THE PURPOSE OF THIS SURVEY IS TO PROVIDE AERIAL PHOTO CONTROL FOR A MAPPING PROJECT FOR THE U.S. FOREST SERVICE. FIELD EQUIPMENT INCLUDED TWO 4000SSE TRIMBLE RECEIVERS. FIELD CREW WAS WALTER L. CASWELL PLS 737 AND BOB WHITE PLS 2329.

HELD THE FOLLOWING STATIONS TO CONTROL THE NETWORK:

3D- HORIZONTAL & VERTICAL	1080	SOURCE	NATIONAL GEODETIC SURVEY, BANDON CALIBRATION BASE LINE
	AZAL	SOURCE	NATIONAL GEODETIC SURVEY FEBRUARY 1991
	MERLIN	SOURCE	UNITED STATES FOREST SERVICE FOR NATIONAL GUARD TRAINING PURPOSES.

SURVEYOR: W.L.C	PHOTO CONTROL SURVEY FOR U.S. FOREST SERVICE
DRAWN BY: B.W.	IN T. 35 S., R. 4 W.; T. 32 S. R. 5 W.; T. 32 S. R. 7 W.; T. 30 S., R. 14 W.; T. 30 S., R. 15 W.; T. 28 S., R. 15 W.; W.M.
DATE: AUGUST 23, 1997	COOS COUNTY
SCALE: 1" = 20,000'	DOUGLAS COUNTY
JOB NO. 97-019	JACKSON COUNTY
SHEET 1 OF 3 SHEETS	OREGON

EAGLE
GPS SURVEY CORPORATION
13545 N.W. SCIENCE PARK DRIVE
PORTLAND, OREGON 97229
(503) 643-1073

REGISTERED PROFESSIONAL LAND SURVEYOR
OREGON
JULY 8, 1966
WALTER L. CASWELL
737
EXPIRES 12/31/98

NO.	REVISION	DATE	BY

MAP FILE M 127-58A