COUNTY SURVEYORS FILE DATA
DO NOT REMOVE FROM OFFICE

MAP OF SURVEY

LOCATED in the SE 1/4 of Section 34, T. 20 S., R.6W.,W.M.
in Douglas County, Oregon.

September 18, 1998

FILED
Date: 9-22-1998 By: JP
This survey consists of:
Map: M130-31
Narrative:
Corner Rpt:
DOUGLAS COUNTY SURVEYOR

MAP FILE M130-31

SURVEYED FOR: *DICK HESS*
SHOESTRING VALLEY, OREGON

SURVEYED BY: *DAVID EDWARDS LAND SURVEYING*
P.O. BOX 361
OAKLAND, OREGON 97462
PHONE: (541) 459-0512

REGISTERED PROFESSIONAL LAND SURVEYOR
David A. Edwards
OREGON
JULY 26, 1985
DAVID A. EDWARDS
2339
EXPIRES 12/31/99

NARRATIVE

THE PURPOSE OF THIS SURVEY IS TO FLAG AND BLAZE A PORTION OF THE BOUNDARIES OF THAT TRACT DESCRIBED IN DOC. NO. 82-05146 AND SET MONUMENTS TO THOSE BOUNDARIES AS SHOWN HEREON. CONTROLLING MONUMENTS WERE TIED IN, AS WAS THE INTERSECTION OF HEFTY CREEK AND SMITH RIVER. THE BOUNDARY LOCATIONS WERE THEN COMPUTED, TRAVERSED, BLAZED, FLAGGED AND MONUMENTED.

FIELD CREW: DAVID EDWARDS AND BRANT MILLER.

EQUIPMENT: NIKON DTM 430 TOTAL STATION.

COMP. & DRAFTING: DAVID EDWARDS.

LEGEND

o INDICATES 5/8" x 30" STEEL PIN W/RED PLASTIC CAP MKD. D.A. EDWARDS-LS 2339" SET.

( ) DENOTES RECORD DATA PER M 95-49.

———— INDICATES BOUNDARY BLAZED AND FLAGGED THIS SURVEY.

×——×——×——× FENCE LINE

SCALE: 1" = 300'

BASIS OF BEARINGS: M 95-49 AS SHOWN.

N

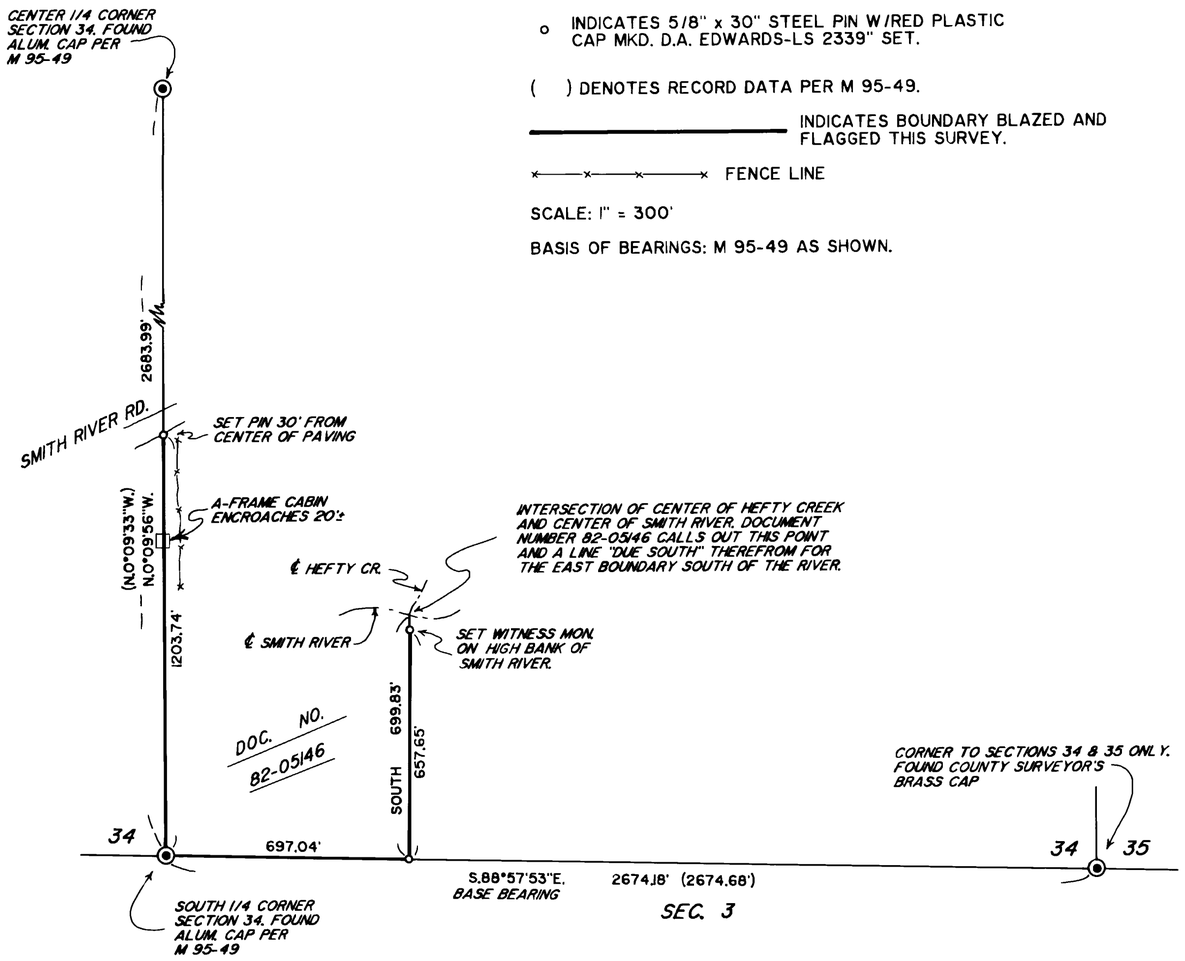

MAP FILE M130-31