COUNTY SURVEYORS FILE DATA
DO NOT REMOVE FROM OFFICE

NARRATIVE, THE PURPOSE OF THIS SURVEY IS TO BLAZE AND POST THE SOUTH AND WEST BOUNDARIES OF THE NORTH 1/2 OF THE SW1/4 OF SECTION 9. NO MONUMENTS WERE SET IN THIS SURVEY. THE C.S. 1/16 CORNER, THE SOUTH 1/16 CORNER AND THE WITNESS CORNER TO THE WEST 1/4 CORNER WERE FOUND IN THE FIELD AND USED AS CONTROL FOR THIS SURVEY. A CLOSED RANDOM PROPERTY LINE TRAVERSE, USING A WILD T-16 THEODOLITE AND A DI-4L E.D.M., WAS RUN BETWEEN THE CONTROLLING CORNERS FOUND IN THE FIELD. OFFSETS WERE COMPUTED FROM THIS RANDOM PROPERTY LINE TRAVERSE TO THE TRUE PROPERTY LINES. PROPERTY LINES WERE MARKED WITH RED PAINTED BLAZES, RED PLASTIC RIBBON AND RED METAL FENCE POSTS.

WITNESS CORNER TO WEST 1/4 CORNER SECTION 9
FD. 1966 B.L.M. IRON PIPE AND BRASS CAP
(TRUE CORNER BEARS NORTH, 1.65')
20" FIR, N38°W, 55.4' (SCAR VIS.), 1966 B.T.
24" CEDAR, N70°E, 37.3' (SCAR VIS.), 1966 B.T.

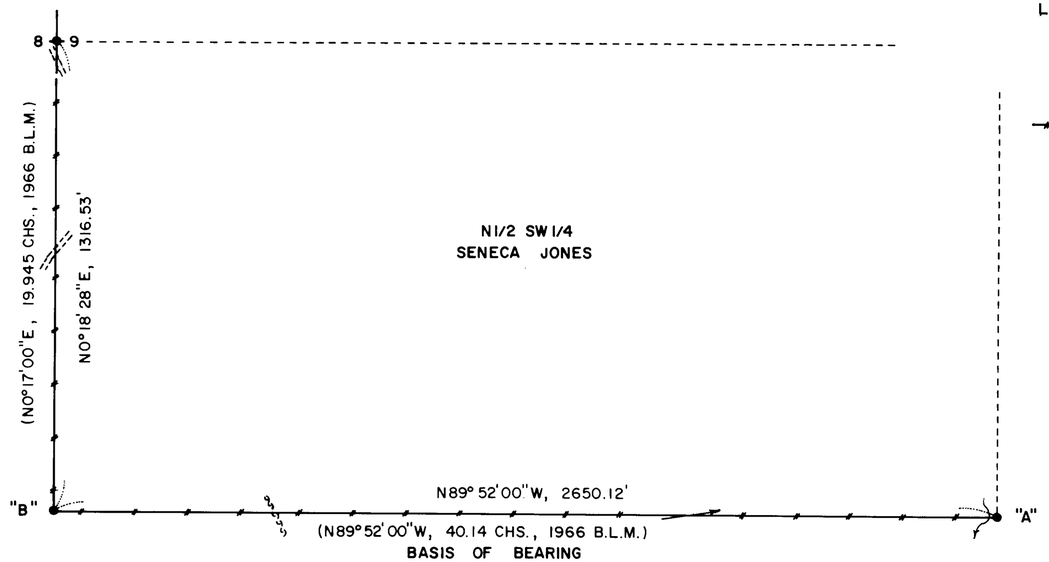

"B" SOUTH 1/16 CORNER TO SECTIONS 8 AND 9
FD. 1966 B.L.M. IRON PIPE AND BRASS CAP
24" CEDAR, N76°W, 61.0' (SCRIBE VIS.), 1966 B.T.
(RECORD S78°W, 61.4')
COULD NOT FIND 1966 S.E. BEARING TREE
6" FIR, N61°E, 48.0' (SCRIBE VIS.), NO RECORD

"A" C.S. 1/16 CORNER SECTION 9
FD. 1966 B.L.M. IRON PIPE AND BRASS CAP
13" FIR, N22°E, 9.9' (SCAR VIS.), 1966 B.T.
24" FIR, N51°W, 25.7' (SCAR VIS.), 1966 B.T.

FILED
Date: 6-16-1999 By: JC
This survey consists of:
Map: M 131-64
Narrative:
Corner Rpt:
DOUGLAS COUNTY
SURVEYOR CB
MAP FILE M 131-64

BOUNDARY SURVEY
FOR
SENECA JONES TIMBER COMPANY
IN
SW 1/4 SECTION 9, T29S, R3W, W.M.
DOUGLAS COUNTY, OREGON
BY
ROBERTS SURVEYING INC.
P.O. BOX 7155
EUGENE, OREGON 97401
PHONE 345-1112

LEGEND,

- ● MONUMENTS FOUND AND USED FOR CONTROL
- ○ MONUMENTS SET - NO MONUMENTS SET IN THIS SURVEY
- ( ) DATA OF RECORD - 1966 B.L.M. SURVEY
- LINES MARKED WITH RED PAINTED BLAZES, RED PLASTIC RIBBON AND RED METAL FENCE POSTS.
- BASIS OF BEARING - EAST-WEST ℄ OF SW 1/4 SECTION 9 FROM 1966 B.L.M. SURVEY (LINE "A-B")
- DISTANCES TO BEARING TREES ARE CENTER MEASURE
- ======= DIRT ROAD
- ——→ CREEK OR DRAW
- ~~~~~~ RIDGE

REGISTERED
PROFESSIONAL
LAND SURVEYOR
L. D. Roberts
OREGON
L. D. ROBERTS
1939
EXPIRES 12-31-2000

N

SCALE 1" = 300'
MAY 27, 1999