COUNTY SURVEYORS FILE DATA
DO NOT REMOVE FROM OFFICE

BOUNDARY LINE ADJUSTMENT SURVEY
IN THE SOUTHEAST 1/4, SECTION 20, T. 25 S., R. 5 W., W.M.
SUTHERLIN, OREGON - JUNE 1999
BLA 99-06-214

FILED
Date: 7-7-1999 By: JP
This survey consists of:
Map: M131-72
Narrative:
Corner Rpt:
DOUGLAS COUNTY
JP SURVEYOR CB

MAP FILE M131-72

APPROVAL:
Richard Schwab 6/23/99
CITY OF SUTHERLIN, PLANNING DEPARTMENT DATE

NARRATIVE:

THE PURPOSE OF THIS SURVEY IS TO MONUMENT THE ADJUSTED LINE BETWEEN INSTRUMENT #99-16029 AND INSTRUMENT #99-16030 , DOUGLAS COUNTY, OREGON, DEEDS AND RECORDS AT THE REQUEST OF THE PROPERTY OWNERS SHOWN AND AS APPROVED BY THE CITY OF SUTHERLIN PLANNING DEPT., APPROVAL BLA 99-06-214. MONUMENTS "A"- "G" AND "J" WERE TIED DURING THE FIELD SURVEY. MONUMENTS AT "F" AND "G" WERE HELD AND RECORD INFORMATION USED FROM RM2-66 TO POSITION POINT "H" . POINT "H" AND THE FOUND MONUMENT AT "J" WERE HELD TO ESTABLISH A PORTION OF THE EAST LINE OF THAT LAND DESCRIBED IN INSTRUMENT #99-16030. WITH THIS LINE ESTABLISHED AND HOLDING THE LINE BETWEEN THOSE MONUMENTS FOUND AT "A" AND "B", THE NEW BOUNDARY WAS LAID OUT PER THE DEED AND MONUMENTED AS SHOWN.

FIELD CREW: C. SWEEDEN, E. WILDS AND B. SCHARF
EQUIPMENT: DTM-430 W/ USUAL SUPPORT

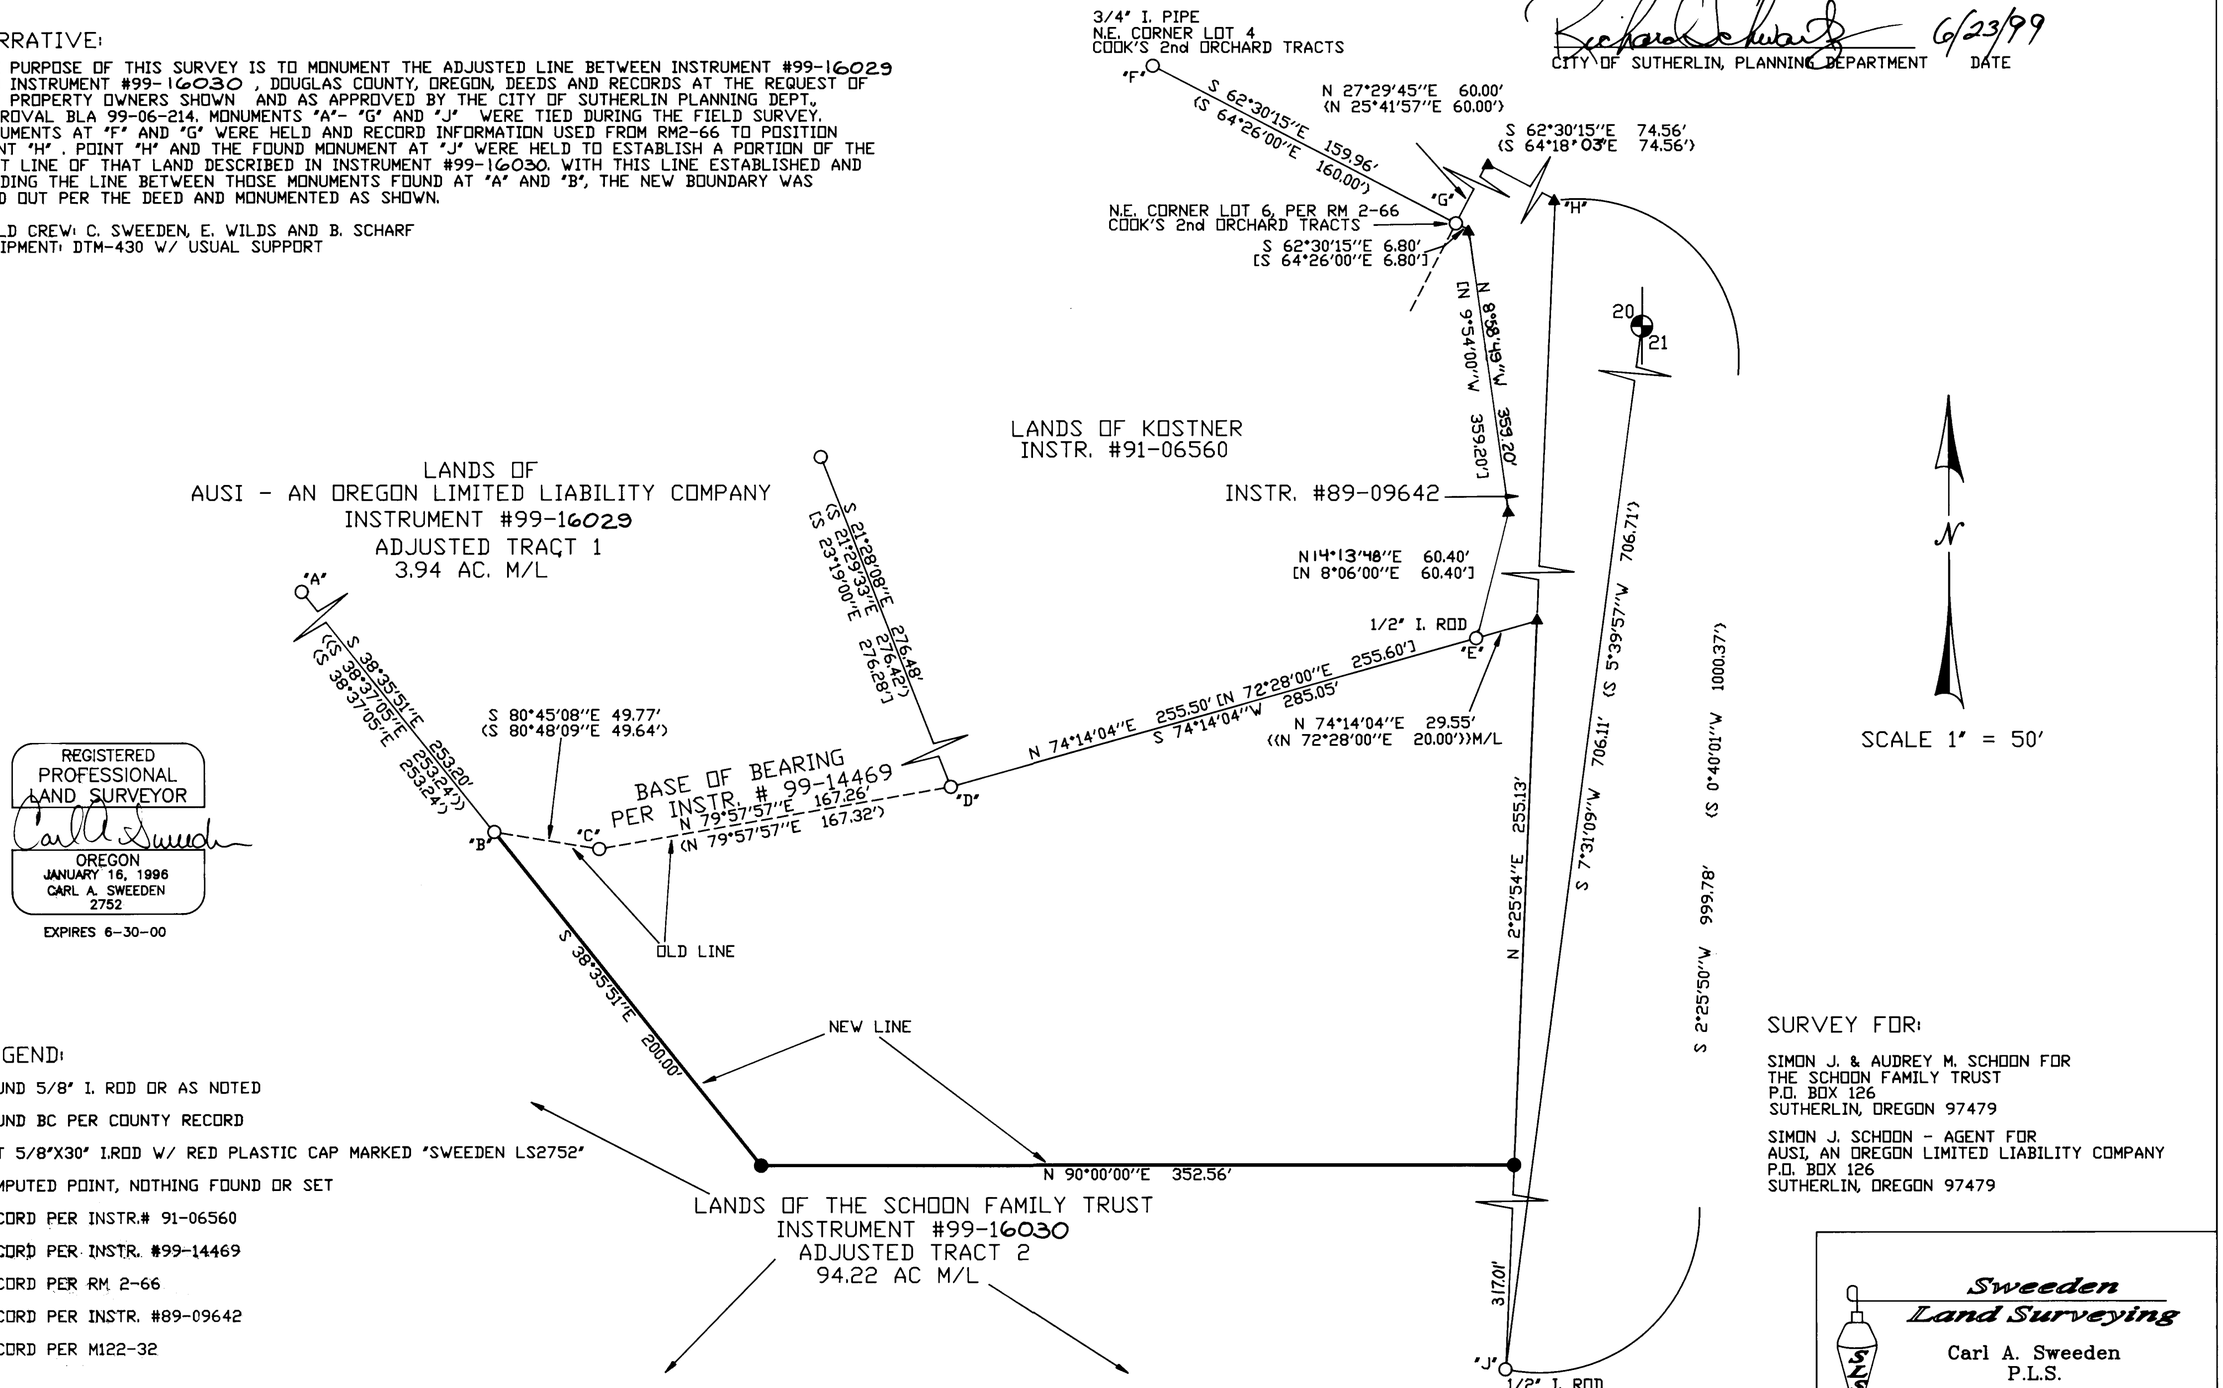

REGISTERED
PROFESSIONAL
LAND SURVEYOR
Carl A Sweeden
OREGON
JANUARY 16, 1996
CARL A. SWEEDEN
2752
EXPIRES 6-30-00

LEGEND:

- ○ FOUND 5/8" I. ROD OR AS NOTED
- ◐ FOUND BC PER COUNTY RECORD
- ● SET 5/8"X30" I.ROD W/ RED PLASTIC CAP MARKED "SWEEDEN LS2752"
- ▲ COMPUTED POINT, NOTHING FOUND OR SET
- [ ] RECORD PER INSTR.# 91-06560
- ( ) RECORD PER INSTR. #99-14469
- ( ) RECORD PER RM 2-66
- (( )) RECORD PER INSTR. #89-09642
- (( )) RECORD PER M122-32

SURVEY FOR:

SIMON J. & AUDREY M. SCHOON FOR
THE SCHOON FAMILY TRUST
P.O. BOX 126
SUTHERLIN, OREGON 97479

SIMON J. SCHOON - AGENT FOR
AUSI, AN OREGON LIMITED LIABILITY COMPANY
P.O. BOX 126
SUTHERLIN, OREGON 97479

Sweeden
Land Surveying
Carl A. Sweeden
P.L.S.
5211 Cole Road
Oakland, Ore. 97462
Tel. 541-459-9523

MAP FILE M131-72