MAP FILE M132-8

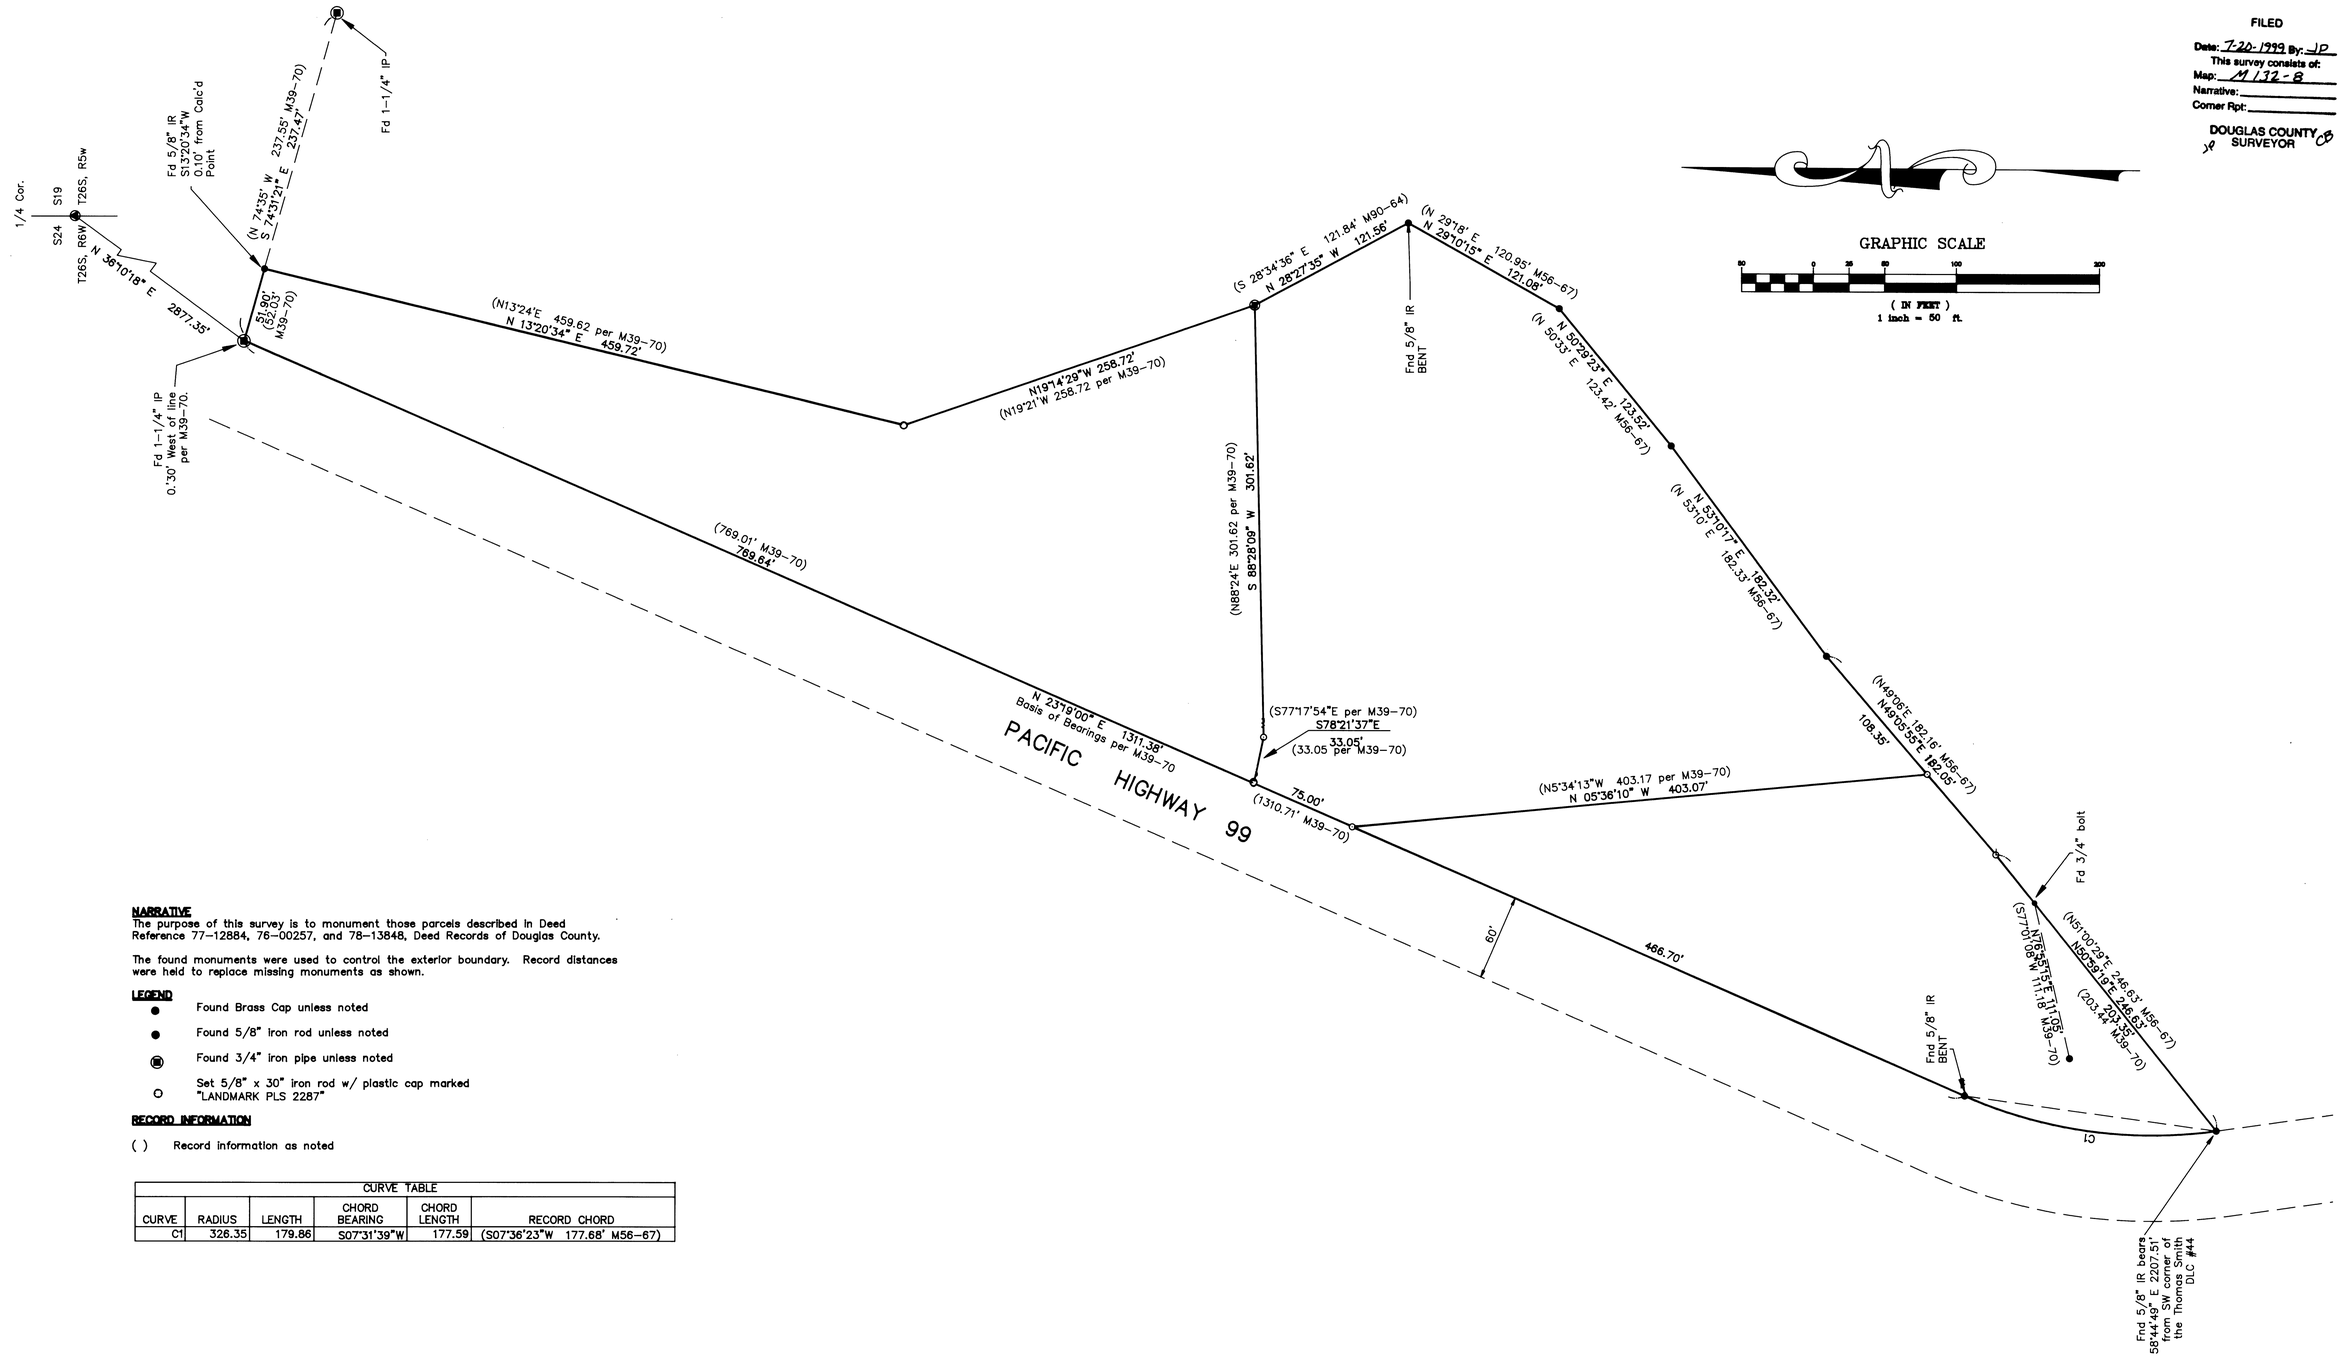

GRAPHIC SCALE

50 0 25 50 100 200

(IN FEET)
1 inch = 50 ft.

FILED

Date: 7-20-1999 By: JP
This survey consists of:
Map: M 132-8
Narrative:
Corner Rpt:

DOUGLAS COUNTY SURVEYOR

NARRATIVE
The purpose of this survey is to monument those parcels described in Deed Reference 77-12884, 76-00257, and 78-13848, Deed Records of Douglas County.

The found monuments were used to control the exterior boundary. Record distances were held to replace missing monuments as shown.

LEGEND

- ● Found Brass Cap unless noted
- ● Found 5/8" iron rod unless noted
- ⊛ Found 3/4" iron pipe unless noted
- ○ Set 5/8" x 30" iron rod w/ plastic cap marked "LANDMARK PLS 2287"

RECORD INFORMATION

( ) Record information as noted

CURVE TABLE					
CURVE	RADIUS	LENGTH	CHORD BEARING	CHORD LENGTH	RECORD CHORD
C1	326.35	179.86	S07°31'39"W	177.59	(S07°36'23"W 177.68' M56-67)

COUNTY SURVEYORS FILE DATA
DO NOT REMOVE FROM OFFICE

Sheet 1 of 1

BOUNDARY SURVEY

In the NE 1/4, Section 25 and the SE 1/4, Section 24, Township 26 South, Range 6 West, W.M.
DOUGLAS COUNTY, OREGON
July, 1999

FOR: Tom Beckley

REGISTERED PROFESSIONAL LAND SURVEYOR
Mark A. Heimburger
OREGON
JULY 16, 1987
MARK A. HEIMBURGER
2287
EXPIRES JUNE 30, 2001

Land Mark
SURVEYING & DEVELOPMENT
727 SE Cass Ave., Suite 415
Roseburg, Oregon 97470
Tel (541) 677-9400
Fax (541)677-9401

Land Projects\98-003\98-003.dwg

MAP FILE M132-8