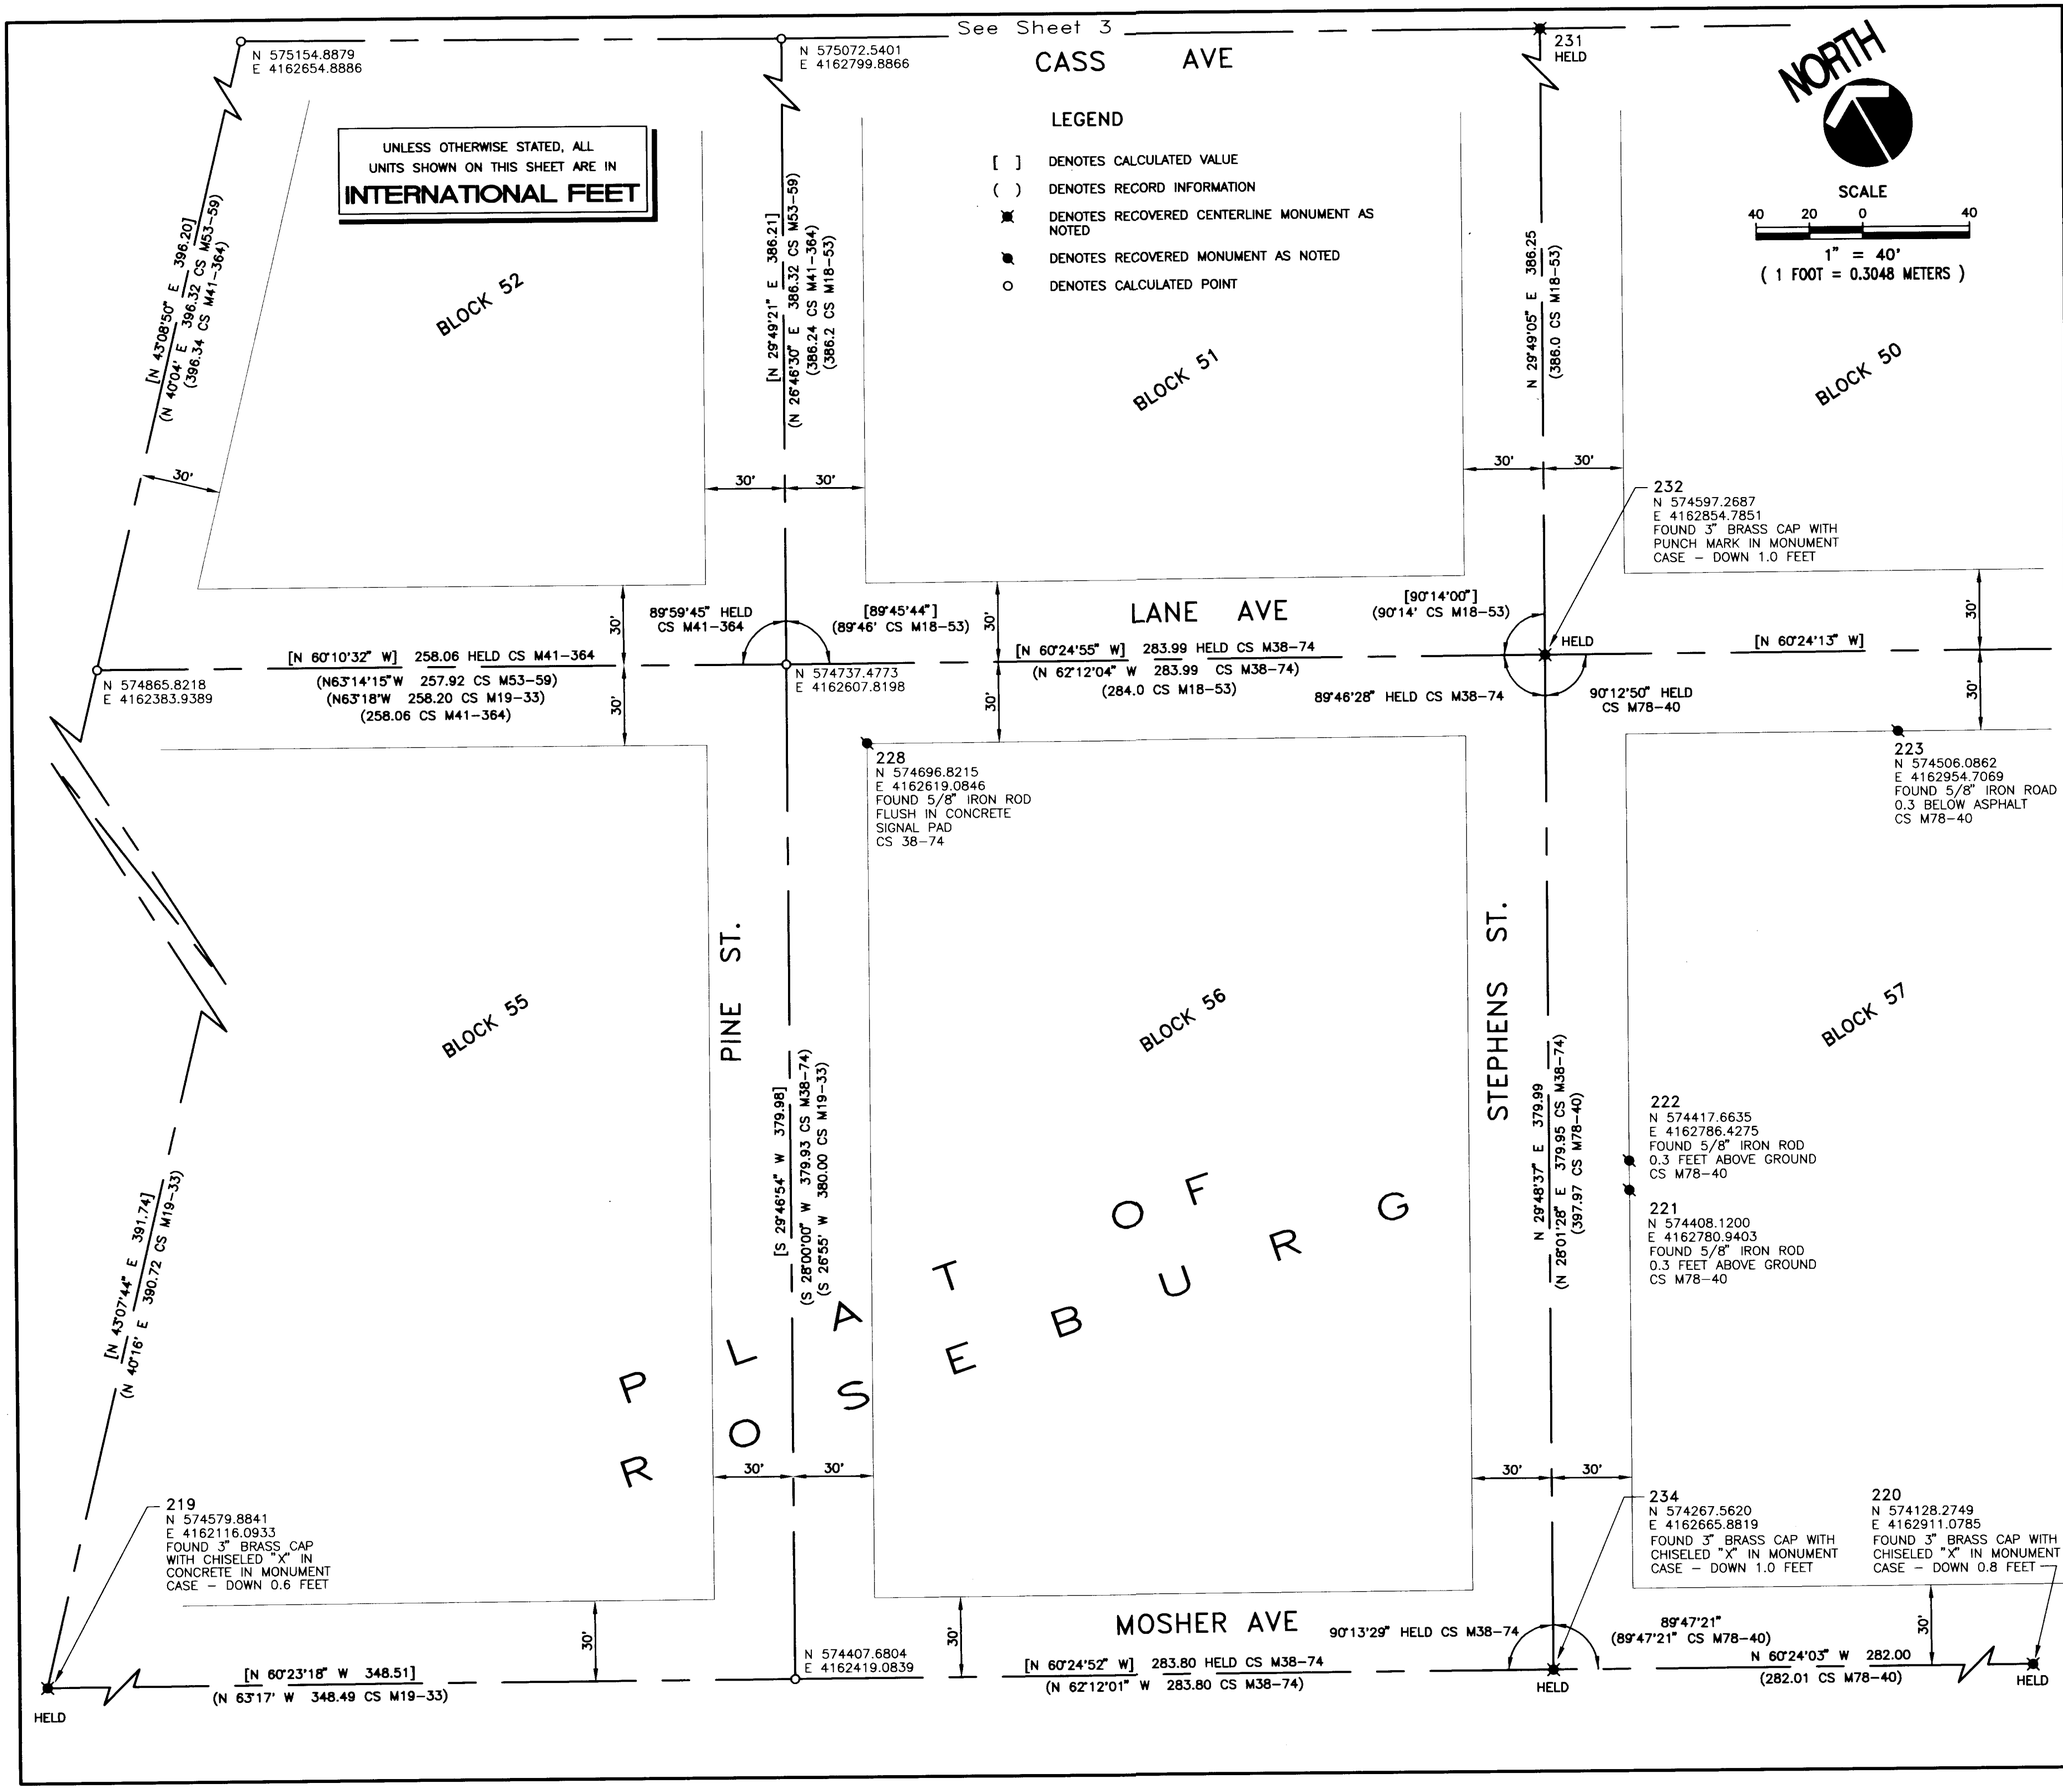

RCL	DEC. 1999
Calculated	Date
RCL	DEC. 1999
Drawn	Date
Checked	Date

REGISTERED PROFESSIONAL LAND SURVEYOR

Robert C. Lennox

OREGON
JULY 14, 1998
ROBERT C. LENNOX
2886

RENEWAL: 12-31-00

Preconstruction and Centerline Survey

FOR

Oregon Department of Transportation

Boundary Resolution

LOCATED IN THE NW 1/4 SECTION 19, T. 27 S., R. 5 W., W. M.

AND

LOCATED IN THE NE 1/4 SECTION 24, T. 27 S., R. 6 W., W. M.

CITY OF ROSEBURG, DOUGLAS COUNTY, OREGON

FILED

Date: 2/17/2000 By: JP

This survey consists of: 5 Pgs.

Map: M134-24B

Narrative:

Corner Rpt:

DOUGLAS COUNTY SURVEYOR

otak incorporated — surveyors engineers planners

17355 S.W. BOONES FERRY ROAD
LAKE OSWEGO, OREGON 97035
(503)635-3618 FAX (503)635-5395

2 OF 5

Sheet No.

9054-003

Project No.

MAP FILE M134-24B

MAP FILE M134-24B