FILED
Date: 5/11/2000 By: JP
This survey consists of:
Map: M134-68
Narrative:
Corner Rpt:
DOUGLAS COUNTY SURVEYOR

MAP FILE M134-68

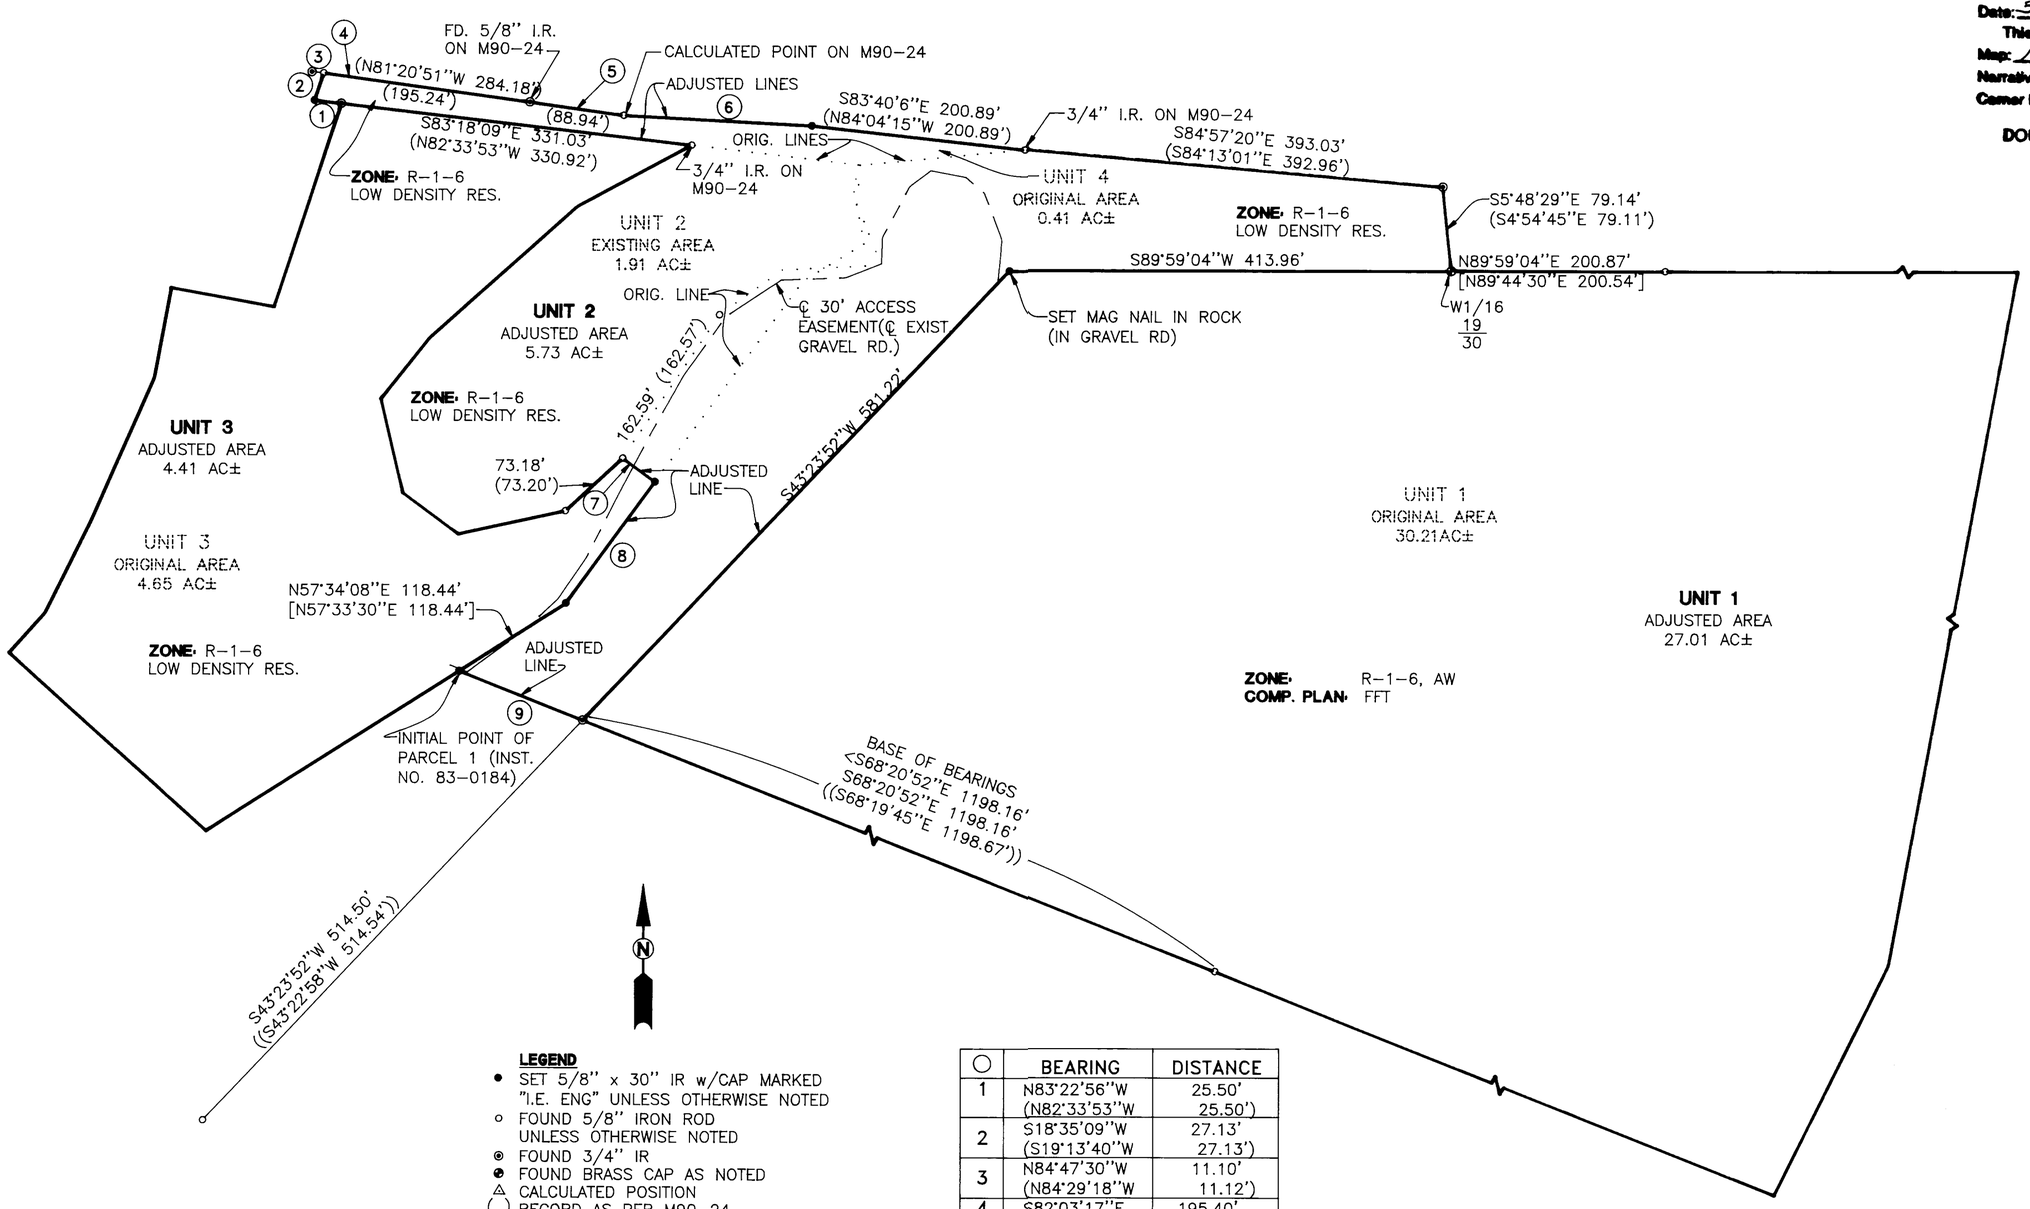

LEGEND

- ● SET 5/8" x 30" IR w/CAP MARKED "I.E. ENG" UNLESS OTHERWISE NOTED
- ○ FOUND 5/8" IRON ROD UNLESS OTHERWISE NOTED
- ◉ FOUND 3/4" IR
- ◉ FOUND BRASS CAP AS NOTED
- △ CALCULATED POSITION
- ( ) RECORD AS PER M90-24
- [ ] RECORD AS PER M1-58
- (()) RECORD AS PER M42-50
- <> RECORD AS PER SOON TO BE RECORDED PLAT OF "PARROTT CREEK ESTATES"

○	BEARING	DISTANCE
1	N83°22'56"W (N82°33'53"W	25.50' 25.50')
2	S18°35'09"W (S19°13'40"W	27.13' 27.13')
3	N84°47'30"W (N84°29'18"W	11.10' 11.12')
4	S82°03'17"E	195.40'
5	S82°01'12"E	88.99'
6	S86°54'55"E (S84°51'13"E	176.93' 176.93')
7	N53°45'52"W	37.60'
8	N36°14'08"E	141.07'
9	N68°20'52"W [N68°21'30"W	124.82' 124.82']

PLANNING DEPT. FILE NO. BLA-00-07

NARRATIVE:

THE PURPOSE OF THIS SURVEY WAS TO ADJUST BOUNDARY LINES OF INVOLVED PROPERTIES AS SHOWN.

APPROVALS:

COMMUNITY DEVELOPEMENT DIRECTOR — DATE 5-9-00

FIELD CREW: SAM COREY, WAYNE ROGERS, RYAN PALMER AND JIM FERRIS

EQUIPMENT: NIKON TOTAL STATION AND SDR 33 DATA COLLECTOR

OFFICE: NEIL HIBBS

DRAFTING: BRYAN CROSGROVE

REGISTERED PROFESSIONAL LAND SURVEYOR
OREGON JANUARY 12, 1999
F. NEIL HIBBS
52989
EXPIRES: 6/30/2001

BOUNDARY LINE ADJUSTMENT

LYING IN THE NW 1/4 OF SEC 30 & THE SW 1/4 OF SEC. 19, T27S, R5W, W. M., DOUGLAS COUNTY, OREGON

SURVEYED FOR:
JOHN ROBERTS
P.O. BOX 2442
EUGENE, OR.

SURVEYED BY:
i.e. ENGINEERING
741 S.E. Jackson Street
Roseburg, Oregon 97470
PHONE (541) 673-0166
FAX (541) 440-9392

SCALE: 1"=100' | DATE: MAY, 2000 | DWG. BY: BWC | JOB NO: 1372-03 | PAGE: 1 OF 1

MAP FILE M134-68