FILED
Date: 3/20/2001 By: JP
This survey consists of: 2 Pgs.
Map: M136-64A
Narrative:
Corner Rpt:
DOUGLAS COUNTY SURVEYOR

BOUNDARY SURVEY
IN
SECTION 8, T22S, R5W, W.M.
DOUGLAS COUNTY, OREGON
FOR
SENECA JONES TIMBER COMPANY
BY
ROBERTS SURVEYING INC.
P.O. BOX 7155
EUGENE, OREGON 97401
PHONE 345-1112

MAP FILE M136-64A

REGISTERED PROFESSIONAL LAND SURVEYOR
L. D. Roberts
EXPIRES 12-31-2002

"A" N.W. CORNER SECTION 8
FD. 1958 DOUGLAS COUNTY IRON PIPE AND BRASS CAP
16" FIR STUMP, N03°E, 139.5' (SCAR VIS.), 1958 B.T.
22" FIR STUMP, N59°W, 119.0' (SCAR VIS.), 1958 B.T.
24" FIR STUMP, S77°W, 134.2' (SCAR VIS.), 1958 B.T.

"B" NORTH 1/4 CORNER SECTION 8
NO EVIDENCE FOUND OF ORIGINAL CORNER.
COMPUTED POINT - NO MONUMENT SET THIS SURVEY

"C" EAST 1/16 CORNER SECTION 8
COMPUTED POINT - NO MONUMENT SET THIS SURVEY

"D" N.E. CORNER SECTION 8
FD. 3/4" IRON PIN SET BY DOUGLAS CO. IN 1965
22" FIR STUMP, N41°W, 32.8' (SCRIBE VIS.), 1926 B.T.
10" OAK SNAG, N05°W, 102.1' (SCAR VIS.), 1959 B.T.
24" FIR, N24°E, 49.1' (SCAR VIS.), 1959 B.T.
12" FIR STUMP, S30°E, 54.5' (SCRIBE VIS.), 1965 B.T.
22" FIR, S41°W, 103.0' (SCAR VIS.), 1965 B.T.

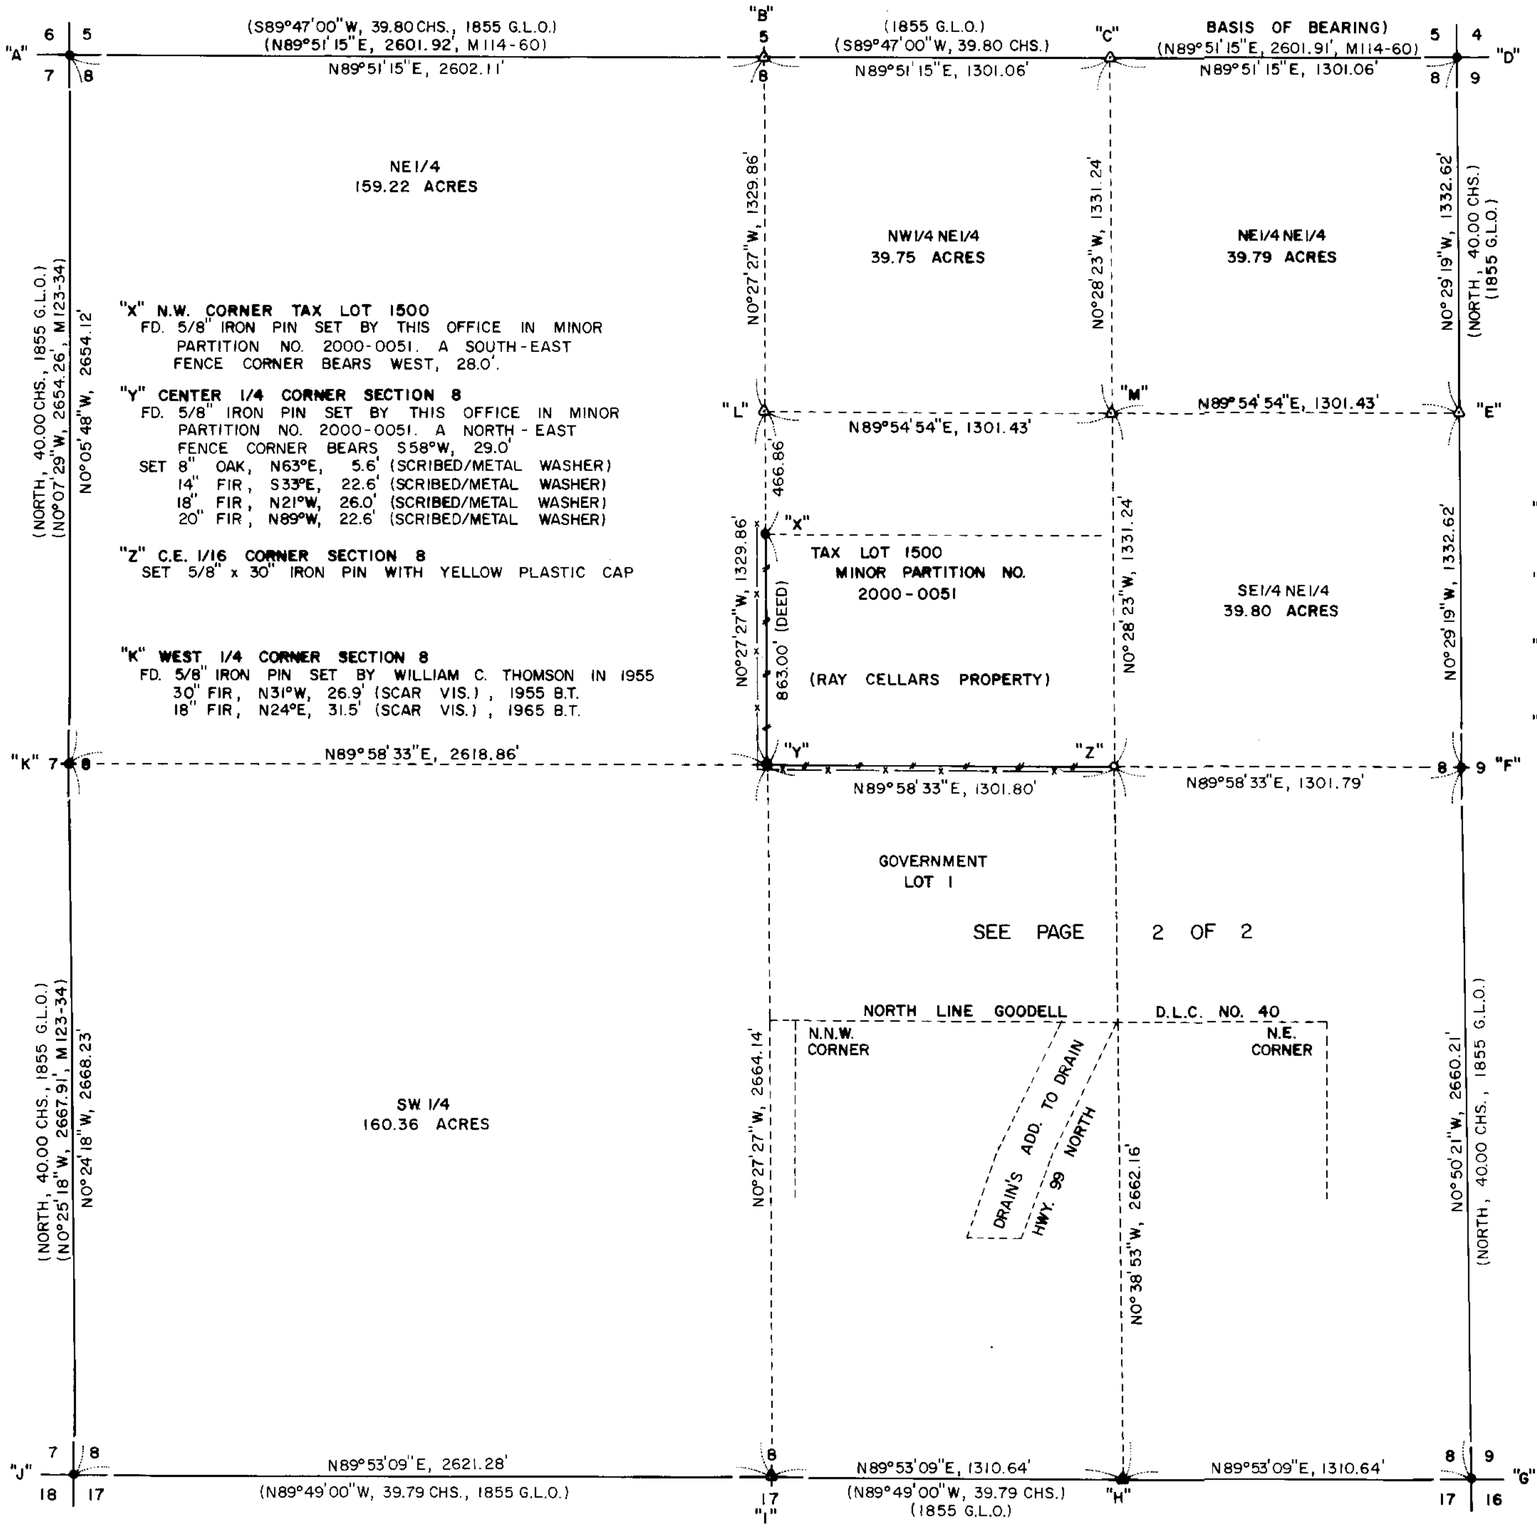

"X" N.W. CORNER TAX LOT 1500
FD. 5/8" IRON PIN SET BY THIS OFFICE IN MINOR PARTITION NO. 2000-0051. A SOUTH-EAST FENCE CORNER BEARS WEST, 28.0'.

"Y" CENTER 1/4 CORNER SECTION 8
FD. 5/8" IRON PIN SET BY THIS OFFICE IN MINOR PARTITION NO. 2000-0051. A NORTH-EAST FENCE CORNER BEARS S58°W, 29.0'
SET 8" OAK, N63°E, 5.6' (SCRIBED/METAL WASHER)
14" FIR, S33°E, 22.6' (SCRIBED/METAL WASHER)
18" FIR, N21°W, 26.0' (SCRIBED/METAL WASHER)
20" FIR, N89°W, 22.6' (SCRIBED/METAL WASHER)

"Z" C.E. 1/16 CORNER SECTION 8
SET 5/8" x 30" IRON PIN WITH YELLOW PLASTIC CAP

"K" WEST 1/4 CORNER SECTION 8
FD. 5/8" IRON PIN SET BY WILLIAM C. THOMSON IN 1955
30" FIR, N31°W, 26.9' (SCAR VIS.), 1955 B.T.
18" FIR, N24°E, 31.5' (SCAR VIS.), 1965 B.T.

"E" NORTH 1/16 CORNER SECTION 8
COMPUTED POINT - NO MONUMENT SET IN THIS SURVEY

"L" C.N. 1/16 CORNER SECTION 8
COMPUTED POINT - NO MONUMENT SET IN THIS SURVEY

"M" N.E. 1/16 CORNER SECTION 8
COMPUTED POINT - NO MONUMENT SET IN THIS SURVEY

"F" EAST 1/4 CORNER SECTION 8
FD. 1981 DOUGLAS COUNTY IRON PIPE & BRASS CAP
40" W. OAK, S35°E, 25.7' (OPENED FACE), 1855 B.T.
14" FIR, S10°W, 100.9' (SCAR VIS.), 1981 B.T.

N

SCALE 1" = 400'
JANUARY 5, 2001

LEGEND,

- ● MONUMENTS FOUND AND USED FOR CONTROL
- △ COMPUTED POINT - NO MONUMENT SET
- ○ MONUMENTS SET - 5/8" x 30" IRON PINS WITH YELLOW PLASTIC CAPS. CAPS MARKED ROBERTS SURVEYING INC.
- LINES MARKED WITH RED PAINTED BLAZES, RED PLASTIC RIBBON AND GREEN METAL FENCE POSTS.
- ( ) DATA OF RECORD - SURVEY OF DRAIN'S ADDITION TO DRAIN BY G.G. STEWART ON JANUARY 23, 1922. COUNTY SURVEY C.S. 41/344 BY WILLIAM THOMSON IN FEBRUARY OF 1955. MAP FILE M17-20 BY WILFORD HAINES IN 1959. MAP FILE M90-78 BY TORLEIV FLATEBO IN OCTOBER OF 1985. MAP FILE M114-60 BY DONALD L. PEEL IN FEBRUARY OF 1992. MAP FILE M123-34 BY HARVEY CHRISTENSEN IN FEBRUARY OF 1996. MINOR PARTITION 2000-0051 BY THIS OFFICE IN JULY OF 2000.

BASIS OF BEARING - NORTH LINE OF SECTION 8 FROM MAP FILE M114-60 BY DONALD L. PEEL IN FEBRUARY OF 1992.

DISTANCES TO BEARING TREES ARE CENTER MEASURE

ALL NEW BEARING TREES ARE SCRIBED AND HAVE A METAL WASHER STAMPED P.L.S. 1039 NAILED TO LOWER BLAZE. LOWER BLAZES ARE PAINTED RED.

NARRATIVE, THE PURPOSE OF THIS SURVEY IS TO POST AND BLAZE THE SOUTH LINE OF THE SW1/4NE1/4 AND TO POST AND BLAZE THE SOUTH 863 FEET OF THE WEST LINE OF THE SW1/4NE1/4 OF SECTION 8. ALSO THE C.E. 1/16 CORNER WAS SET IN THIS SURVEY. THE N.W. SECTION CORNER, THE N.E. SECTION CORNER, THE EAST 1/4 CORNER, THE S.E. SECTION CORNER, THE S.W. SECTION CORNER AND THE WEST 1/4 CORNER WERE FOUND IN THE FIELD AND USED AS CONTROL FOR THIS SURVEY. A SERIES OF E.D.M. CONTROL TRAVERSES, USING A WILD T-16 THEODOLITE AND A DI-4L E.D.M., WERE RUN BETWEEN THE CONTROLLING CORNERS FOUND IN THE FIELD. THE NORTH 1/4 CORNER, COMPUTED POINT "B", WAS ESTABLISHED BY SINGLE PROPORTIONATE MEASURE BETWEEN THE FOUND N.W. AND N.E. SECTION CORNERS. THE SOUTH 1/4 CORNER, COMPUTED POINT "I", WAS ESTABLISHED BY SINGLE PROPORTIONATE MEASURE BETWEEN THE FOUND S.W. AND S.E. SECTION CORNERS. SECTION 8 WAS SUBDIVIDED ACCORDING TO THE MANUAL OF INSTRUCTIONS FOR THE SURVEY OF THE PUBLIC LANDS OF THE UNITED STATES. THE CENTER 1/4 CORNER, MONUMENT "Y" AS SET BY THIS OFFICE IN (CONTINUED ON PAGE 2 OF 2)

"J" S.W. CORNER SECTION 8
FD. 1/2" MONEL PIPE SET BY WEYERHAEUSER CO. IN 1960
60" FIR STUMP, N12°E, 17.2' (NO MARKS), 1855 B.T.
10" FIR SNAG, S22°W, 32.5' (SCAR VIS.), 1955 B.T.
29" FIR, S31°E, 57.5' (SCAR VIS.), 1955 B.T.

"H" EAST 1/16 CORNER SECTION 8
COMPUTED POINT - NO MONUMENT SET THIS SURVEY

"I" SOUTH 1/4 CORNER SECTION 8
NO EVIDENCE FOUND OF ORIGINAL CORNER
COMPUTED POINT - NO MONUMENT SET THIS SURVEY

"G" S.E. CORNER SECTION 8
FD. 1948 DOUGLAS COUNTY IRON PIPE & BRASS CAP
36" OAK SNAG, N63°E, 71.0' (SCAR VIS.), 1855 B.T.
24" OAK WINDFALL, SOUTH, 8.5' (NO MARKS), 1920 B.T.
36" FIR, S75°E, 111.7' (SCAR VIS.), 1948 B.T.

MAP FILE M136-64A