COUNTY SURVEYORS FILE DATA
DO NOT REMOVE FROM OFFICE

FILED
Date: 4/18/2003 By: JP
This survey consists of: 1 Pgs.
Map: M137-59 B
Name(s):
Corner Rpt:
DOUGLAS COUNTY
JP SURVEYOR

MAP FILE M137-59B

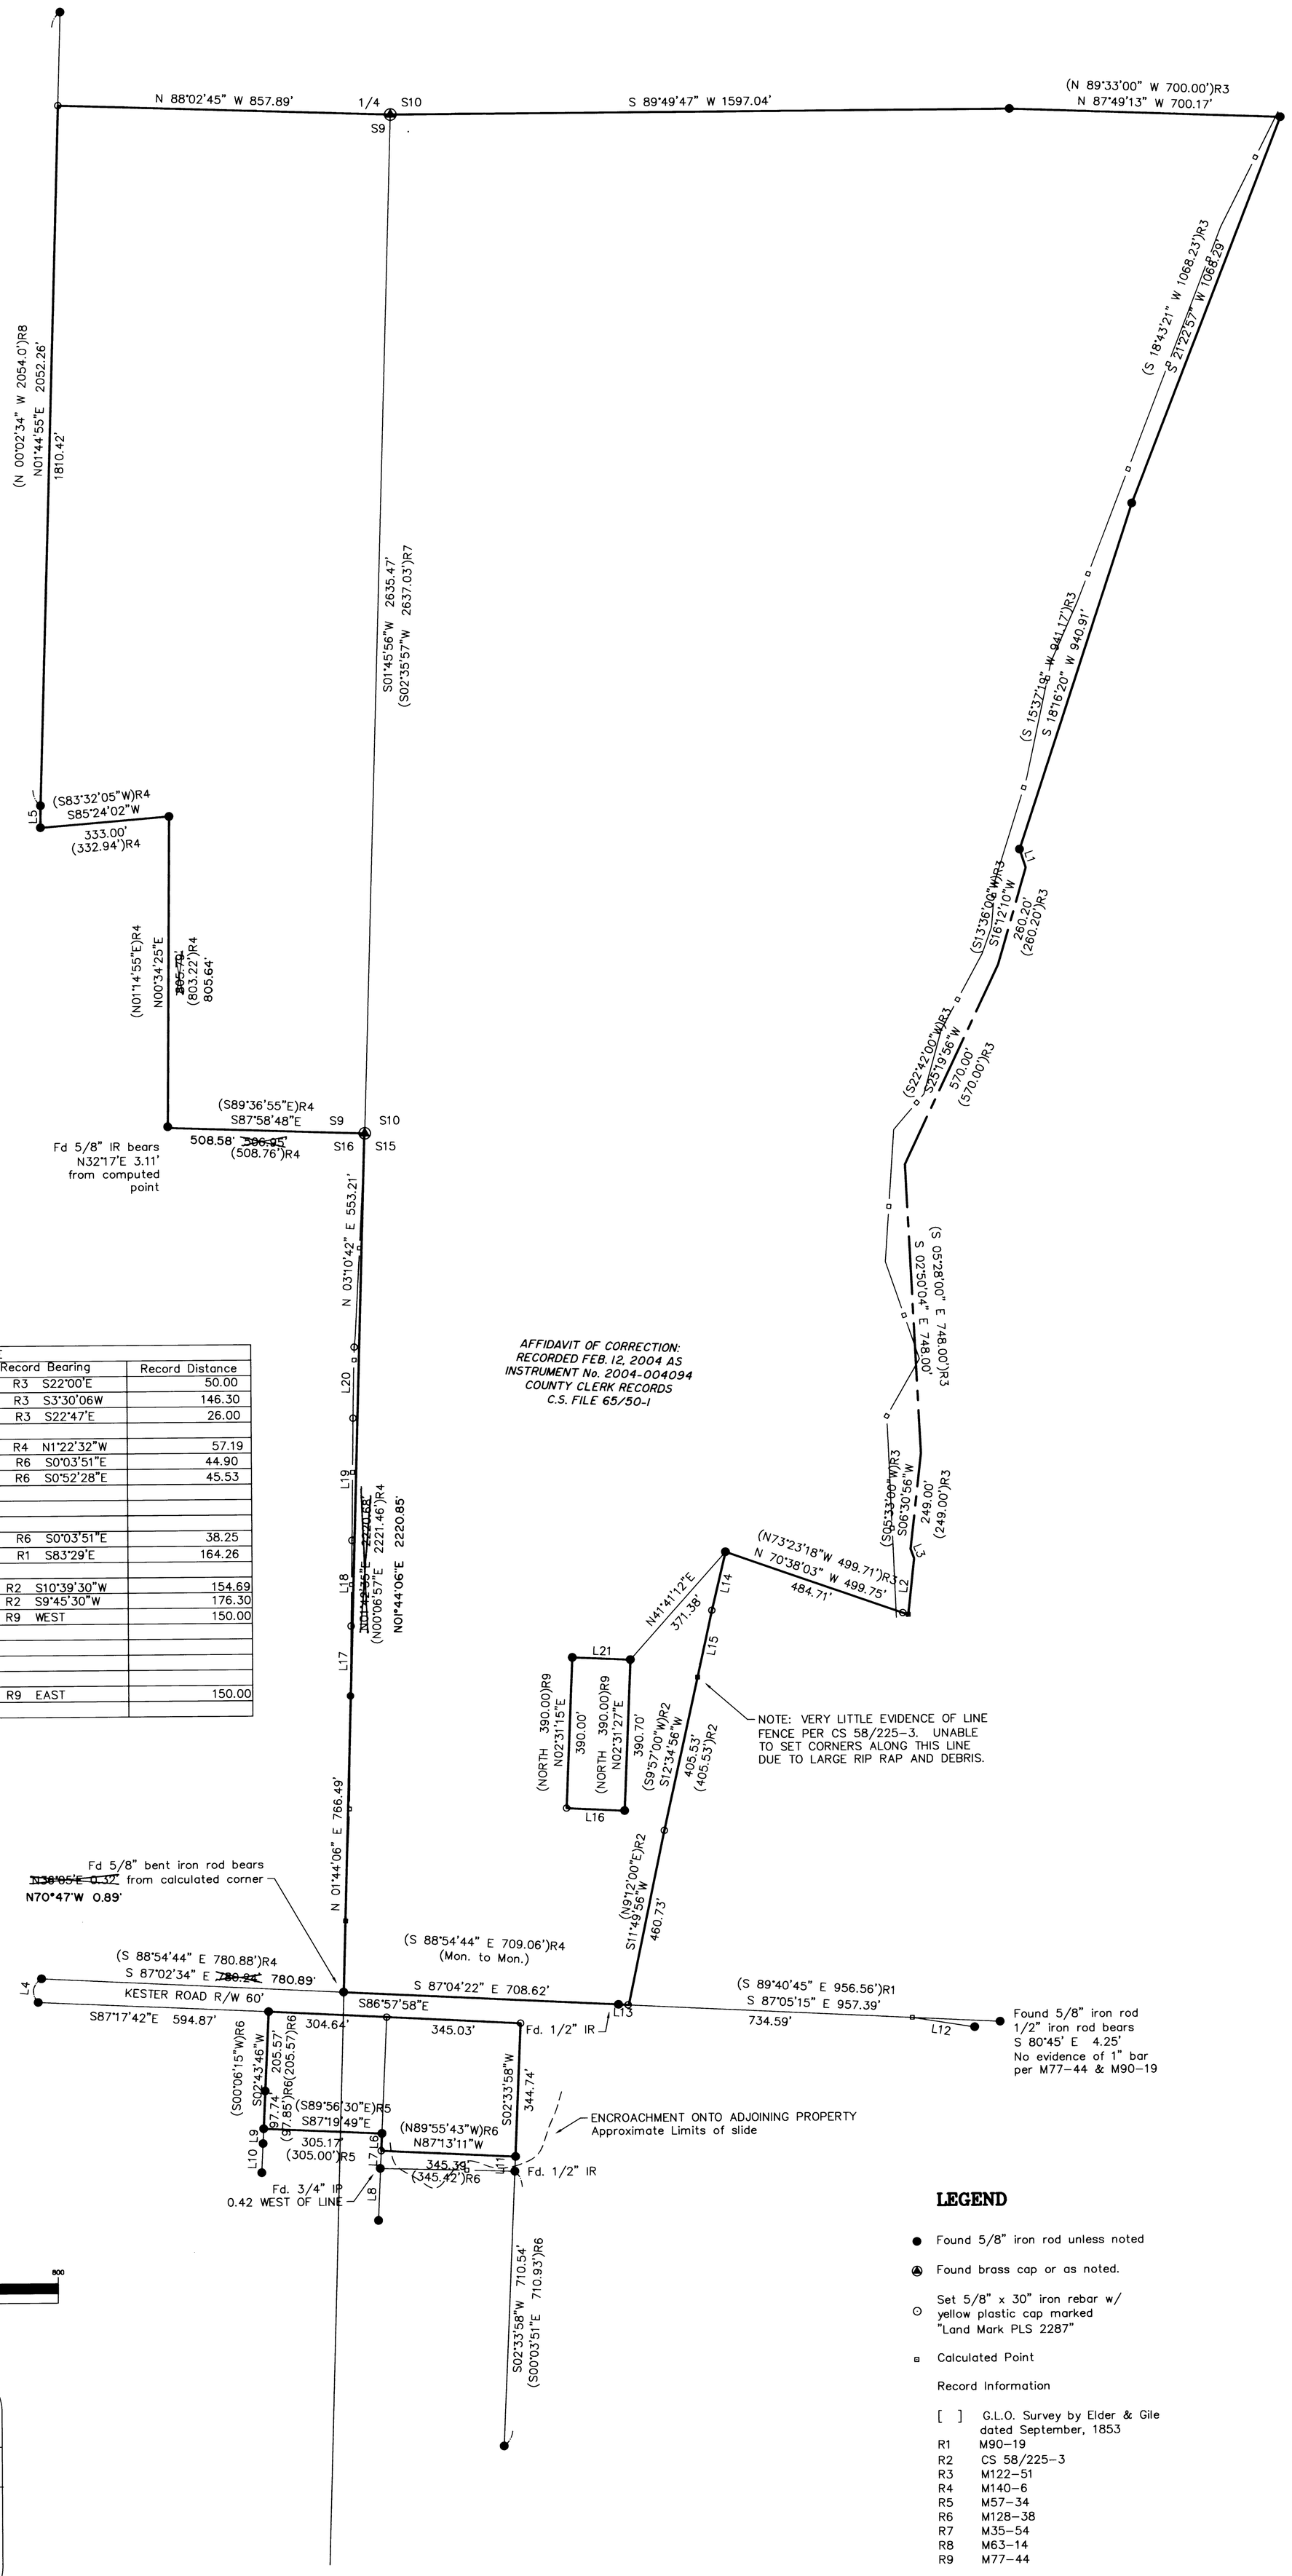

LINE TABLE				
LINE	LENGTH	BEARING	Record Bearing	Record Distance
L1	50.00	S18°09'12"E	R3 S22°00'E	50.00
L2	146.30	S06°08'02"W	R3 S3°30'06W	146.30
L3	26.00	S20°09'04"E	R3 S22°47'E	26.00
L4	61.90	N08°15'38"E		
L5	57.09	N00°33'08"E	R4 N1°22'32"W	57.19
L6	44.90	S02°37'37"W	R6 S0°03'51"E	44.90
L7	45.64	S03°44'42"W	R6 S0°52'28"E	45.53
L8	134.44	S02°14'51"W		
L9	38.30	S02°33'32"W		
L10	75.35	S02°58'49"W		
L11	38.07	S03°12'04"W	R6 S0°03'51"E	38.25
L12	164.15	S80°54'39"E	R1 S83°29'E	164.26
L13	26.71	S86°36'56"E		
L14	155.75	S13°20'45"W	R2 S10°39'30"W	154.69
L15	176.30	S12°23'26"W	R2 S9°45'30"W	176.30
L16	150.00	N87°08'39"W	R9 WEST	150.00
L17	180.39	N00°53'13"E		
L18	221.55	N00°54'20"E		
L19	315.65	N00°48'08"E		
L20	183.80	N01°19'57"E		
L21	150.02	N87°24'36"W	R9 EAST	150.00

GRAPHIC SCALE

200 0 100 200 400 800

(IN FEET)
1 inch = 200 ft.

LEGEND

- ● Found 5/8" iron rod unless noted
- Found brass cap or as noted.
- Set 5/8" x 30" iron rebar w/ yellow plastic cap marked "Land Mark PLS 2287"
- Calculated Point

Record Information

[ ]	G.L.O. Survey by Elder & Gile dated September, 1853
R1	M90-19
R2	CS 58/225-3
R3	M122-51
R4	M140-6
R5	M57-34
R6	M128-38
R7	M35-54
R8	M63-14
R9	M77-44

Sheet 2 of 2

Boundary Survey

Sections 9, 10, 15 & 16
Township 27 South, Range 5 West, W.M.
Douglas County, Oregon
APRIL, 2003

FOR: ROSEBURG SAND & GRAVEL CO.

REGISTERED
PROFESSIONAL
LAND SURVEYOR
OREGON
JULY 16, 1987
MARK A. HEIMBURGER
2287
EXPIRES 6/30/03

Land Mark
SURVEYING INC.
3329 N.E. Stephens Street
Roseburg, Oregon 97470
Tel (541) 677-9400
Fax (541) 677-9401

LM Proj. No. 3.0015

MAP FILE M137-59B

Land Projects 2003-0015 Roby Sand & Gravel.dwg 2003-0015 bndry2.dwg -4/18/2003 5:15:40 AM, Land Mark Surveying, Inc.