BOUNDARY LINE ADJUSTMENT
IN THE S.W. 1/4 of SEC. 9, T. 26S., R. 3W.W.M.
Surveyed for - Duane Brown
by Bruce Rogers
1727 S.E. Mill St.
Roseburg, OR

May, 2001
1" = 20'

Planning file 01-011
for Boundary line Adjustment and
Administrative Varience to 5 ft. setback
for existing carport on
Adjusted Unit 1.

FILED
Date: 6/25/2001 By: JP
This survey consists of:
Map: M138-22
Narrative:
Corner Rpt:
DOUGLAS COUNTY
SURVEYOR

MAP FILE M138-22

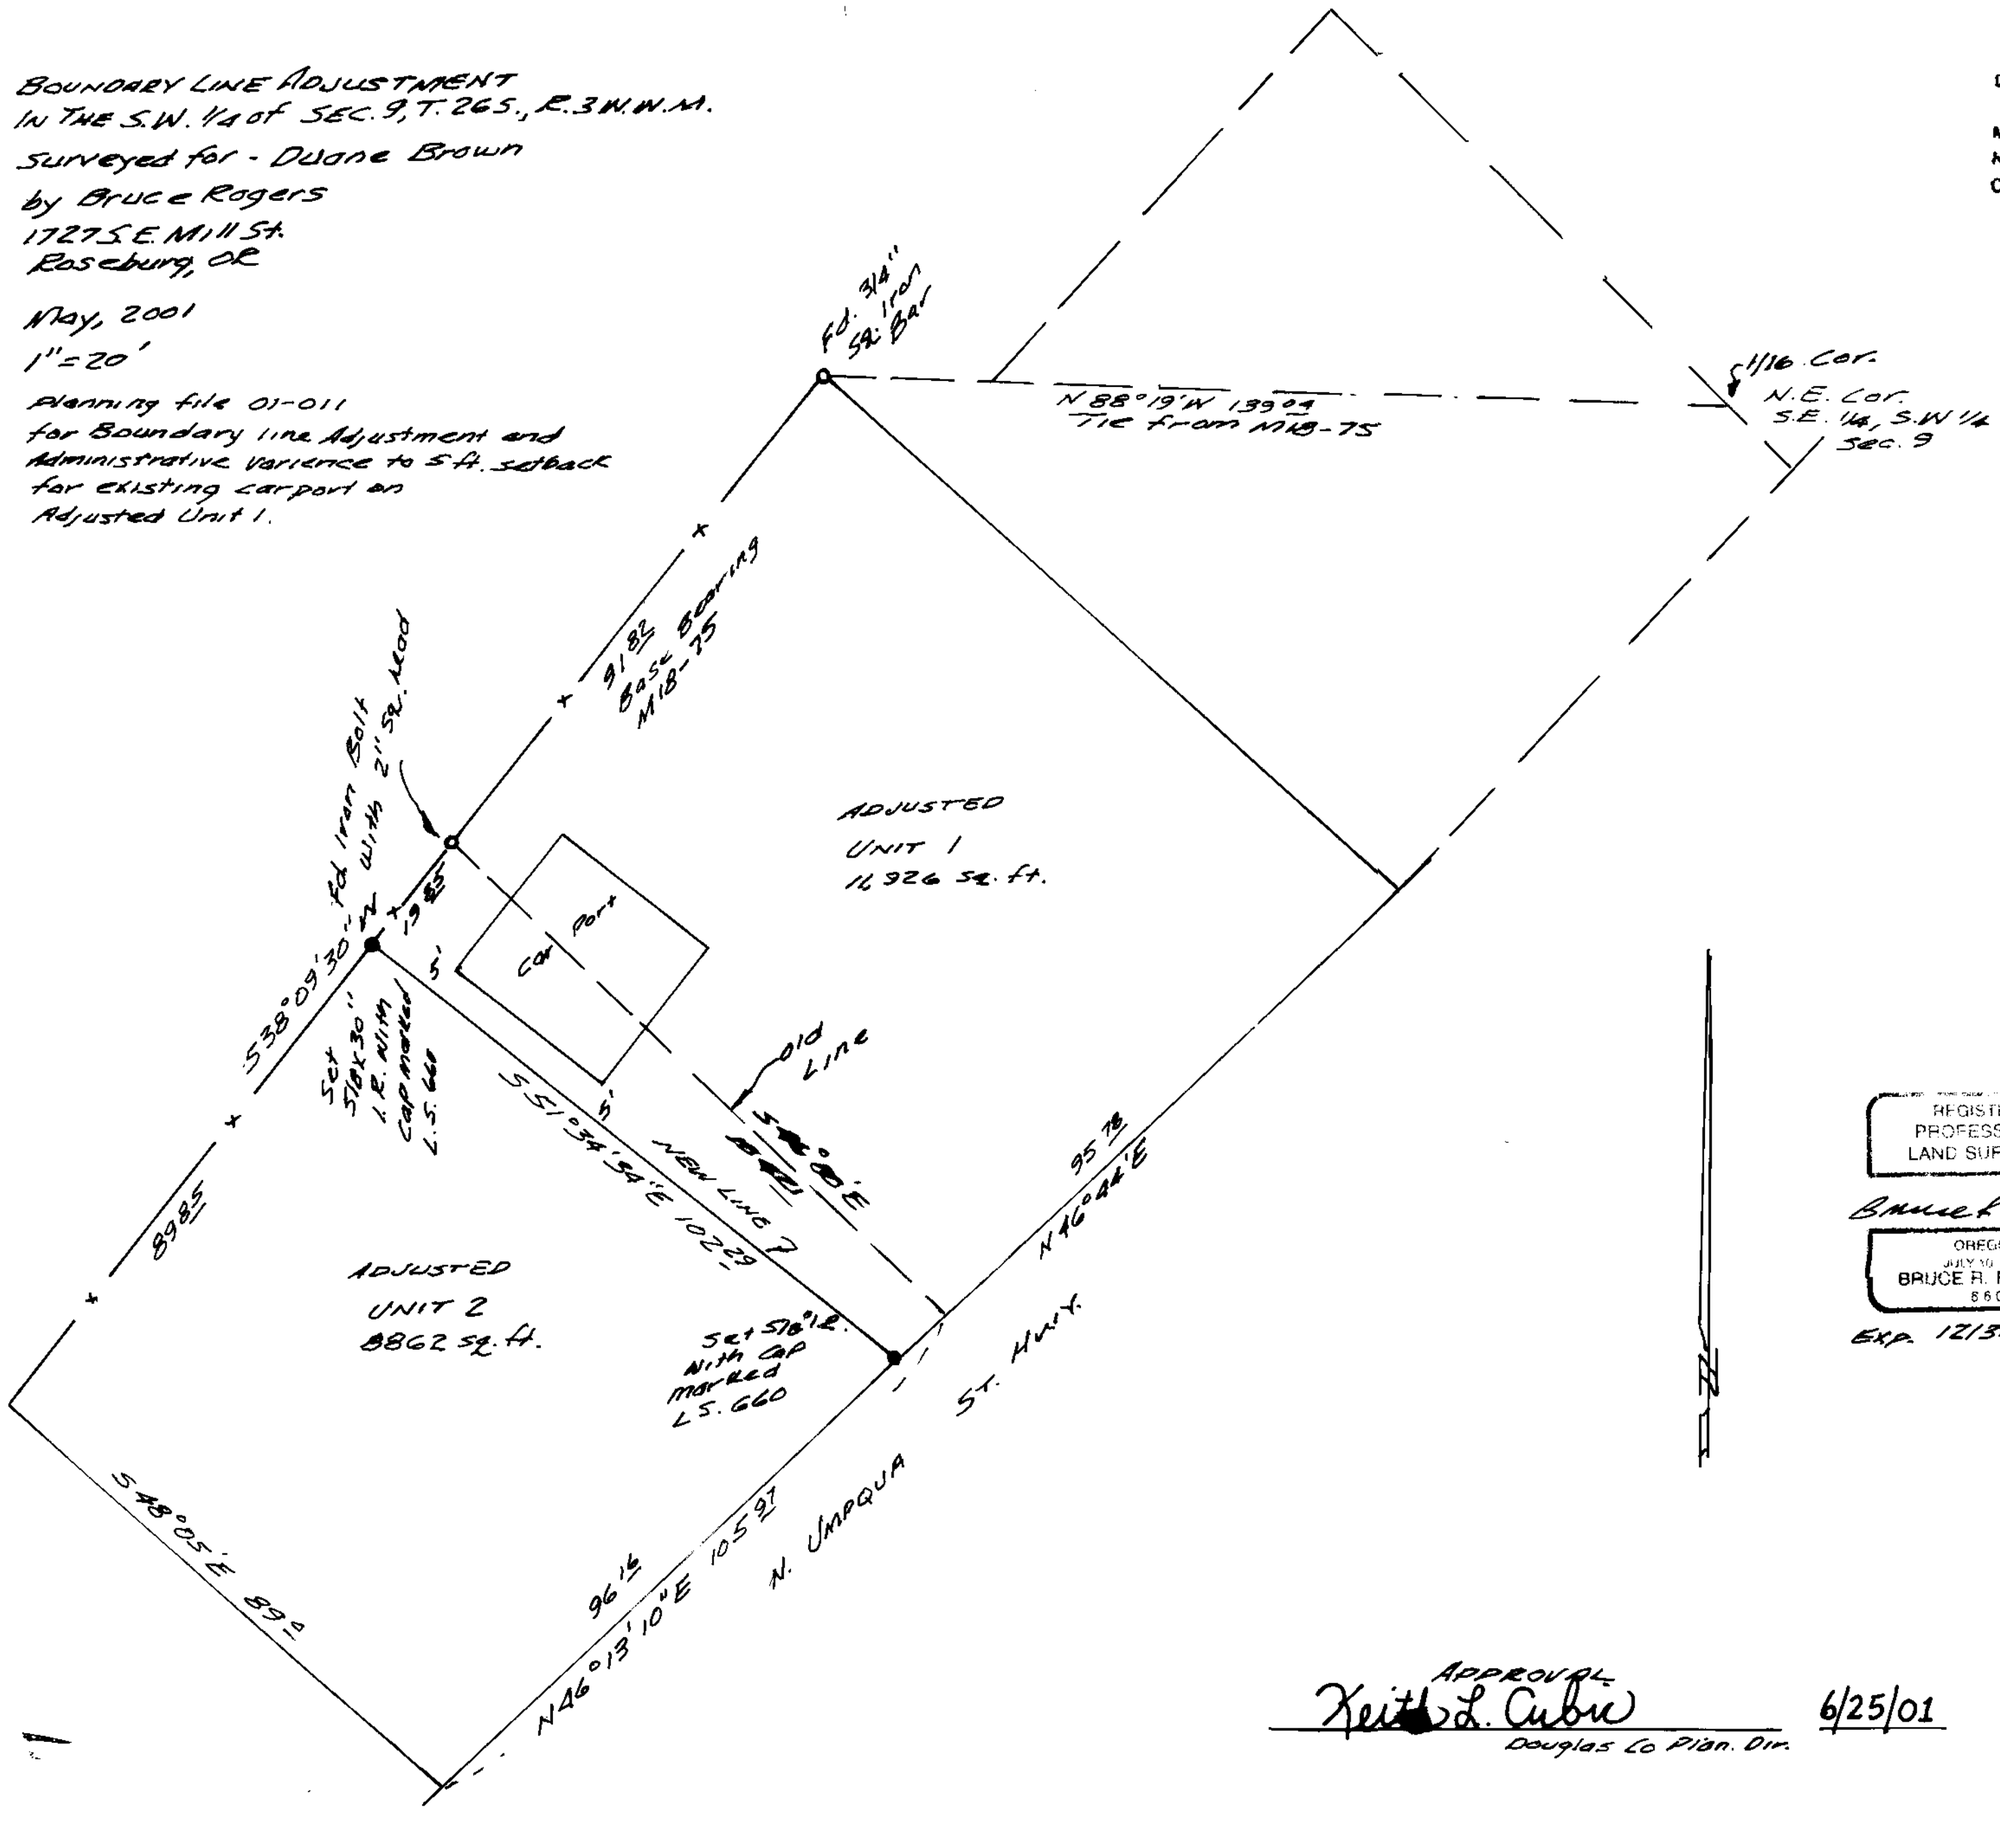

REGISTERED
PROFESSIONAL
LAND SURVEYOR
Bruce R. Rogers
OREGON
JULY 10, 1984
BRUCE R. ROGERS
560
EXP. 12/31/02

APPROVAL
Keith L. Cubic 6/25/01
Douglas Co Plan. Dir.

MAP FILE M138-22