MAP OF SURVEY

LOCATED in Sections 21 and 22, T. 25 S., R. 7 W., W.M. in Douglas County, Oregon.

July 20, 2001

FILED
Date: 7/24/2001 By: SP
This survey consists of:
Map: M 138-39
Narrative:
Corner Rpt:

DOUGLAS COUNTY SURVEYOR

MAP FILE M 138-39

SURVEYED BY: *DAVID EDWARDS LAND SURVEYING*
P.O. BOX 361
OAKLAND, OREGON 97462
PHONE: (541) 459-0512

SURVEYED FOR: *MENASHA FOREST PRODUCTS*
P.O. BOX 588
NORTH BEND, OREGON 97459

REGISTERED PROFESSIONAL LAND SURVEYOR
David A. Edwards
OREGON
JULY 26, 1990
DAVID A. EDWARDS
2339
EXPIRES 12/31/01

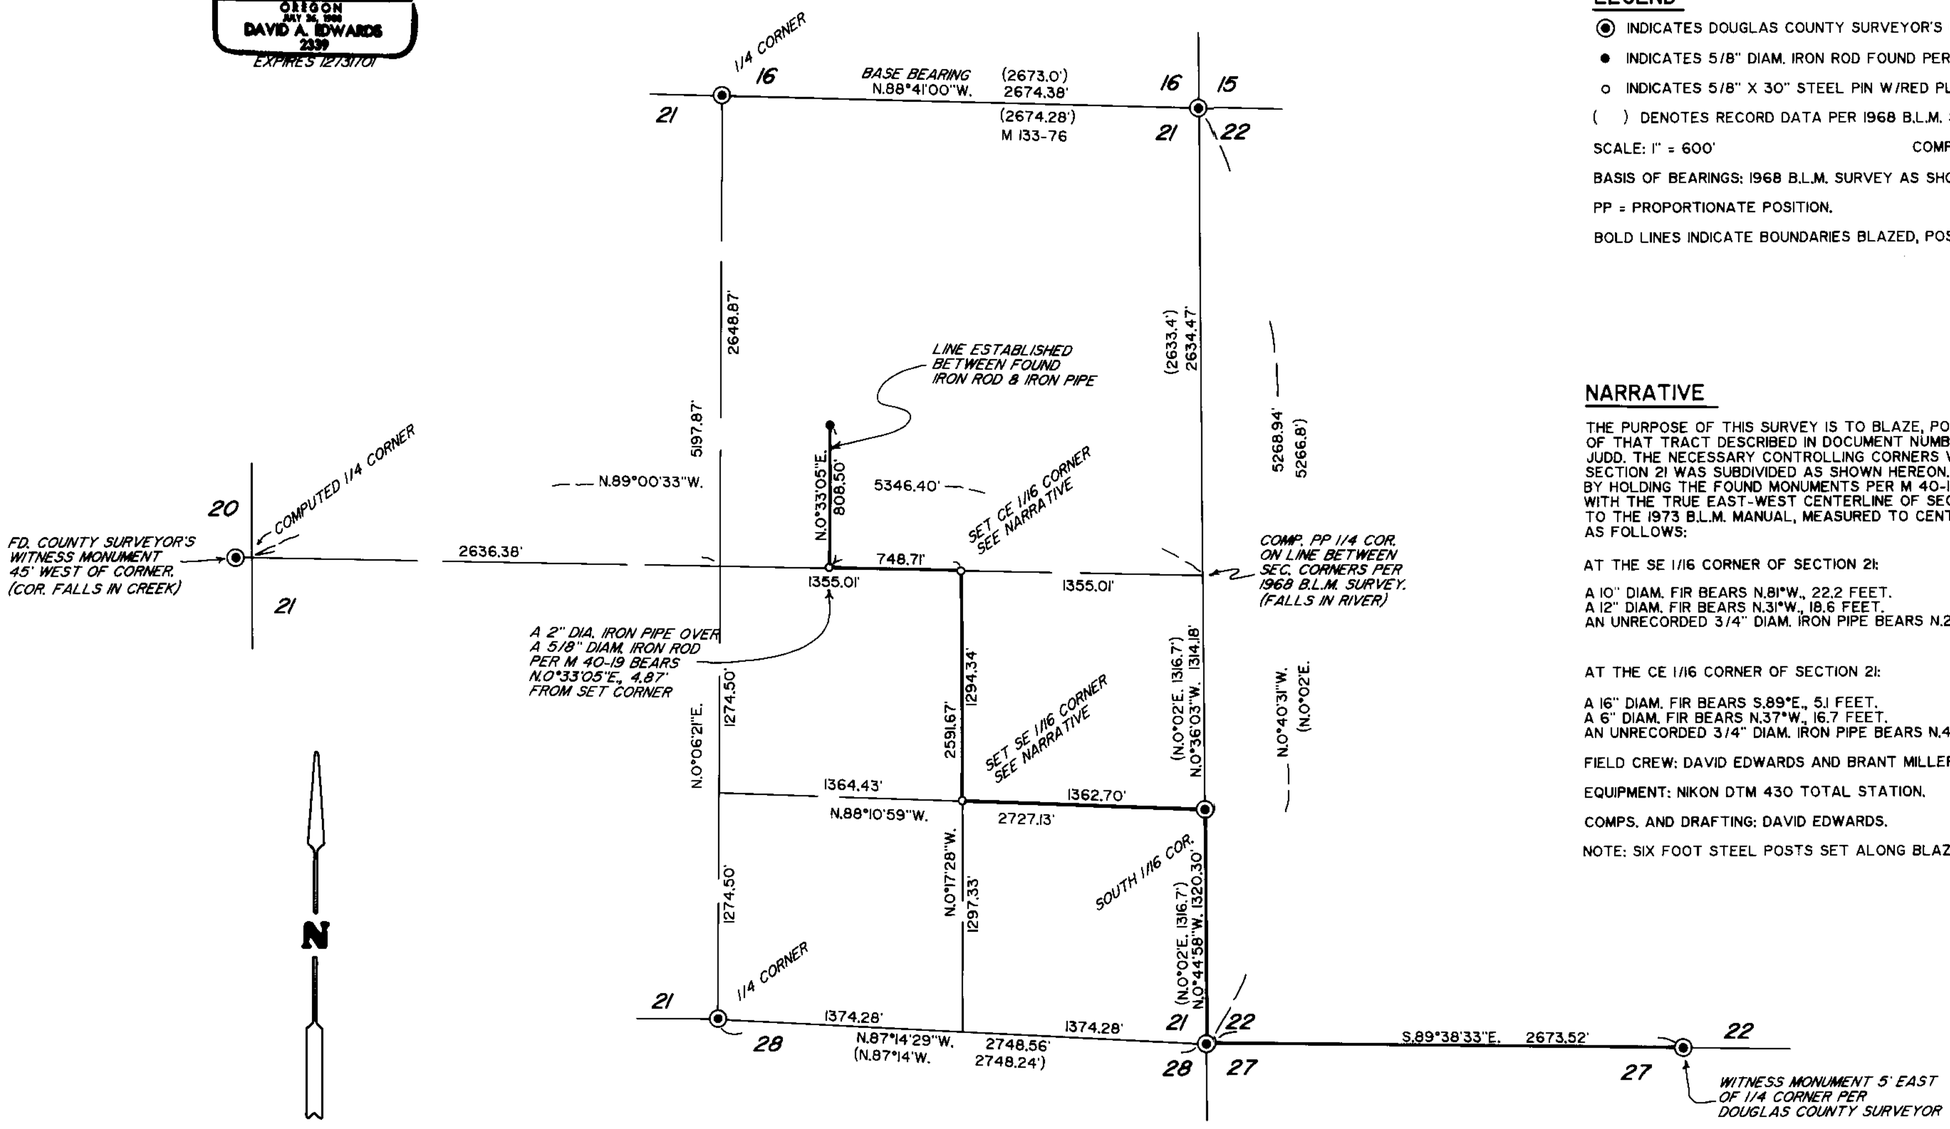

LEGEND

- ◉ INDICATES DOUGLAS COUNTY SURVEYOR'S OR B.L.M. BRASS CAP FOUND.
- ● INDICATES 5/8" DIAM. IRON ROD FOUND PER M 40-19.
- o INDICATES 5/8" X 30" STEEL PIN W/RED PLASTIC CAP MKD. "D.A. EDWARDS-L.S. 2339" SET.
- ( ) DENOTES RECORD DATA PER 1968 B.L.M. SURVEY EXCEPT WHERE NOTED.

SCALE: 1" = 600' COMP. = COMPUTED

BASIS OF BEARINGS: 1968 B.L.M. SURVEY AS SHOWN.

PP = PROPORTIONATE POSITION.

BOLD LINES INDICATE BOUNDARIES BLAZED, POSTED AND FLAGGED THIS SURVEY.

NARRATIVE

THE PURPOSE OF THIS SURVEY IS TO BLAZE, POST AND FLAG A PORTION OF THE BOUNDARIES OF THAT TRACT DESCRIBED IN DOCUMENT NUMBER 74-01116 BELONGING TO CLAYTON AND MYRNA JUDD. THE NECESSARY CONTROLLING CORNERS WERE TIED INTO AND THE SOUTHEAST QUARTER OF SECTION 21 WAS SUBDIVIDED AS SHOWN HEREON. THE MOST WESTERLY BOUNDARY WAS ESTABLISHED BY HOLDING THE FOUND MONUMENTS PER M 40-19 FOR LINE AND INTERSECTING SAID LINE SOUTHERLY WITH THE TRUE EAST-WEST CENTERLINE OF SECTION 21. BEARING TREES WERE SCRIBED ACCORDING TO THE 1973 B.L.M. MANUAL, MEASURED TO CENTER OF TREE AT LOWER BLAZE AND ARE SITUATED AS FOLLOWS:

AT THE SE 1/16 CORNER OF SECTION 21:

A 10" DIAM. FIR BEARS N.81°W., 22.2 FEET.
A 12" DIAM. FIR BEARS N.31°W., 18.6 FEET.
AN UNRECORDED 3/4" DIAM. IRON PIPE BEARS N.27°40'42"E., 6.40'

AT THE CE 1/16 CORNER OF SECTION 21:

A 16" DIAM. FIR BEARS S.89°E., 5.1 FEET.
A 6" DIAM. FIR BEARS N.37°W., 16.7 FEET.
AN UNRECORDED 3/4" DIAM. IRON PIPE BEARS N.49°03'20"W., 8.10'

FIELD CREW: DAVID EDWARDS AND BRANT MILLER.

EQUIPMENT: NIKON DTM 430 TOTAL STATION.

COMPS. AND DRAFTING: DAVID EDWARDS.

NOTE: SIX FOOT STEEL POSTS SET ALONG BLAZED LINES AT 200' INTERVALS.

MAP FILE M 138-39