BOUNDARY LINE SURVEY - LOCATED IN SECTION 2.
T.31S.. R.8W.. W.M.. DOUGLAS COUNTY. OREGON

FILED
Date: 2/15/2002 By: JP
This survey consists of:
Map: M139-47
Narrative:
Corner Rpt:
DOUGLAS COUNTY SURVEYOR

MAP FILE M139-47

SURVEY FOR:

SENECA JONES TIMBER COMPANY
P.O. BOX 2129
ROSEBURG. OR 97470

SURVEY BY:

MULKINS & RAMBO. LLC
P.O. BOX 809
NORTH BEND. OR 97459

REGISTERED PROFESSIONAL LAND SURVEYOR
Troy Rambo
OREGON
JULY 14.1998
TROY J. RAMBO
2865
RENEWAL 12-31-2002

SCALE 1" = 600'
JANUARY 15. 2002

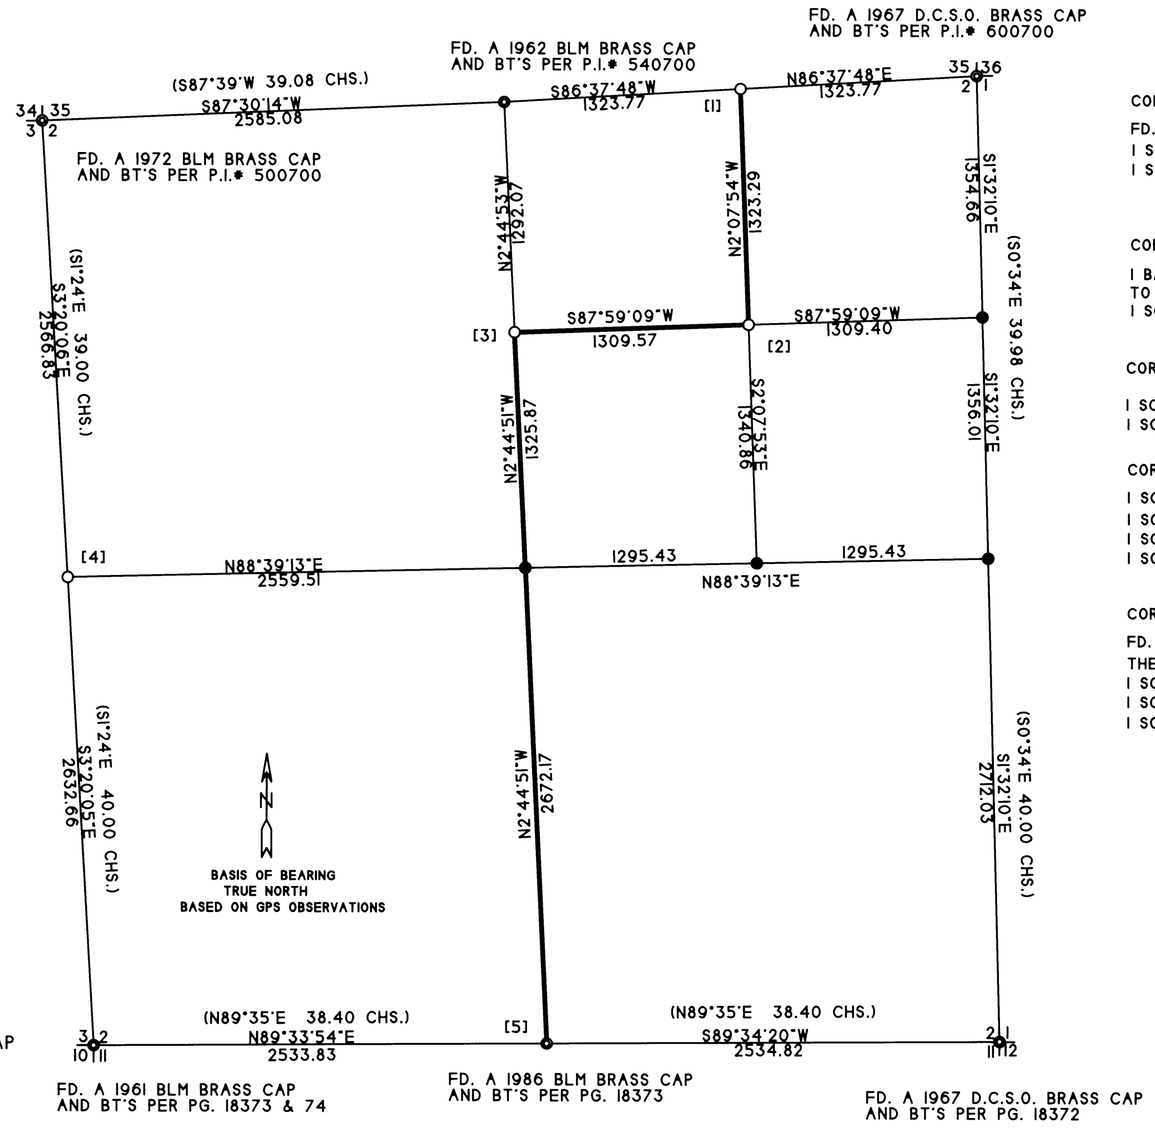

LEGEND

- ⊙ FD. CORNER AS SHOWN
- ○ SET A 5/8" X 36" REBAR WITH A 2 1/2" ALUM. CAP
- ● CALCULATED POSITION
- ——— LINE POSTED WITH 5 1/2'FENCE POSTS(MAXIMUM SPACING - 200') FLAGGED AND BLAZED
- ( ) RECORD BEARING/DISTANCE
- [ ] CORNER REFERENCE NUMBER

CORNER NOTES

CORNER [1]:

FD. A 3/4" IRON PIPE(ORIGN UNKNOWN - BEARS N79°48'05"W. 14.71 FT.
1 SCRIBED "E1/16 S35 BT" ON AN 8" DF - BEARS N36°W. 13.5 FT.
1 SCRIBED "E1/16 S35 BT" ON A 12" DF - BEARS N80°E. 9.1 FT.

CORNER [2]:

1 BARK SCRIBED "NE1/16 BT" ON A 44" DF - BEARS S18°E. 16.5 FT.
TO A 6" SPIKE AT THE BASE OF THE SCRIBES.
1 SCRIBED "NE1/16 BT" ON A 9" DF - BEARS N43°E. 14.5 FT.

CORNER [3]:

1 SCRIBED "CN1/16 BT" ON AN 18" DF - BEARS N35°E. 13.8 FT.
1 SCRIBED "CN1/16 BT" ON A 10" DF - BEARS S69°E. 27.5 FT.

CORNER [4]:

1 SCRIBED "1/4 S3 BT" ON A 12" DF - BEARS N33°W. 28.5 FT.
1 SCRIBED "1/4 S2 BT" ON AN 11" DF - BEARS N44°E. 7.1 FT.
1 SCRIBED "1/4 S2 BT" ON A 9" DF - BEARS S84°E. 23.0 FT.
1 SCRIBED "1/4 S3 BT" ON A 7" DF - BEARS S25°W. 15.9 FT.

CORNER [5]:

FD. A 14" GF WITH A HEALED FACE - BEARS S2°E. 18 lks.
THE RECORD 6" DF BEARING N27°W. 23 1/2 lks. - DOWN
1 SCRIBED "1/4 S2 BT" ON AN 11" GF - BEARS N64°W. 27.4 FT..
1 SCRIBED "1/4 S2 BT" ON A 6" GF - BEARS N27°E. 28.1 FT.
1 SCRIBED "1/4 S11 BT" ON A 7" DF - BEARS S66°E. 11.0 FT.

NARRATIVE

THE PURPOSE OF THIS SURVEY WAS TO SET THE CORNERS AND MARK THE LINES AS SHOWN. CONTROL FOR THIS SURVEY WAS BASED ON: THE DEPENDENT RESURVEY OF A PORTION OF THE SOUTH BOUNDARY OF T.30S.. R.8W.. W.M.: DEPENDENT RESURVEY OF A PORTION OF THE SUBDIVISIONAL LINES. T.31S.. R.8W.. W.M.: POINT IDENTIFIER NO. OF T.31S.. R.8W.. - #500700. #540700. & #600700.

THE EXTERIOR CORNERS OF THIS SECTION WERE TIED FROM GPS CONTROL POINTS. THE LINE TRAVERSE STARTED ON GPS CONTROL POINTS AND CLOSED ON GPS CONTROL POINTS.

A DILIGENT SEARCH WAS MADE FOR THE ORIGINAL 1/4 CORNER BETWEEN SECTION 2 AND 3. THE CORNER COULD NOT BE FOUND AND THEREFORE WAS RE-ESTABLISHED BY PROPORTIONATE MEASUREMENT. THE ORIGINAL E1/4 POSITION WAS NOT SEARCHED FOR. THE ORIGINAL BT'S FOR THIS CORNER WERE LAURELS AND THE POSITION FALLS IN A 15 YEAR OLD CLEARCUT.

ALL NEW BEARING TREES WERE MEASURED TO A 6" SPIKE AT SIDE CENTER BASE UNLESS OTHERWISE NOTED. BEARINGS WERE MEASURED WITH A HAND COMPASS WITH A DECL. OF 20°E.

THE FIELD WORK WAS PERFORMED BETWEEN JANUARY 2 AND JANUARY 15. 2002 BY TROY RAMBO AND BERNIE ALTENBACH.

MAP FILE M139-47