A SURVEY FOR
DOUGLAS COUNTY LUMBER CO.
LOCATED IN SECTION 2, T 25 S, R 4 W, W. M., DOUGLAS COUNTY, OREGON

FILED
Date: 4-17-2002 By: JC
This survey consists of:
Map: M139-73
Narrative:
Corner Rpt:
DOUGLAS COUNTY SURVEYOR

MAP FILE M139-73

LEGEND:
- ⊙ FOUND AS NOTED
- ● SET 5/8" X 30" IRON ROD/PLASTIC CAP MARKED "LANG SURVEYING"
- △ CALCULATED POINT
- ——— POSTED LINE
- ( ) ORIGINAL GLO RECORD UNLESS OTHERWISE NOTED
- [ ] RECORD PER VOLUME 2, PAGES 256-259
- { } RECORD PER INST. #79-05054

NARRATIVE:

THE PURPOSE OF THIS SURVEY IS TO MONUMENT THE NORTHERLY LINE OF PARCEL 2, LAND PARTITION #1999-0028 B AND TO SET THE SOUTH 1/16th CORNER BETWEEN SECTIONS 2 & 1; ALSO TO MONUMENT A PORTION OF THE AGREEMENT LINE AS SHOWN. IN ADDITION TO MONUMENTATION, THE BOUNDARY LINES INDICATED WERE MARKED WITH METAL POSTS & FLAGGING.

THE SOUTH 1/16th CORNER WAS SET BY SINGLE PROPORTION BETWEEN FOUND MONUMENTS. THE NORTH LINE OF PARCEL 2 OF LAND PARTITION #1999-0028 B WAS SET 99.81 FEET NORTHERLY OF THE NORTH LINE OF THE SOUTH 1/2 OF THE NE 1/4 OF SECTION 2. THE AGREEMENT LINE WAS TO SAVE FURTHER SEARCH OF ORIGINAL EVIDENCE AND ALSO FURTHER RETRACEMENT OF SURVEY VOLUME 2, PAGES 256-259.

EQUIP: NIKON DTM 420
FIELD CREW: G. LANG, T. LANG
COMPS: G. LANG
DRAFTING: L. LANG

SURVEYED BY:
GREGORY D. LANG
7550 WILLIS CREEK RD.
WINSTON, OREGON 97496
(541)679-5542

REGISTERED PROFESSIONAL LAND SURVEYOR
OREGON
JULY 16, 1987
GREGORY D. LANG
#2295

EXPIRES 12-31-2002
LS #2295

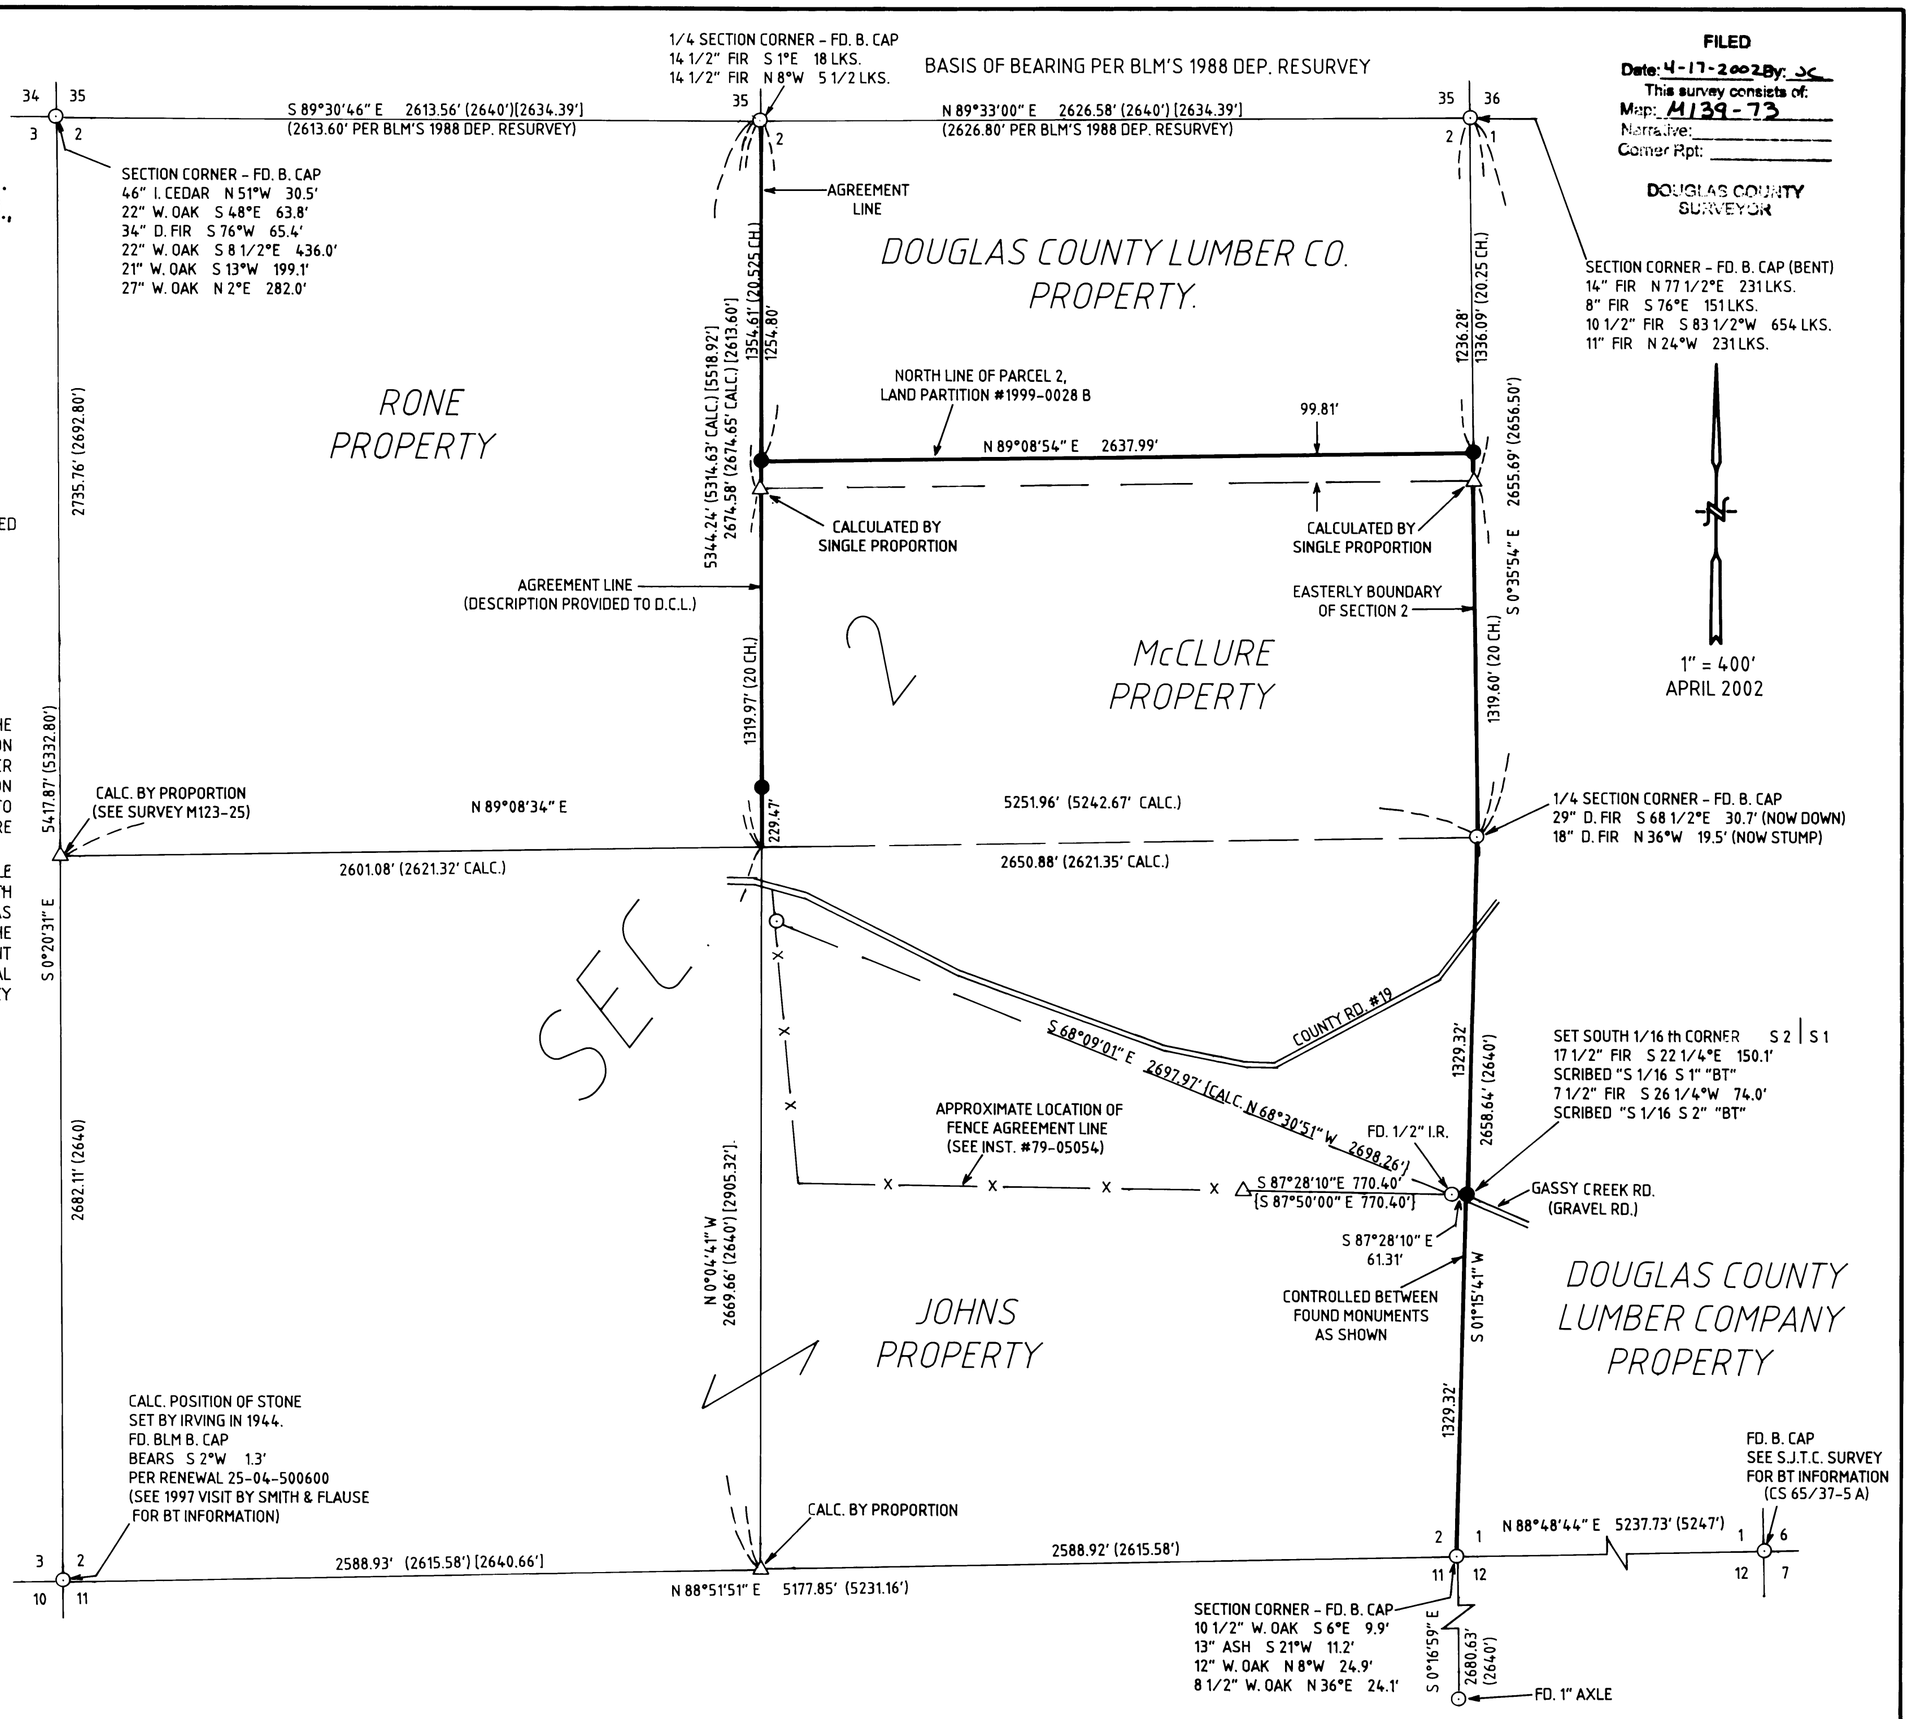

MAP FILE M139-73