MAP OF SURVEY

LOCATED in the SW 1/4 of Section 29, T. 29 S., R. 4 W., W.M. in Douglas County, Oregon.

March 22, 2002

FILED
Date: 4-19-2002 By: JC
This survey consists of:
Map: M139-75
Narrative:
Corner Rpt:

DOUGLAS COUNTY SURVEYOR

MAP FILE M139-75

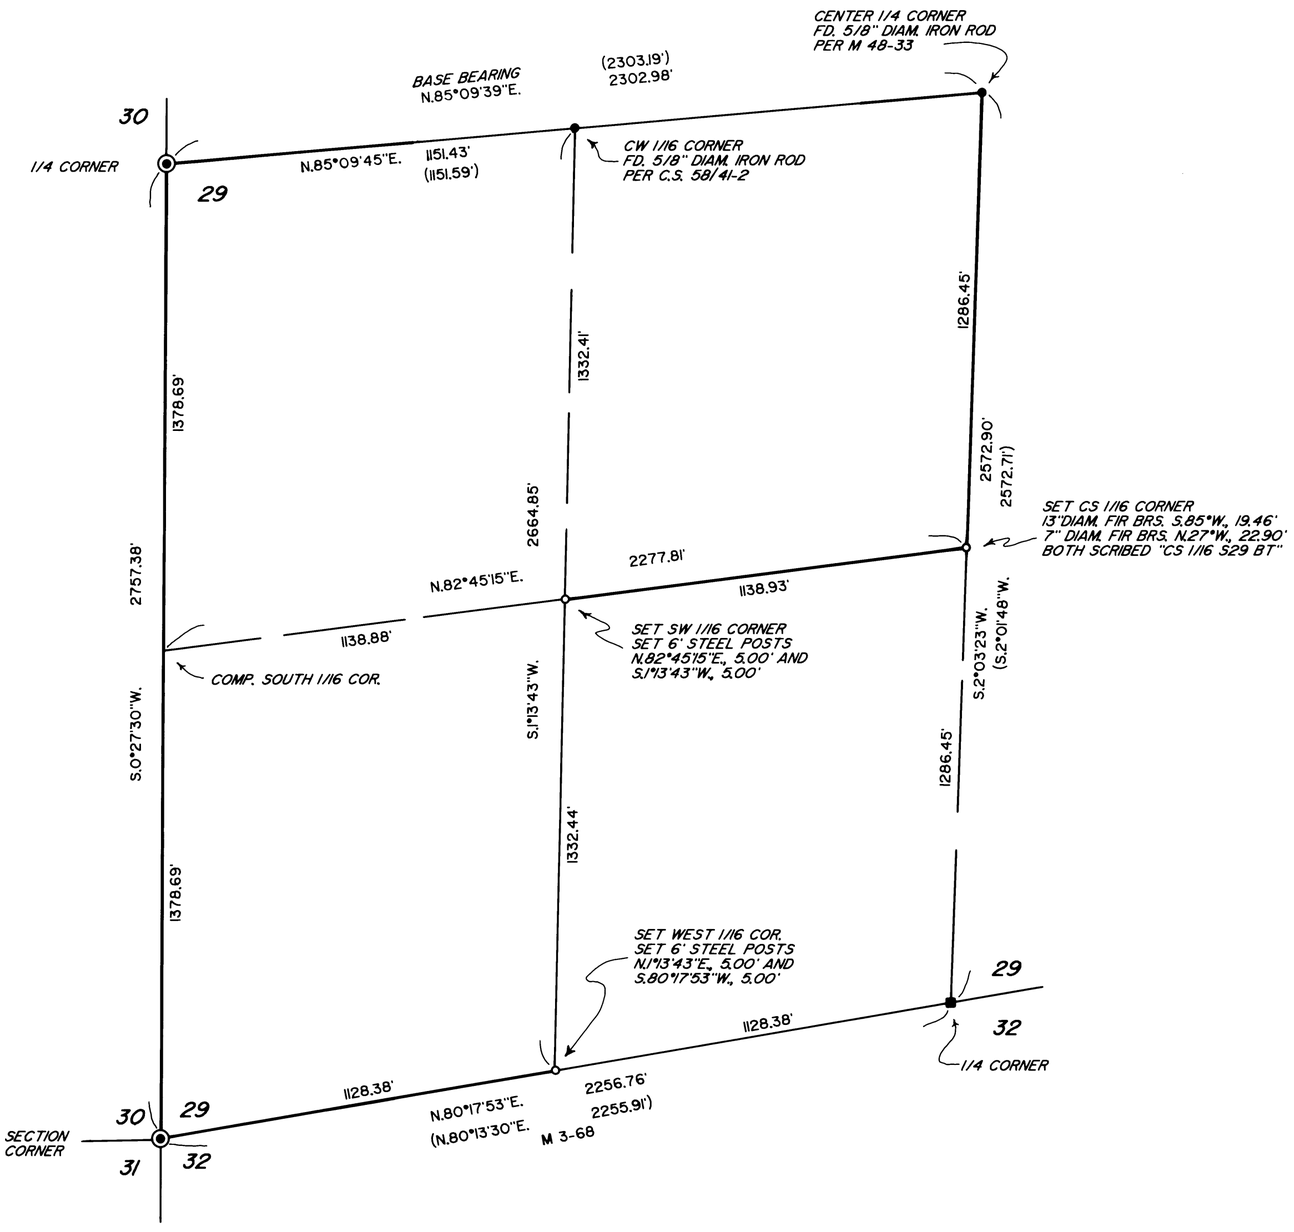

SURVEYED FOR: *OTTO T'HOOFT AND KEN SIAS*
5147 SOUTH MYRTLE ROAD
MYRTLE CREEK, OREGON

SURVEYED BY: *DAVID EDWARDS LAND SURVEYING*
P.O. BOX 361
OAKLAND, OREGON 97462
PHONE: (541) 459-0512

REGISTERED PROFESSIONAL LAND SURVEYOR
David A. Edwards
OREGON
JULY 24, 1998
DAVID A. EDWARDS
2339
EXPIRES 12/31/03

LEGEND

- ◉ INDICATES D.C.S. OR B.L.M. BRASS CAP FOUND.
- ■ INDICATES 3/4" DIAM. IRON PIPE FOUND PER M 3-68.
- ○ INDICATES 5/8" X 30" STEEL PIN W/RED PLASTIC CAP MKD. "D.A. EDWARDS-LS 2339" SET.
- ( ) DENOTES RECORD DATA PER M 48-33 EXCEPT WHERE. NOTED.
- ——— INDICATES LINE MKD. W/STEEL POSTS AND FLAGGING.

SCALE: 1" = 300' COMP. = COMPUTED.

BASIS OF BEARINGS: M 48-33 AS SHOWN.

NARRATIVE

THE PURPOSE OF THIS SURVEY IS TO MARK PORTIONS OF THE BOUNDARIES OF THE SIAS TRACT AS SHOWN HEREON. I HOLD TO THE FOUND MONUMENTS AND COMPUTE THE SUBDIVISION OF THE SW QUARTER AS SHOWN.

FIELD CREW: DAVID EDWARDS AND BRANT MILLER.

EQUIPMENT: NIKON DTM 430 TOTAL STATION.

COMPS. AND DRAFTING: DAVID EDWARDS.

MAP FILE M139-75