FILED
Date: 4-22-2002 By: K
This survey consists of:
Map: M139-77
Narrative:
Corner Rpt:

DOUGLAS COUNTY
SURVEYOR

MAP FILE M139-77

NARRATIVE:

THE PURPOSE OF THIS SURVEY WAS TO MONUMENT THE CORNERS OF THAT LAND DESCRIBED IN INSTRUMENT NO. 2001-09799, SAID DESCRIPTION BEING LOT 6 AND THE EASTERLY HALF OF LOT5, BLOCK 2, SLEEPY HOLLOW TRACTS. SLEEPY HOLLOW TRACTS BEING RECORDED IN VOLUME 6, PAGE 17 OF THE PLAT RECORDS OF DOUGLAS COUNTY, OREGON. THE SURVEY FILED AS M95-32 RECREATED BLOCKS ONE AND TWO OF SLEEPY HOLLOW TRACTS IN 1983. SOME OF THE MONUMENTS SHOWN IN M95-32 HAVE SINCE BEEN DESTROYED BUT LACKING ANY OTHER PERTINENT MONUMENTATION IN THIS AREA, BLOCK 2 WAS REPRODUCED AS CLOSELY AS POSSIBLE FROM THE MONUMENTS FOUND. LOTS WERE THEN PROPORTIONED BETWEEN BLOCK CORNERS.

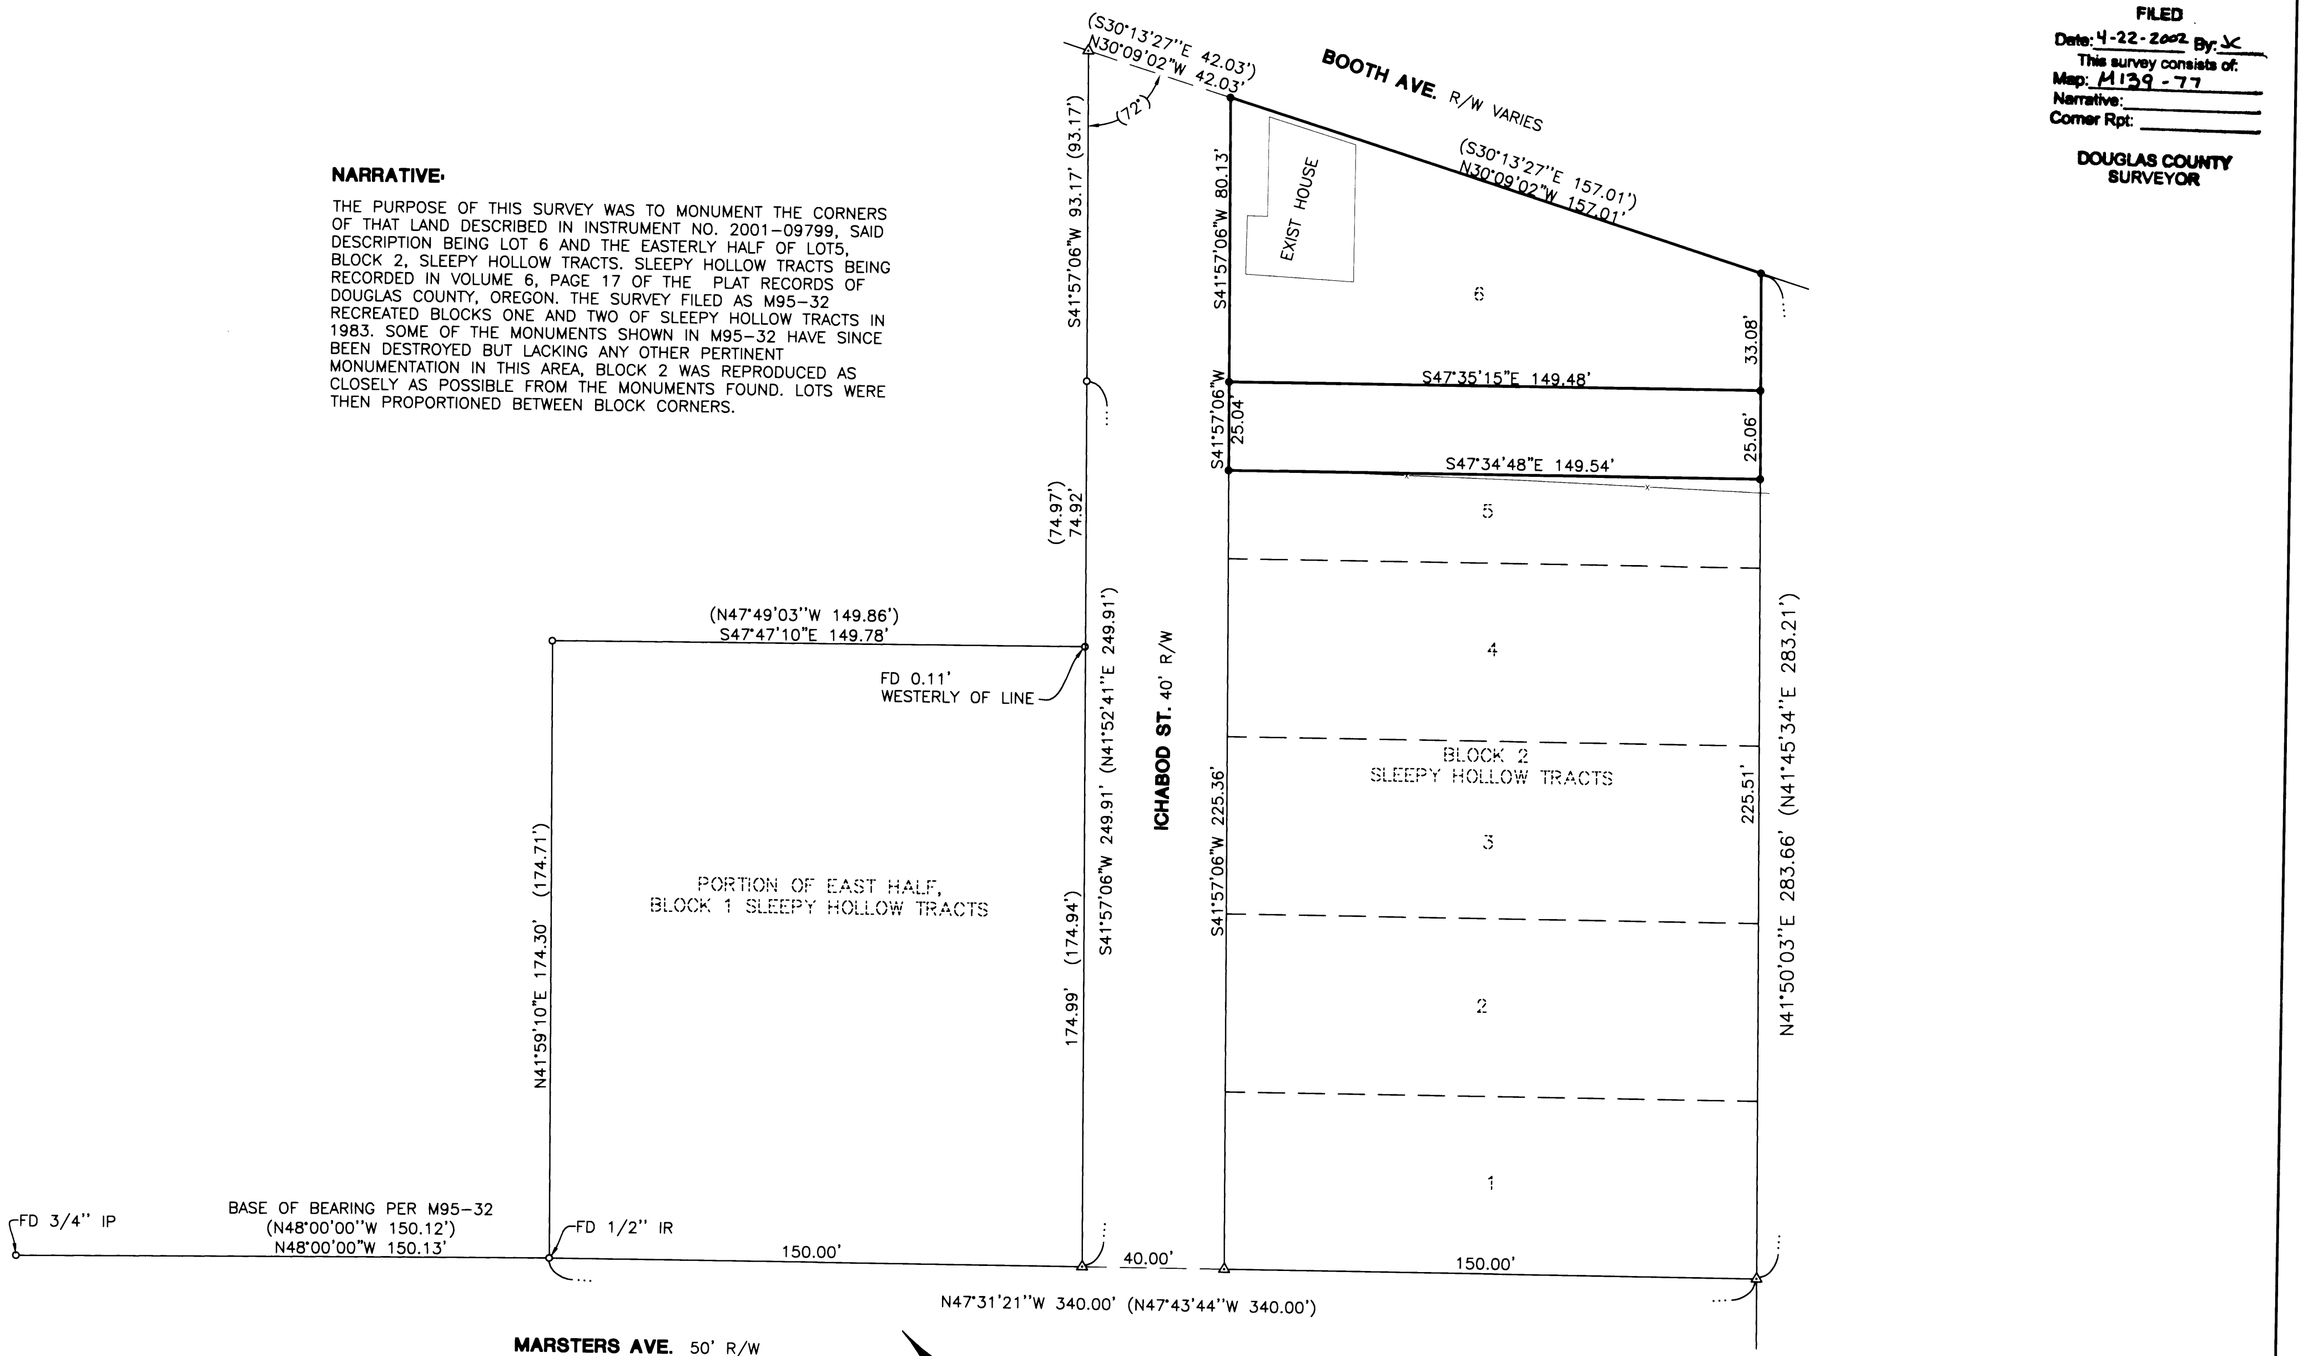

FIELD CREW: NEIL HIBBS & RYAN PALMER

EQUIPMENT: NIKON TOTAL STATION AND SDR 33 DATA COLLECTOR

OFFICE: NEIL HIBBS

DRAFTING: BRYAN CROSGROVE

LEGEND

- ● SET 5/8" x 30" IR w/CAP MARKED "I.E. ENG" UNLESS OTHERWISE NOTED
- ○ FOUND 1/2" IRON ROD w/BTS CAP UNLESS OTHERWISE NOTED
- △ CALCULATED POSITION
- ( ) RECORD AS PER M95-32

REGISTERED
PROFESSIONAL
LAND SURVEYOR

OREGON
JANUARY 12, 1999
F.NEIL HIBBS
52989

EXPIRES: 6/30/2003

SURVEY

LYING IN THE NE 1/4 OF SEC 25, T27S, R6W, AND THE NW 1/4 OF SEC 30, T27S, R5W, W.M., DOUGLAS COUNTY, OREGON

SURVEYED FOR:
RICHARD AND CAROLE GREATHOUSE
1819 SE ICHABOD ST.
ROSEBURG, OR. 97470

SURVEYED BY:
i.e. ENGINEERING
741 S.E. Jackson Street
Roseburg, Oregon 97470
PHONE (541) 673-0166
FAX (541) 440-9392

SCALE: 1"=30' | DATE: MARCH, 2002 | DWG. BY: BWC | JOB NO: 1853-01 | PAGE: 1 OF 1

MAP FILE M139-77