PLAT OF SURVEY

LOCATED IN

S 1/2, SE 1/4 SEC. 22, T 32 S, R 6 W, WM

DOUGLAS COUNTY, OREGON

OCT. 31, 2001

FILED
Date: 11/19/2001 By: JP
This survey consists of: 2 Pgs.
Map: M139-8A
Narrative:
Corner Rpt:

DOUGLAS COUNTY
SURVEYOR

REGISTERED
PROFESSIONAL
LAND SURVEYOR

OREGON
JULY 25, 1995
RAYMOND W. WYTCHERLEY
2724

EXPIRES JUNE 30, 2002

MAP FILE M139-8A

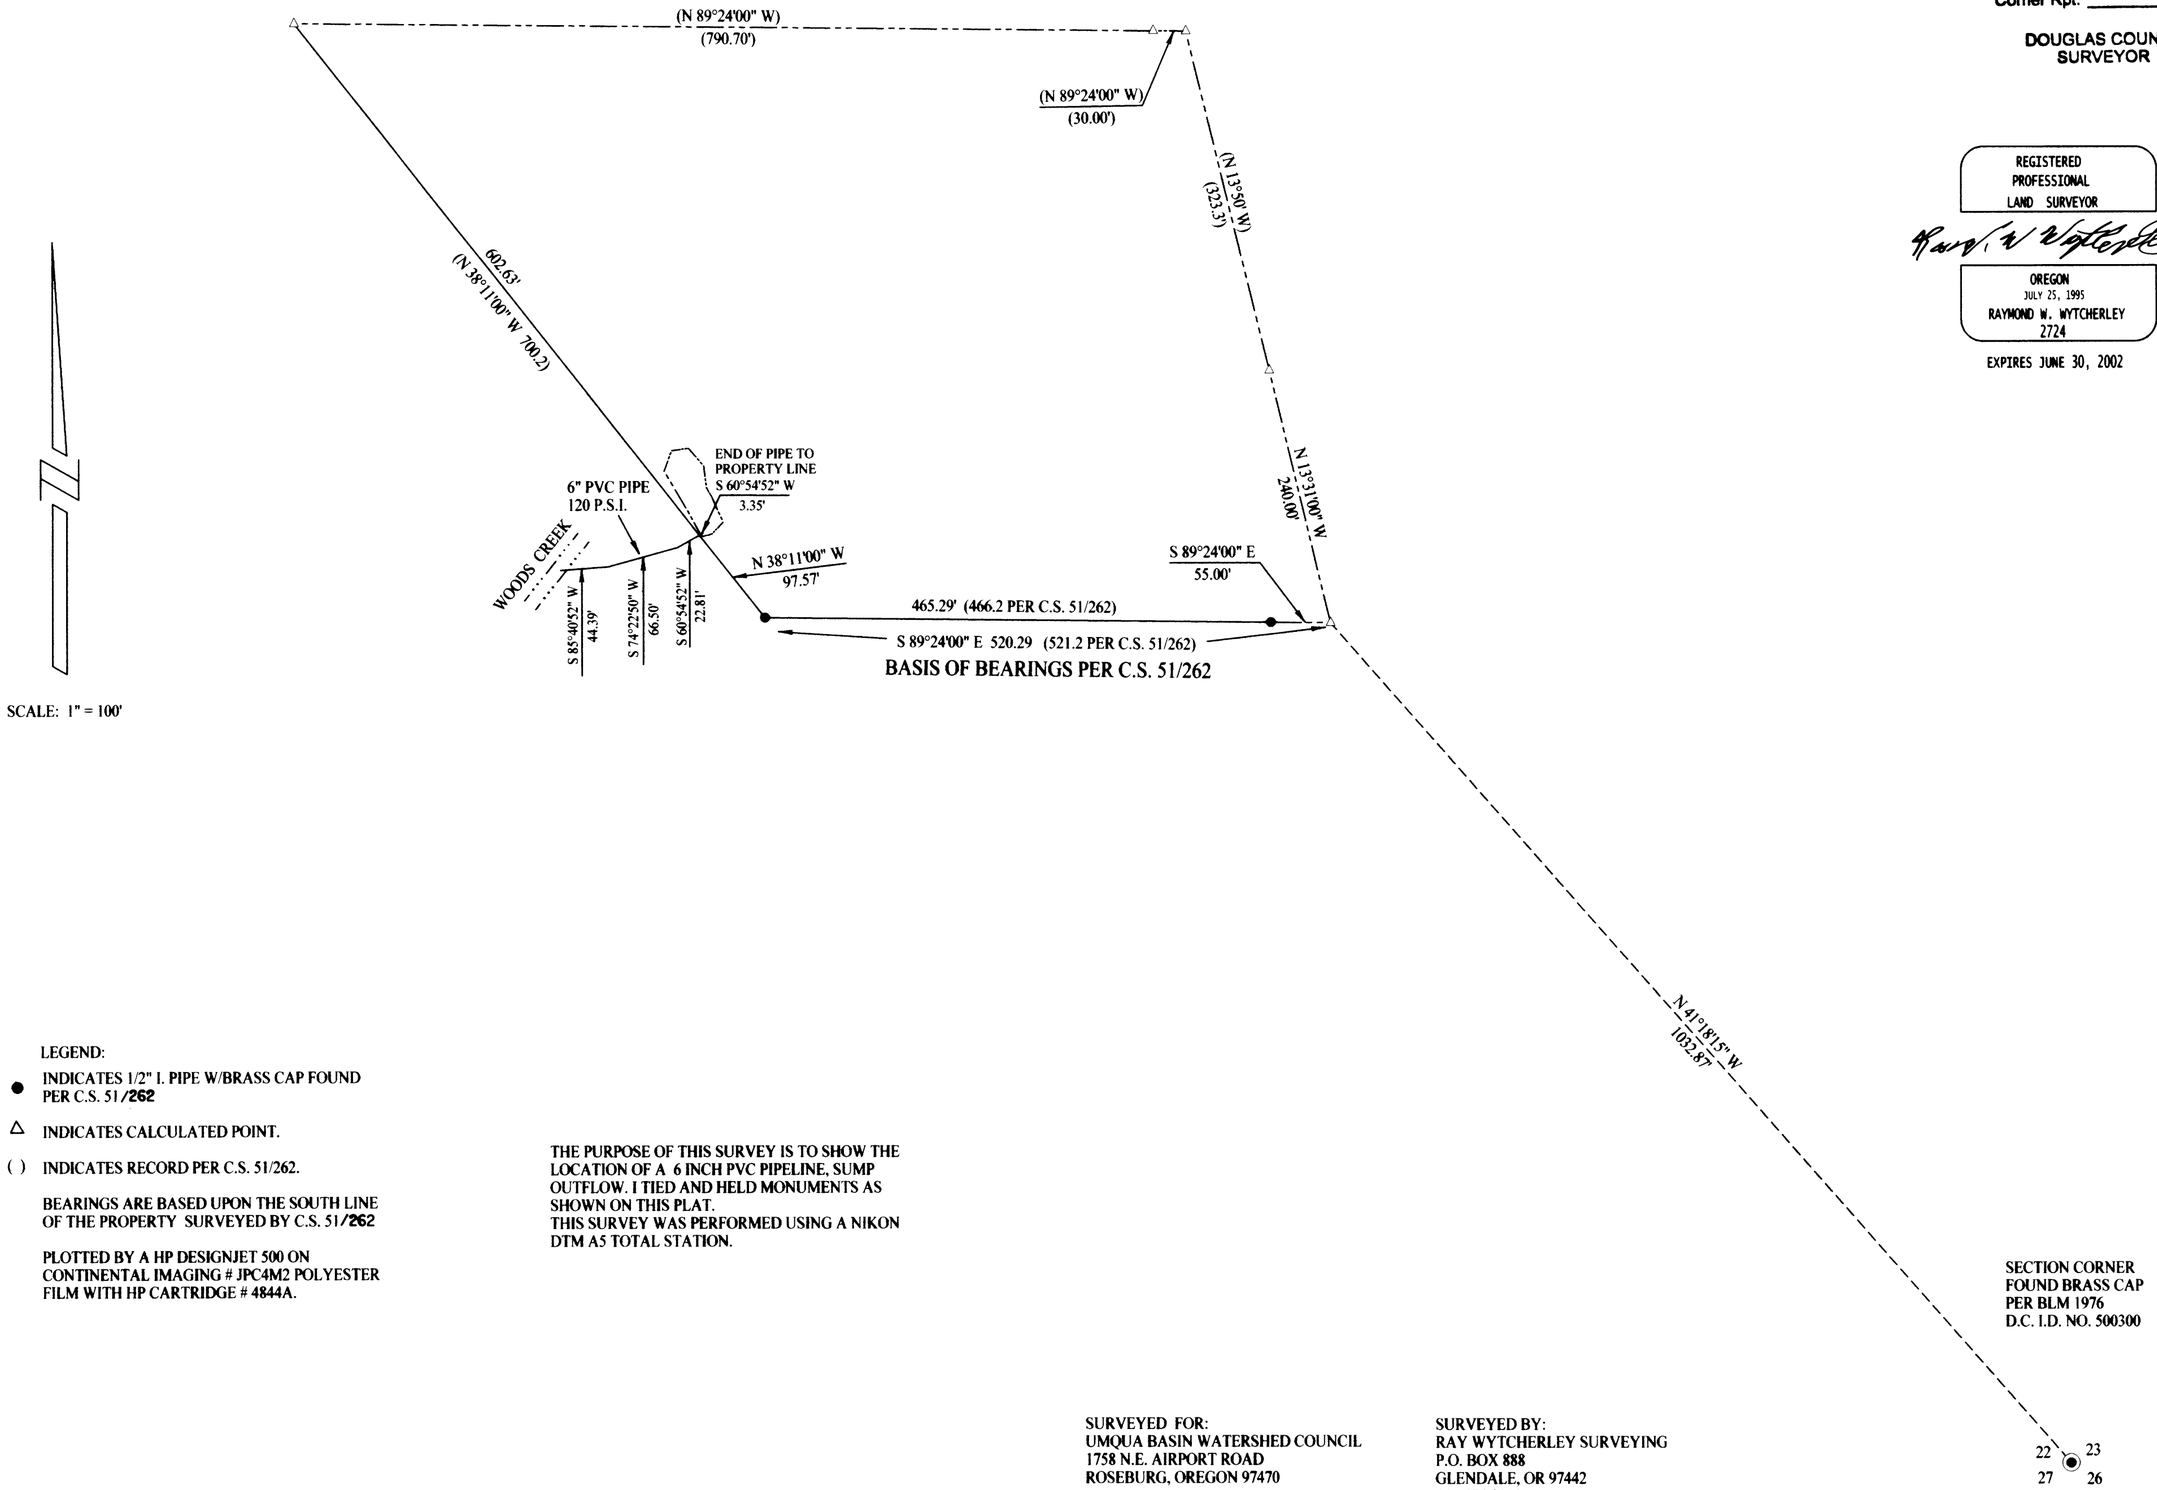

SCALE: 1" = 100'

LEGEND:

- ● INDICATES 1/2" I. PIPE W/BRASS CAP FOUND PER C.S. 51/262
- △ INDICATES CALCULATED POINT.
- ( ) INDICATES RECORD PER C.S. 51/262.

BEARINGS ARE BASED UPON THE SOUTH LINE OF THE PROPERTY SURVEYED BY C.S. 51/262

PLOTTED BY A HP DESIGNJET 500 ON CONTINENTAL IMAGING # JPC4M2 POLYESTER FILM WITH HP CARTRIDGE # 4844A.

THE PURPOSE OF THIS SURVEY IS TO SHOW THE LOCATION OF A 6 INCH PVC PIPELINE, SUMP OUTFLOW. I TIED AND HELD MONUMENTS AS SHOWN ON THIS PLAT.
THIS SURVEY WAS PERFORMED USING A NIKON DTM A5 TOTAL STATION.

SURVEYED FOR:
UMQUA BASIN WATERSHED COUNCIL
1758 N.E. AIRPORT ROAD
ROSEBURG, OREGON 97470

SURVEYED BY:
RAY WYTCHERLEY SURVEYING
P.O. BOX 888
GLENDALE, OR 97442
541-476-3319

MAP FILE M139-8A