PROPERTY LINE ADJUSTMENT

MAP OF SURVEY

LOCATED in the SW 1/4 of Section 22, T. 26 S., R. 6 W., W.M. in Douglas County, Oregon.

FILED
Date: 5/7/2002 By: JP
This survey consists of:
Map: M140-4
Narrative:
Corner Rpt:
DOUGLAS COUNTY SURVEYOR

MAP FILE M140-4

SURVEYED BY: *DAVID EDWARDS LAND SURVEYING*
P.O. BOX 361
OAKLAND, OREGON 97462
PHONE: (541) 459-0512

April 29, 2002

REGISTERED PROFESSIONAL LAND SURVEYOR
David A. Edwards
OREGON
JULY 26, 1988
DAVID A. EDWARDS
2339
EXPIRES 12/31/03

SURVEYED FOR: *BRAD AND TERRY ALBERTUS*
452 COUNTRY HILL DRIVE
ROSEBURG, OREGON

APPROVAL

Keith L. Cubic 5/7/02
DOUGLAS COUNTY PLANNING DIRECTOR DATE

FILE NUMBER: 02-M008

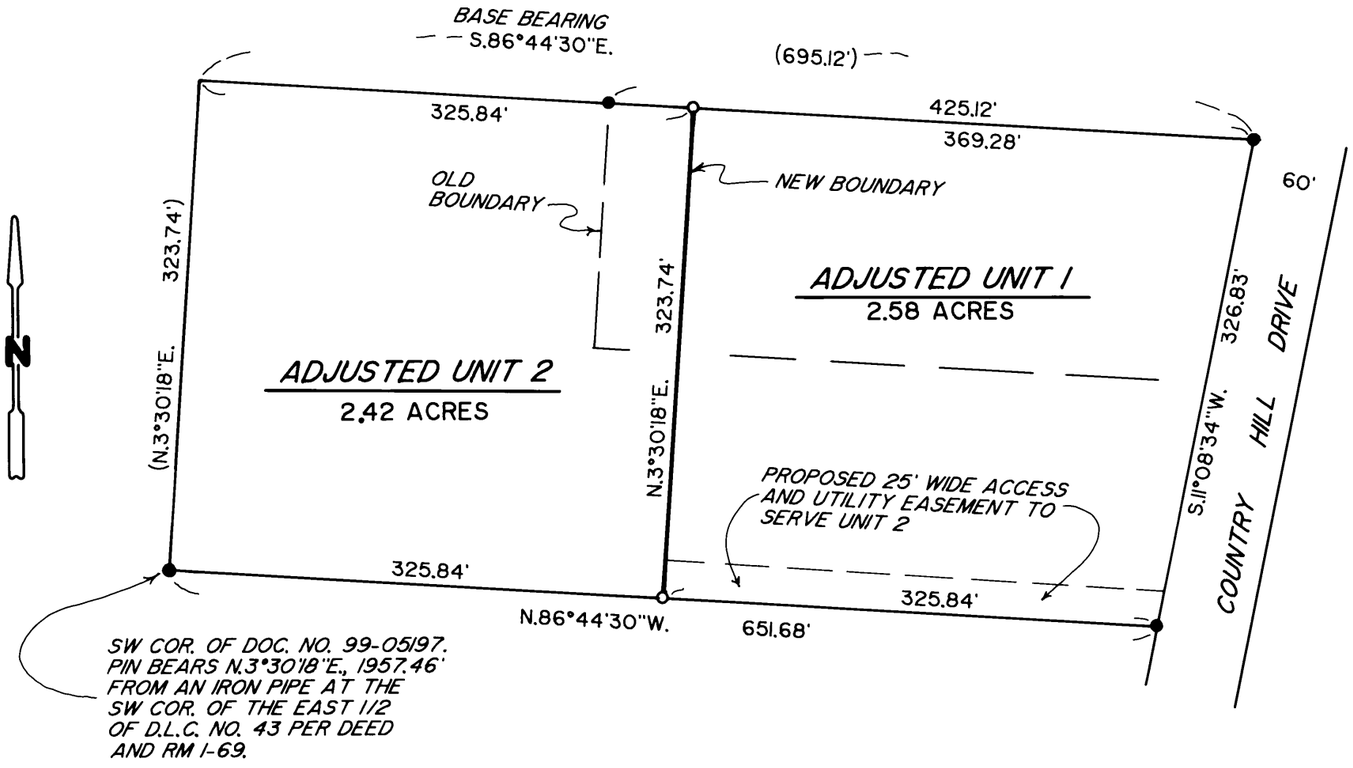

LEGEND

- ● INDICATES 5/8" DIAM. IRON ROD FOUND.
- o INDICATES 5/8" X 30" STEEL PIN W/RED PLASTIC CAP MKD. "D.A. EDWARDS-LS 2339" SET.

( ) DENOTES RECORD DATA PER C.S. 55/218-1

SCALE: 1" = 100'

BASIS OF BEARINGS: C.S. 55/218-1 AS SHOWN.

NARRATIVE

THE PURPOSE OF THIS SURVEY IS TO MONUMENT THE NEW BOUNDARY SHOWN HEREON AND TO PREPARE LEGAL DESCRIPTIONS FOR THE TWO ADJUSTED UNITS. I HOLD TO THE FOUND MONUMENTS AND SET THE NEW LINE AS SHOWN.

FIELD CREW: DAVID EDWARDS AND BRANT MILLER.

EQUIPMENT: NIKON DTM 430 TOTAL STATION.

COMPS. AND DRAFTING: DAVID EDWARDS.

MAP FILE M140-4