A SURVEY FOR J. C. WALKER

LOCATED IN THE NE 1/4 OF SECTION 20, T 27 S, R 5 W, W. M., DOUGLAS COUNTY, OREGON

FILED
Date: 2/21/2003 By: JP
This survey consists of:
Map: M141-62
Name(s): _____
Corner Rpt: _____
DOUGLAS COUNTY SURVEYOR

MAP FILE M141-62

LEGEND:

- ⊙ FOUND 5/8" IRON ROD UNLESS OTHERWISE NOTED
- ● SET 5/8" X 30" IRON ROD/ PLASTIC CAP MARKED "LANG SURVEYING"
- ( ) RECORD AS NOTED
- [ ] RECORD PER 1998-0122
- { } RECORD PER TODD BLDG. CO. SUBD. NO. 3, VOL. 5 PG. 79
- x—x FENCE

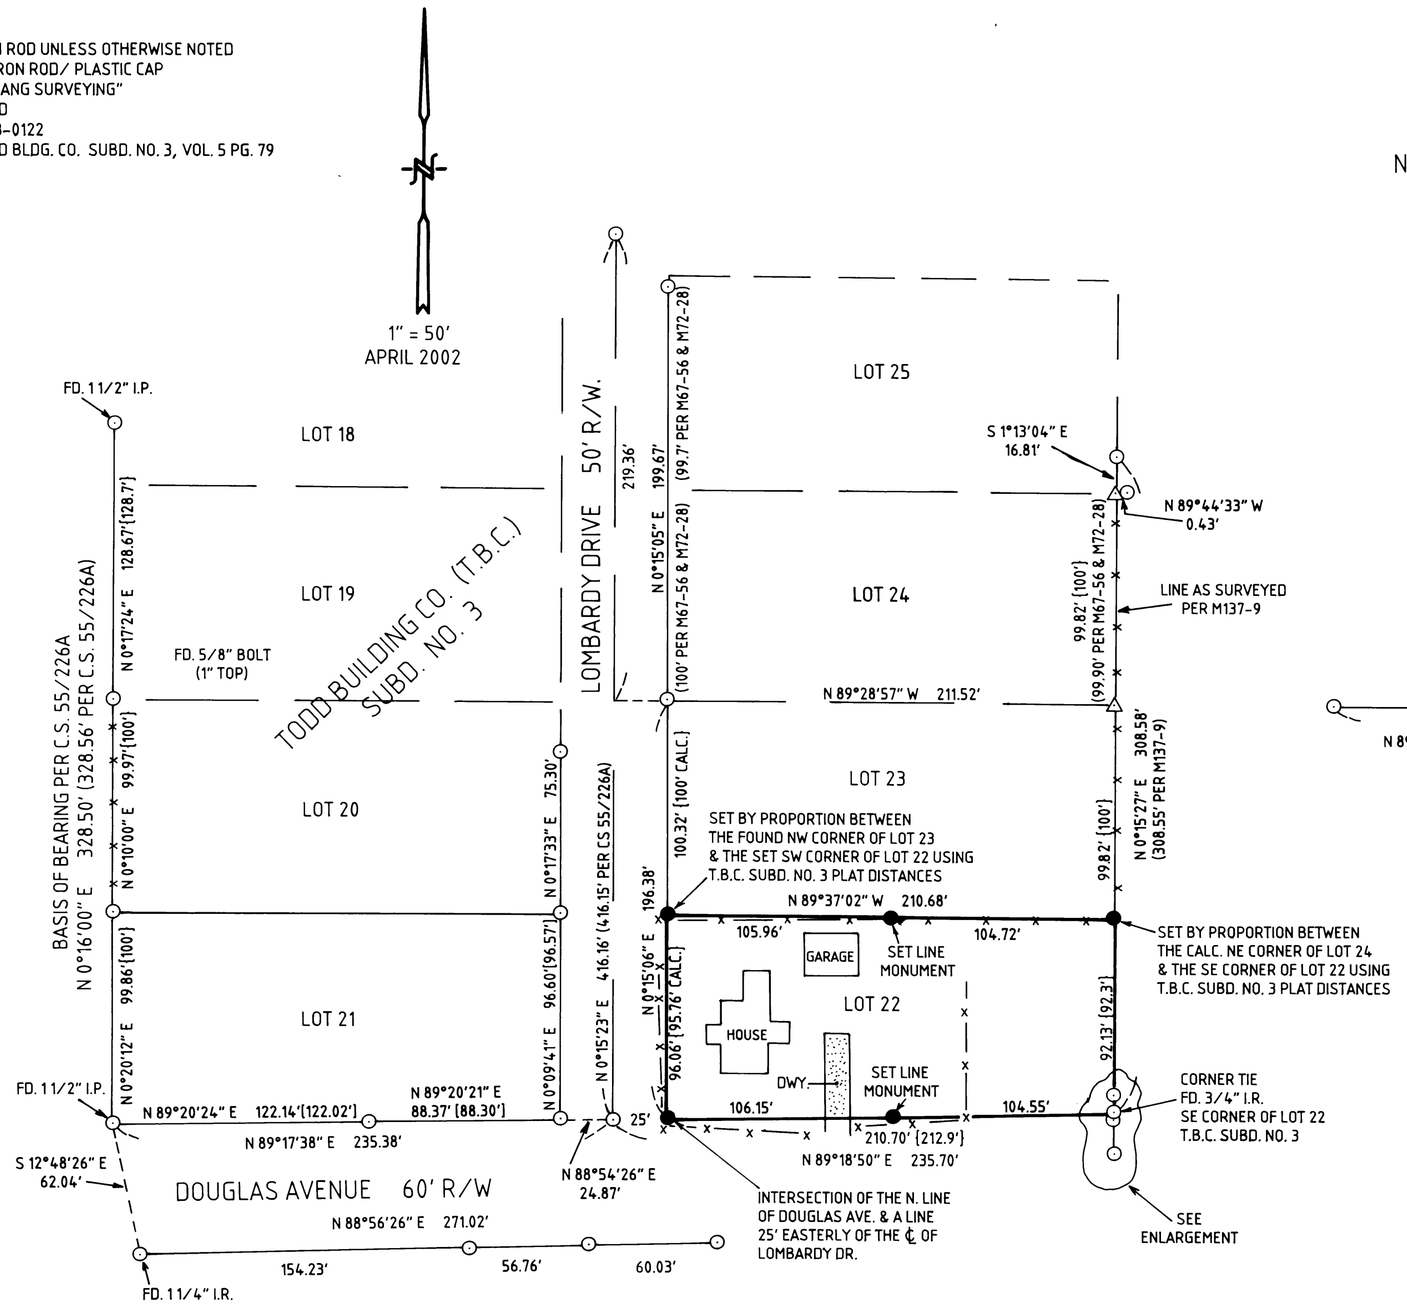

ENLARGEMENT
1" = 20'

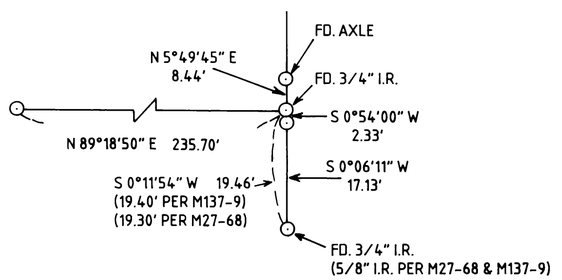

NARRATIVE:

THE PURPOSE OF THIS SURVEY IS FOR BOUNDARY LOCATION AND MONUMENTATION.

NEW MONUMENTS WERE ESTABLISHED AS NOTED HEREON.

EQUIP: NIKON DTM 420
FIELD CREW: G. LANG, T. LANG
COMPS: G. LANG
DRAFTING: L. LANG

SURVEYED BY:
GREGORY D. LANG
7550 WILLIS CREEK RD.
WINSTON, OREGON 97496
(541) 679-5542

REGISTERED PROFESSIONAL LAND SURVEYOR
OREGON
JULY 16, 1987
GREGORY D. LANG
#2295

L.S. #2295
EXPIRES 12-31-2002

MAP FILE M141-62