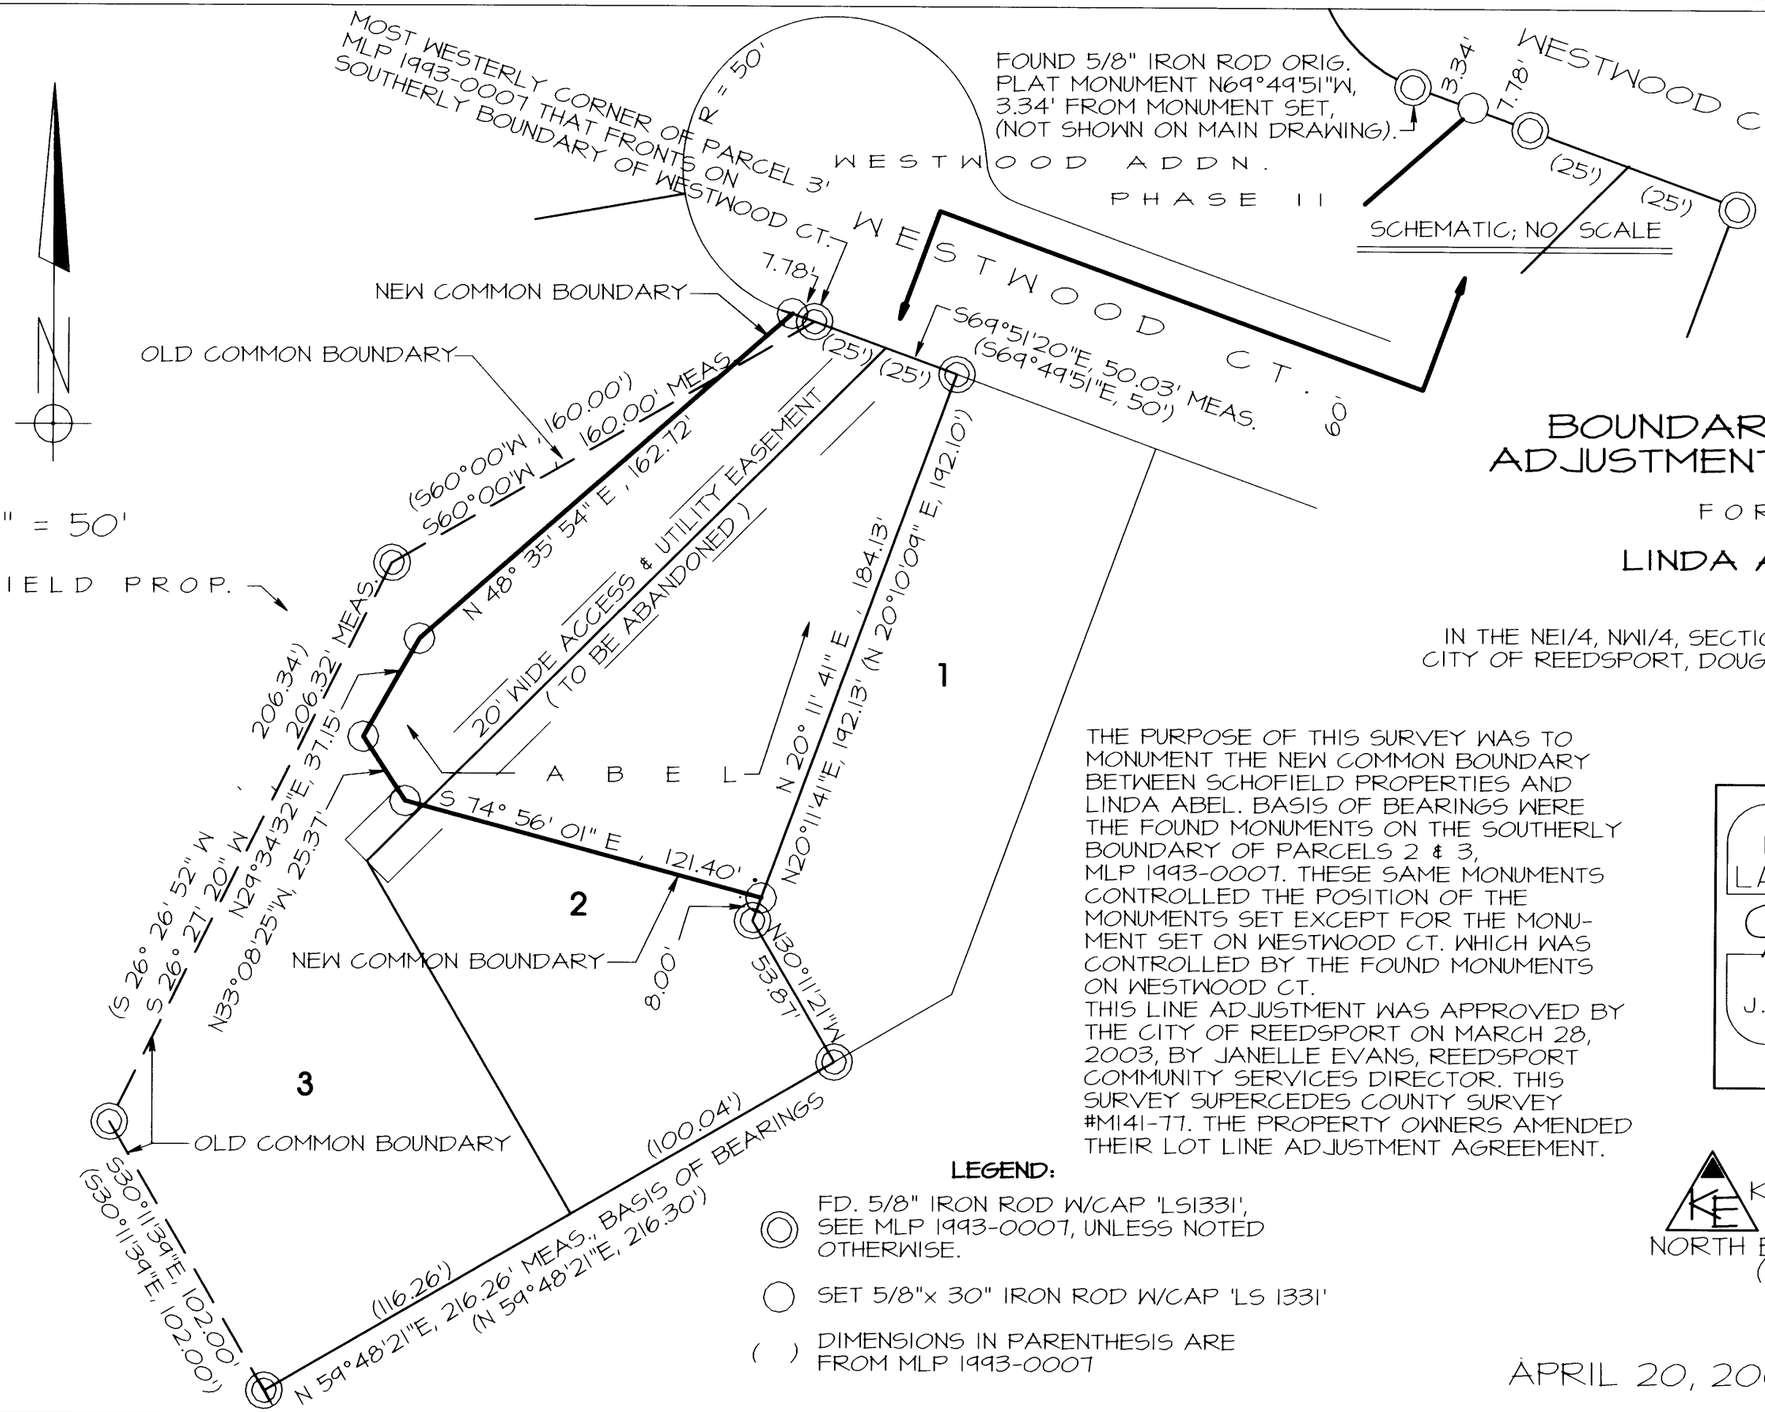

FILED
Date: 4/28/2003 By: JP
This survey consists of:
Map: M 142-7
Narrative:
Corner Rpt:
DOUGLAS COUNTY SURVEYOR

COUNTY SURVEYOR

BOUNDARY LINE ADJUSTMENT SURVEY

FOR

LINDA ABEL

IN THE NE1/4, NW1/4, SECTION 4, T22S, R12WWM, CITY OF REEDSPORT, DOUGLAS COUNTY, OREGON.,

THE PURPOSE OF THIS SURVEY WAS TO MONUMENT THE NEW COMMON BOUNDARY BETWEEN SCHOFIELD PROPERTIES AND LINDA ABEL. BASIS OF BEARINGS WERE THE FOUND MONUMENTS ON THE SOUTHERLY BOUNDARY OF PARCELS 2 & 3, MLP 1993-0007. THESE SAME MONUMENTS CONTROLLED THE POSITION OF THE MONUMENTS SET EXCEPT FOR THE MONUMENT SET ON WESTWOOD CT. WHICH WAS CONTROLLED BY THE FOUND MONUMENTS ON WESTWOOD CT.
THIS LINE ADJUSTMENT WAS APPROVED BY THE CITY OF REEDSPORT ON MARCH 28, 2003, BY JANELLE EVANS, REEDSPORT COMMUNITY SERVICES DIRECTOR. THIS SURVEY SUPERCEDES COUNTY SURVEY #M141-77. THE PROPERTY OWNERS AMENDED THEIR LOT LINE ADJUSTMENT AGREEMENT.

REGISTERED PROFESSIONAL LAND SURVEYOR

OREGON
SEPTEMBER 23, 1977
J. GREGORY SOLARZ
1331

EXPIRES: 6/04

LEGEND:

- ◎ FD. 5/8" IRON ROD W/CAP 'LS1331', SEE MLP 1993-0007, UNLESS NOTED OTHERWISE.
- ○ SET 5/8"x 30" IRON ROD W/CAP 'LS 1331'
- ( ) DIMENSIONS IN PARENTHESIS ARE FROM MLP 1993-0007

KOOS ENGINEERING
2656 STANTON
NORTH BEND, OREGON 97459
(541)756-4419

APRIL 20, 2003 KE2691B

MAP FILE M142-7

MAP FILE M142-7