FILED
Date: 9-29-2004 By: NW
This survey consists of:
Map: M 145-49
Narrative:
Corner Rpt:
DOUGLAS COUNTY SURVEYOR

MAP FILE M 145-49

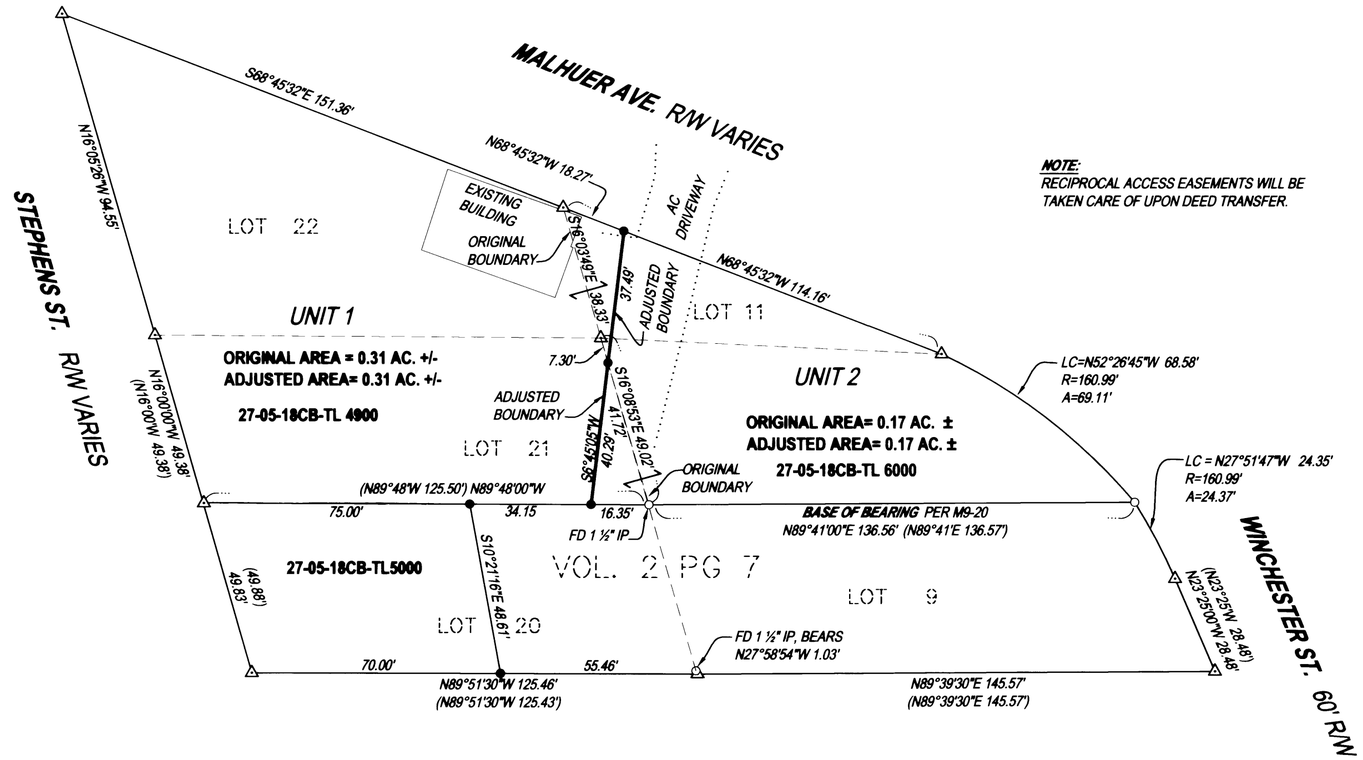

NOTE:
RECIPROCAL ACCESS EASEMENTS WILL BE TAKEN CARE OF UPON DEED TRANSFER.

LEGEND
- ○ FOUND 5/8" IRON ROD UNLESS OTHERWISE NOTED
- ● SET 5/8"x30" IRON ROD w/CAP STAMPED *"HIBBS-LS 52989"*
- △ CALCULATED POSITION
- ( ) RECORD PER M9-20

FIELD CREW: NEIL & ERIC HIBBS & WAYNE ROGERS
EQUIPMENT: NIKON NPL-350
OFFICE: NEIL HIBBS

ZONE: C3
COMP. PLAN: COMMERCIAL

NARRATIVE:
THE PURPOSE OF THIS SURVEY WAS TO ADJUST THE BOUNDARIES OF THE SUBJECT PROPERTIES AS SHOWN.

APPROVAL:

COMMUNITY DEVELOPMENT DIRECTOR — 9-29-04 DATE

2004-02355
LID RECORDING NO. 2004-02356

PLANNING DEPT. FILE NO. BLA-04-7

BOUNDARY LINE ADJUSTMENT

LYING IN THE SOUTHWEST 1/4 OF SECTION 18, T27S, R5W,
WILLAMETTE MERIDIAN, DOUGLAS COUNTY, OREGON

CLIENT:
MADDEN PROPERTIES LLC
720 EAST JACKSON ST.
MEDFORD, OREGON 97504

SURVEYOR:
NEIL HIBBS LAND SURVEYING, LLC
4739 LOOKINGGLASS ROAD
ROSEBURG, OREGON 97470
phone (541) 957-9303
fax (541) 957-9306
email: NeilHibbs@aol.com

REGISTERED PROFESSIONAL LAND SURVEYOR
OREGON
JANUARY 12, 1999
F.NEIL HIBBS
52989
EXPIRATION DATE
6/30/2005

DWG. SCALE: 1" = 30' | ***JOB #:*** 0248-01 | ***DWG. BY:*** FLB | ***PAGE:*** 1 OF 1 | ***DATE:*** AUGUST 2004

PRINTED BY: LB DRAFTING

MAP FILE M 145-49