MAP OF SURVEY

LOCATED in the South 1/2 of Section 30, T. 23 S., R. 6 W., W.M. in Douglas County, Oregon.

May 11, 2005

FILED
Date: 5-12-2005 By: JC
This survey consists of:
Map: M147-56
Number:
Corner(s):
DOUGLAS COUNTY SURVEYOR

MAP FILE M147-56

REGISTERED PROFESSIONAL LAND SURVEYOR
David A. Edwards
OREGON
JULY 29, 1994
DAVID A. EDWARDS
2339
RENEWS 12/31/05

SURVEYED FOR: *ROSEBURG RESOURCES CO.*
P.O. BOX 1088
ROSEBURG, OREGON

SURVEYED BY: *DAVID EDWARDS LAND SURVEYING*
P.O. BOX 361
OAKLAND, OREGON 97462
PHONE: (541) 459-0512

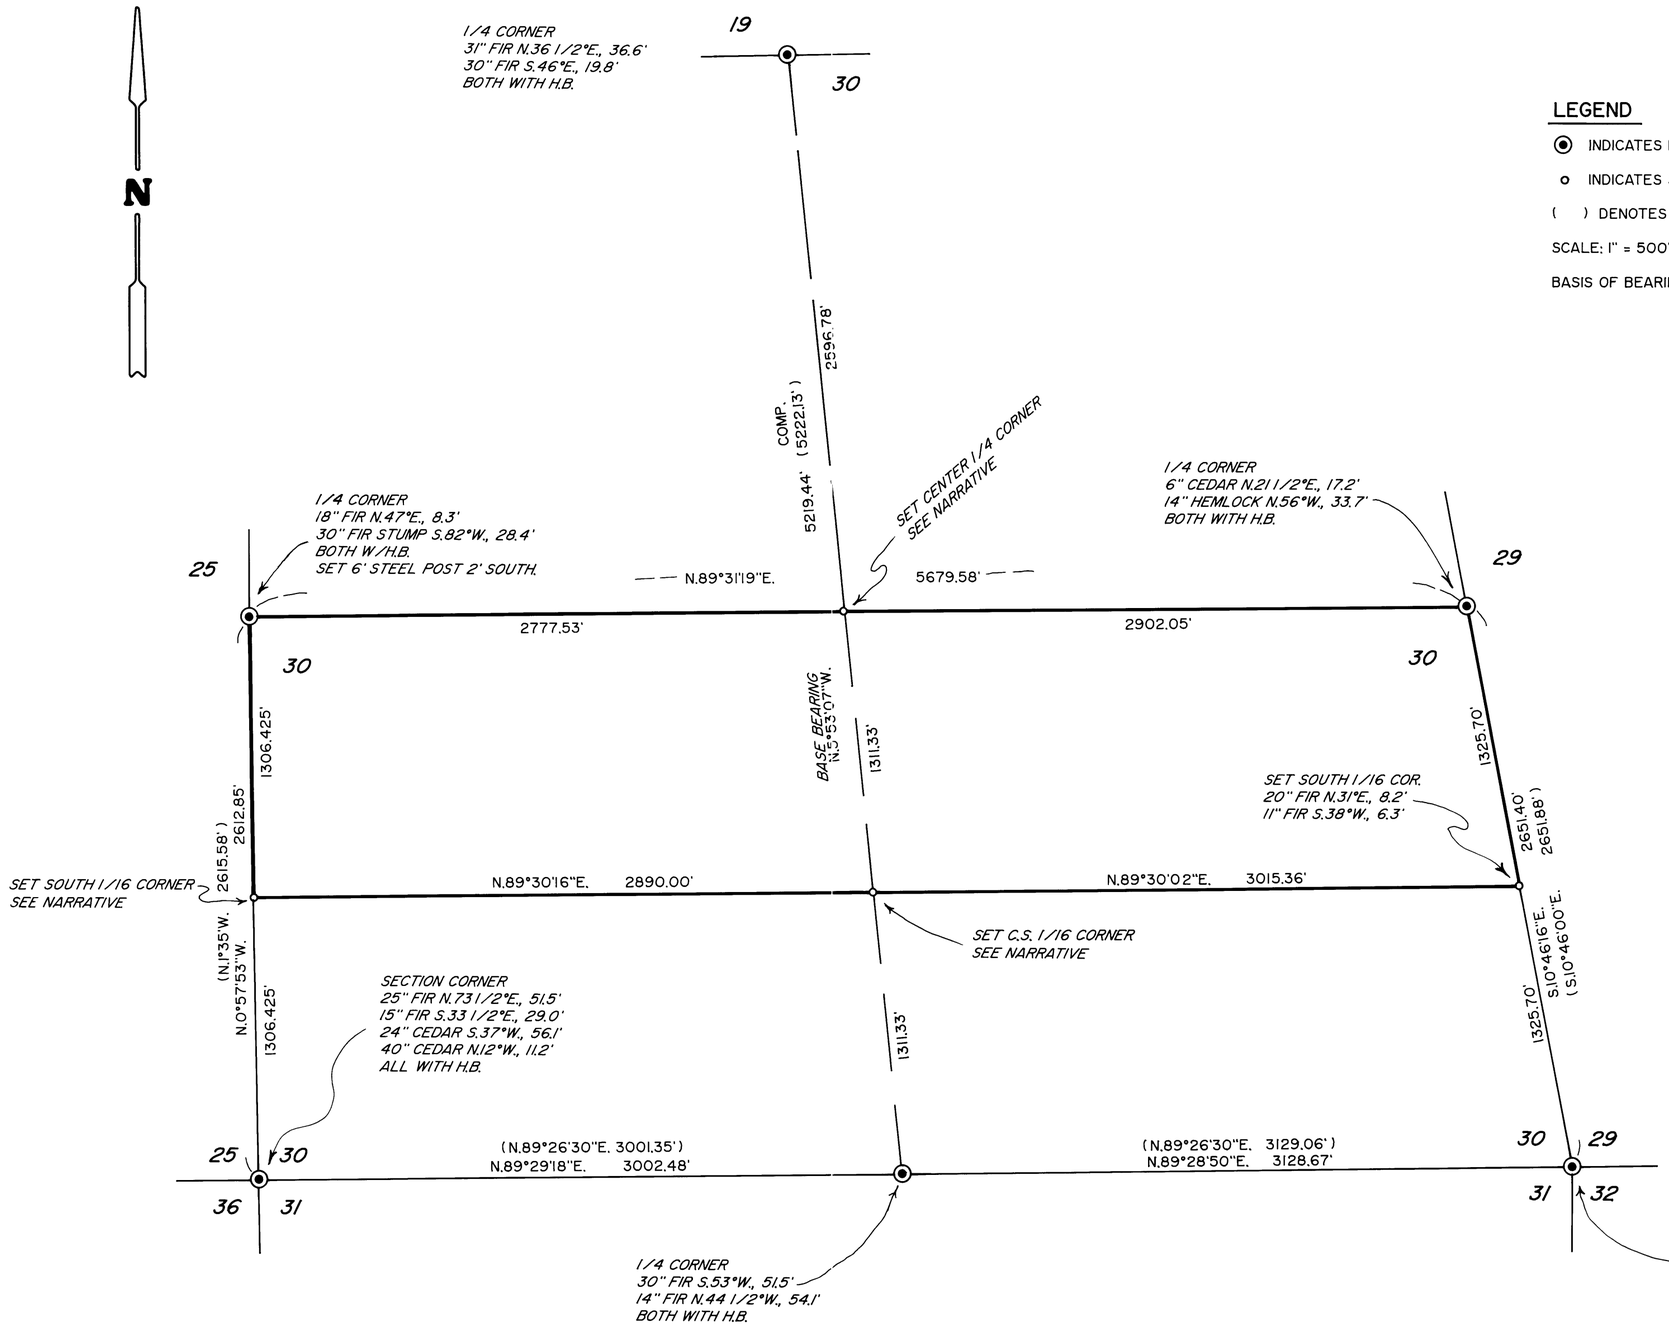

LEGEND

- ⊙ INDICATES B.L.M. BRASS CAP FOUND.
- o INDICATES 5/8" X 30" STEEL REBAR W/ALUM. CAP MKD. "ROSEBURG RESOURCES-LS 2339-2005" SET.
- ( ) DENOTES RECORD B.L.M. DATA. COMP. = COMPUTED.
- SCALE: 1" = 500' H.B. = HEALED BLAZE.
- BASIS OF BEARINGS: RECORD COMPUTED BEARING PER 1994 B.L.M. RESURVEY AS SHOWN.

NARRATIVE

THE PURPOSE OF THIS SURVEY IS TO LOCATE AND MARK THOSE BOUNDARIES SHOWN AS BOLD LINES HEREON AND TO SET THE NOTED CORNER MONUMENTS. CONTROL TRAVERSES WERE RUN WHICH TIED IN THE CONTROLLING MONUMENTS AND THE SECTION WAS SUBDIVIDED AS SHOWN.

EACH OF THE SUBJECT BOUNDARIES WERE MARKED BY BLAZING TREES ON EACH SIDE OF LINE AND BY HANGING RED FLAGGING LIBERALLY ALONG TRUE LINE. IN ADDITION, THE EAST LINE OF THE NE 1/4 OF THE SE 1/4 AND THE WEST LINE OF THE NW 1/4 OF THE SW 1/4 WERE MARKED WITH 6 FOOT STEEL POSTS AT INTERVALS OF 200 FEET OR LESS. CAPS SET ON THIS SURVEY ARE MARKED ACCORDING TO THE 1973 B.L.M. MANUAL. BEARING TREES ESTABLISHED ON THIS SURVEY ARE SCRIBED ACCORDING TO SAID MANUAL, MEASURED TO CENTER OF TREE AT ROOT CROWN AND ARE SITUATED AS SHOWN OR AS FOLLOWS:

AT THE CENTER 1/4 CORNER: A 7" FIR BEARS S.70°W., 22.3 FEET.
SET 6FOOT STEEL POSTS 2 FEET EAST AND 2 FEET WEST.

AT THE SOUTH 1/16 CORNER SECTIONS 30 AND 25:

A 6" FIR BEARS S.13°E., 13.35 FEET.
A 7" FIR BEARS N.73°W., 11.7 FEET.

AT THE CENTER-SOUTH 1/16 CORNER:

AN 8" FIR BEARS S.71°E., 10.3 FEET.
A 9" FIR BEARS S.15°W., 8.6 FEET.

FIELD CREW: BRANT MILLER AND ERIC SPRINKLE.

EQUIPMENT: NIKON TOTAL STATION.

COMPS. AND DRAFTING: DAVID EDWARDS.

MAP FILE M147-56