PROPERTY LINE ADJUSTMENT

MAP OF SURVEY

LOCATED in the NW 1/4 of Sec. 11 & the SW 1/4 of Sec. 2, T. 29 S., R. 8 W., W.M. in Douglas County, Oregon.

July 26, 2005

FILED
Date: 8-4-2005 By: JC
This survey consists of:
Map: M148-19
Narrative:
Corner Rpt:
DOUGLAS COUNTY SURVEYOR

MAP FILE M148-19

SURVEYED FOR: *SUZANNE AND MARTY PATROVSKY*
P.O. BOX 51
TENMILE, OREGON 97481

SURVEYED BY: *DAVID EDWARDS LAND SURVEYING*
P.O. BOX 361
OAKLAND, OREGON 97462
PHONE: (541) 459-0512

REGISTERED PROFESSIONAL LAND SURVEYOR
David A. Edwards
OREGON
JULY 24, 1986
DAVID A. EDWARDS
2339
RENEWS 12/31/05

APPROVAL FILE 04-M074.

Keith L. Cubic 8/2/05
DOUGLAS COUNTY PLANNING DIRECTOR DATE

LEGEND

- ● INDICATES 5/8" DIAM. STEEL PIN WITH CAP FOUND PER M 131-29.
- o INDICATES 5/8" X 30" STEEL REBAR W/RED PLASTIC CAP MKD. "D.A. EDWARDS-LS 2339" SET.
- ( ) DENOTES RECORD DATA PER M 131-29. COMP. = COMPUTED.

SCALE: 1" = 100'

BASIS OF BEARINGS: EXISTING CONTROL PER M 131-29.

NARRATIVE

THE PURPOSE OF THIS SURVEY IS TO LOCATE, MONUMENT AND DESCRIBE THE AREAS OF ADJUSTMENT SHOWN HEREON. EXISTING CONTROL POINTS AND DATA DETERMINED BY THIS OFFICE DURING THE EXECUTION OF M 131-29 WERE USED TO ACCOMPLISH THE WORK.

FIELD CREW: BRANT MILLER, ERIC SPRINKLE & GABE EDWARDS.

EQUIPMENT: NIKON TOTAL STATION.

COMPS. AND DRAFTING: DAVID EDWARDS.

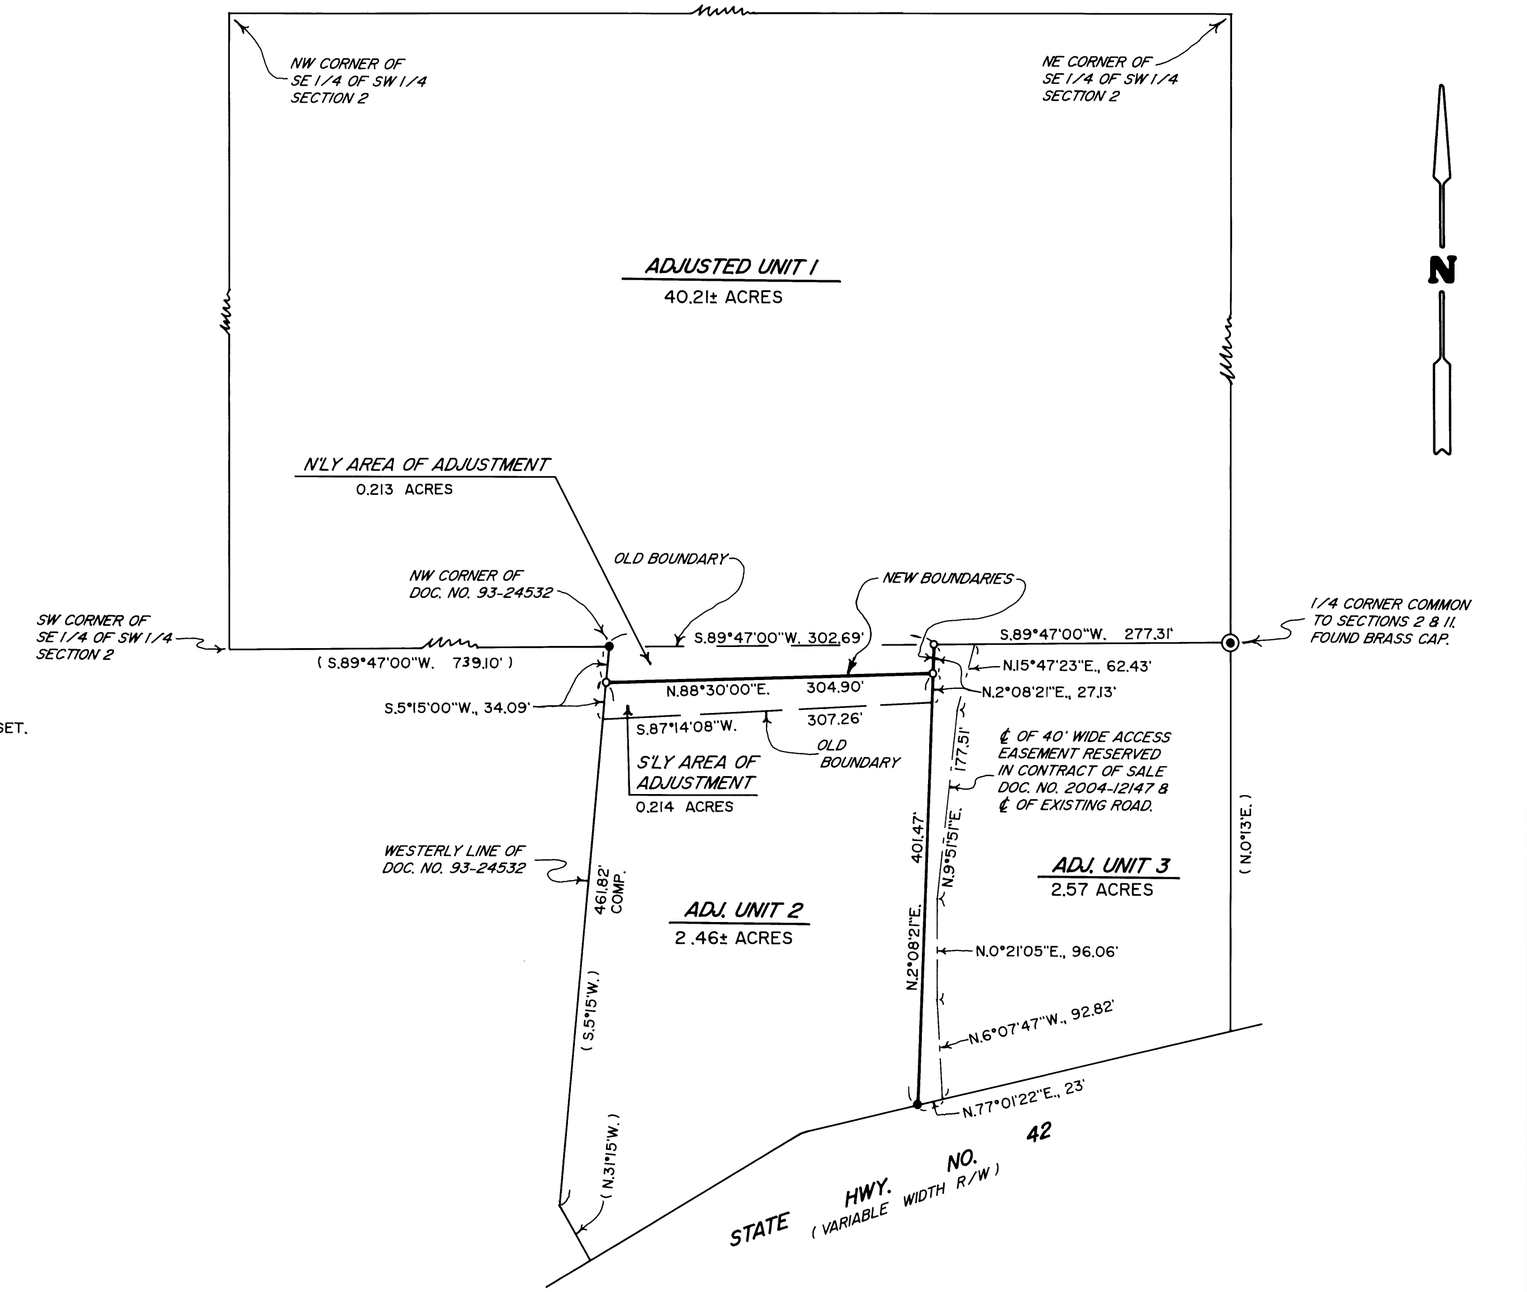

MAP FILE M148-19