MAP OF SURVEY

LOCATED in Section 23, T. 23 S., R. 5 W., W.M. in
Douglas County, Oregon.

September 9, 2005

FILED
Date: 9-13-2005 By: JC
This survey consists of:
Map: M148-40
Narrative:
Corner Rpt:
DOUGLAS COUNTY SURVEYOR

MAP FILE M148-40

SURVEYED FOR: *MADISON-JMK INC.*
1853 E. SIXTH AVE.
SUTHERLIN, OREGON 97479

AND

ROSEBURG RESOURCES CO.
P.O. BOX 1088
ROSEBURG, OREGON 97470

SURVEYED BY: *DAVID EDWARDS LAND SURVEYING*
P.O. BOX 361
OAKLAND, OREGON 97462
PHONE: (541) 459-0512

REGISTERED PROFESSIONAL LAND SURVEYOR
David A. Edwards
OREGON
JULY 24, 1998
DAVID A. EDWARDS
2339
RENEWS 12/31/05

LEGEND

- ◉ INDICATES DOUGLAS COUNTY SURVEYOR BRASS CAP FOUND.
- ■ INDICATES 5/8" DIAM. IRON ROD WITH CAP FOUND PER M 137-55.
- ▲ INDICATES DOUGLAS COUNTY SURVEYOR BRASS CAP FOUND AS A WITNESS MONUMENT.
- o INDICATES 5/8" X 30" STEEL REBAR W/RED PLASTIC CAP MKD. "D.A. EDWARDS-LS 2339" SET.
- ( ) DENOTES G.L.O. RECORD DATA UNLESS OTHERWISE NOTED.
- X——X——X FENCE LINE
- P.P. = PROPORTIONATE POSITION
- SCALE: 1" = 600'
- ——— INDICATES LINE POSTED AND BLAZED THIS SURVEY..

BASIS OF BEARINGS: ORIGINAL GENERAL LAND OFFICE SURVEY AS SHOWN.
RANDOM LINE BEARING PER ORIGINAL LINE NOTES.

NARRATIVE

THE PURPOSE OF THIS SURVEY IS TO MONUMENT THE 1/4 AND 1/16 CORNERS SHOWN HEREON AND TO MARK THOSE BOUNDARIES SHOWN AS A BOLD LINE. CONTROLLING MONUMENTS WERE TIED IN AND THE SUBDIVISION OF SECTION 23 COMPUTED. THE DESIRED BOUNDARIES WERE MARKED BY BLAZING TREES ON EACH SIDE OF LINE, BY SETTING 6 FOOT STEEL POSTS ALONG LINE AT INTERVALS OF 200' OR LESS AND BY HANGING LIBERAL AMOUNTS OF RED FLAGGING ALONG THE TRUE LINE. BEARING TREES FOR THE SET CORNERS WERE SCRIBED ACCORDING TO THE 1973 MANUAL AND MEASURED TO CENTER OF TREE AT ROOT CROWN.

AT THE NW 1/16 CORNER: A 5" FIR BEARS N.74°E., 9.1 FEET.
A 6" FIR BEARS S.12°E., 12.55 FEET.

FIELD CREW: BRANT MILLER, ERIC SPRINKLE AND CHRIS EDWARDS.

EQUIPMENT: NIKON TOTAL STATION.

COMPS. AND DRAFTING: DAVID EDWARDS.

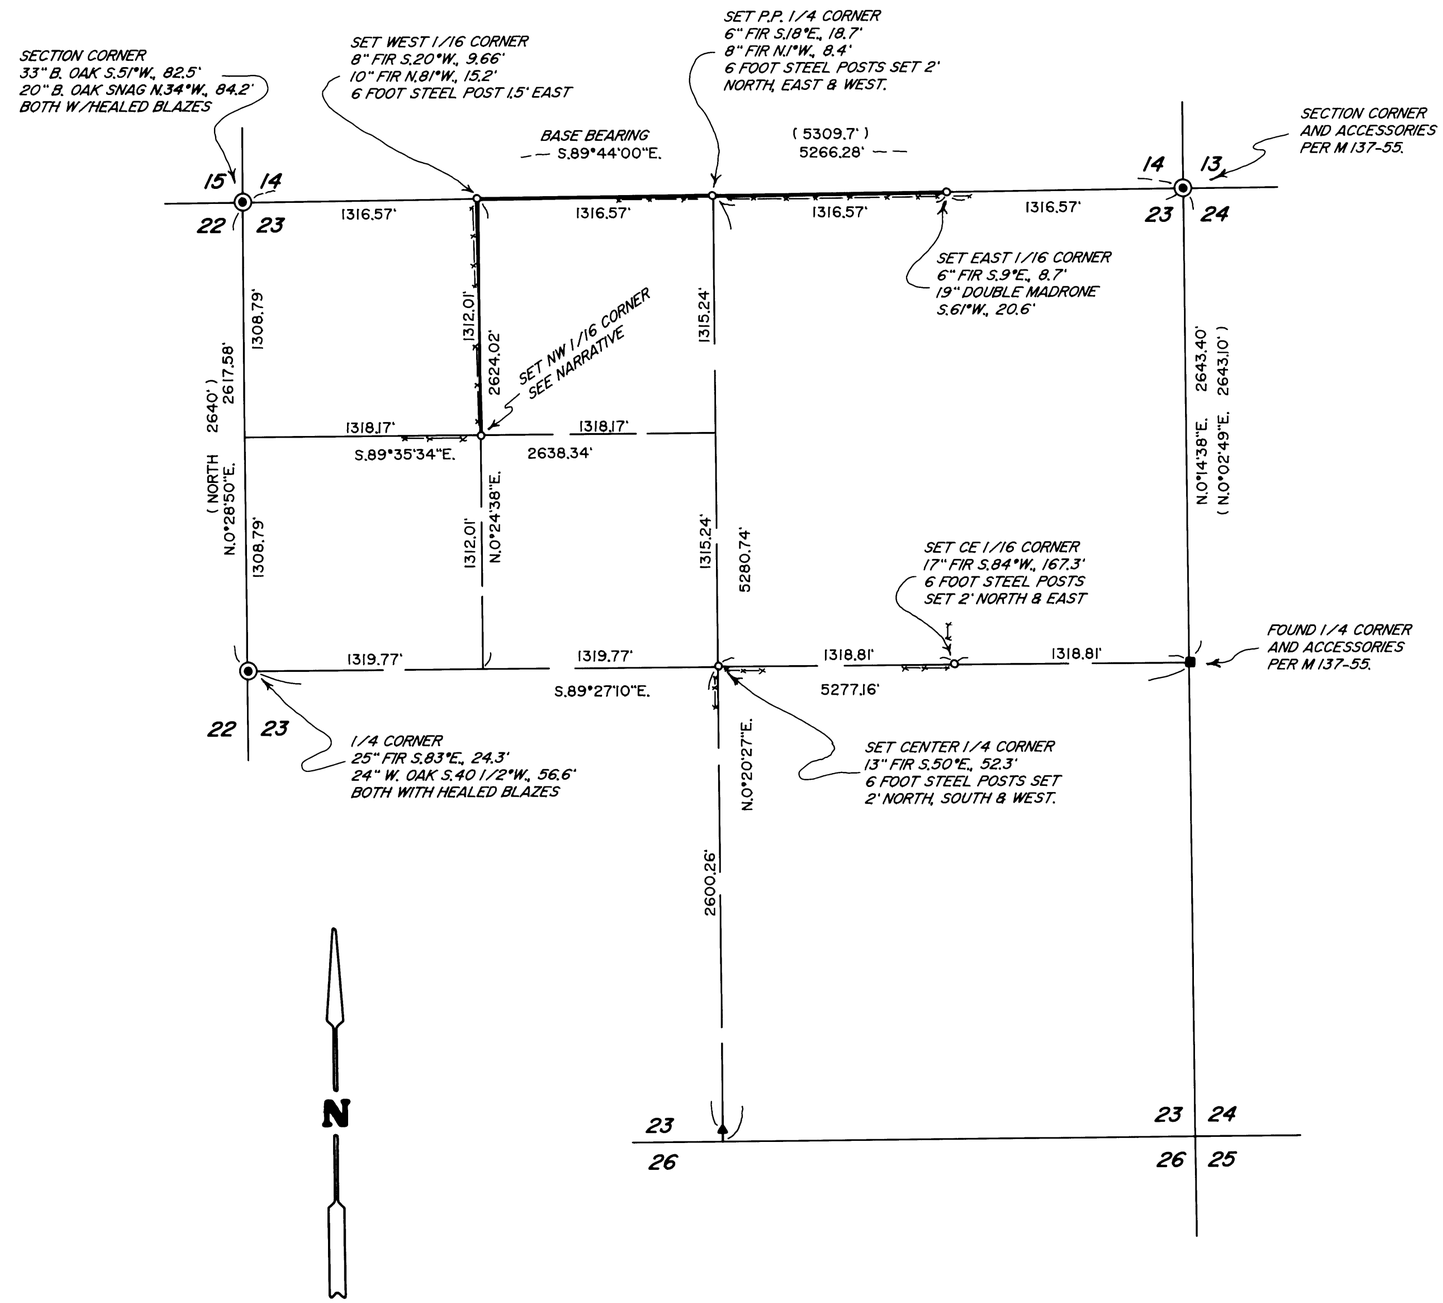

MAP FILE M148-40