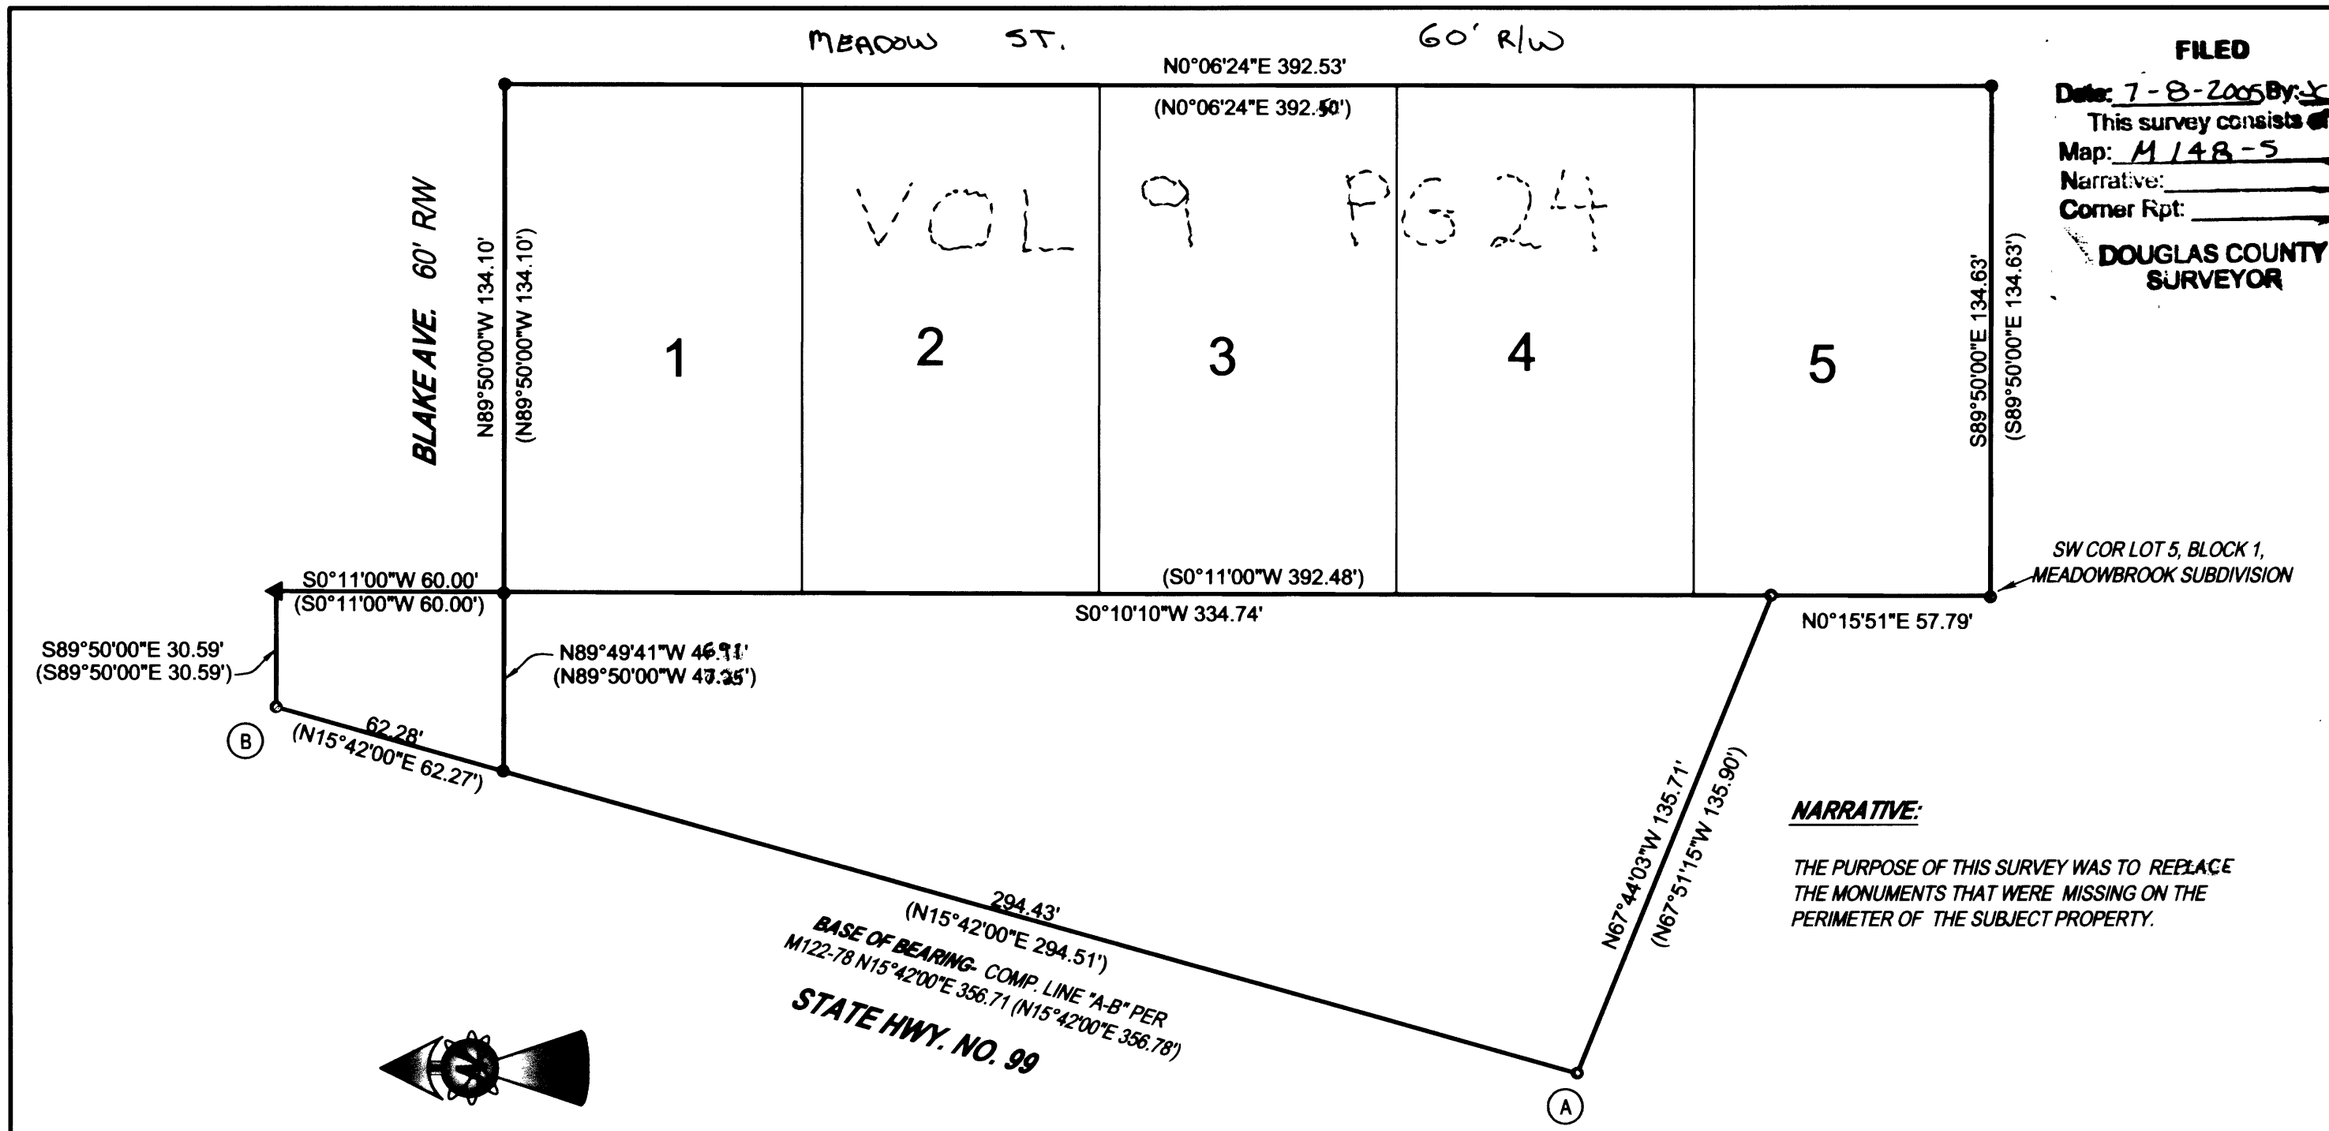

FILED
Date: 7-8-2005 By:
This survey consists of:
Map: M 148-5
Narrative:
Corner Rpt:
DOUGLAS COUNTY SURVEYOR

MAP FILE M148-5

NARRATIVE:

THE PURPOSE OF THIS SURVEY WAS TO REPLACE THE MONUMENTS THAT WERE MISSING ON THE PERIMETER OF THE SUBJECT PROPERTY.

LEGEND

- ○ FOUND 5/8" IRON ROD UNLESS OTHERWISE NOTED
- ● SET 5/8"x30" IRON ROD w/CAP STAMPED "HIBBS-LS 52989"
- ▲ CALCULATED POSITION
- ( ) RECORD PER M122-78

FIELD CREW: NEIL & ERIC HIBBS
EQUIPMENT: NIKON NPL-350 TOTAL STATION
OFFICE: NEIL HIBBS

SURVEY

LYING IN THE SE 1/4 OF SEC. 2 AND THE NE 1/4 OF SEC. 11, T28S, R6W, WILLAMETTE MERIDIAN, DOUGLAS COUNTY, OREGON

CLIENT:
ALBERT AND DELORES SCHATTENKIRK
P.O. BOX 1449
WINSTON, OREGON 97496

SURVEYOR:
NEIL HIBBS LAND SURVEYING, LLC
4739 LOOKINGGLASS ROAD
ROSEBURG, OREGON 97470
phone (541) 957-9303
fax (541) 957-9306
email: NeilHibbs@aol.com

REGISTERED PROFESSIONAL LAND SURVEYOR
OREGON JANUARY 12, 1999
F.NEIL HIBBS
52989
EXPIRATION DATE 6/30/2007

DWG. SCALE: 1" = 40'	JOB #: 0356-01	DATE: JULY 2005	PAGE: 1 OF 1

MAP FILE M148-5

DRAFTING