MAP OF SURVEY

LOCATED in Section 27, T. 24 S., R.6W., W.M.
in Douglas County, Oregon.

October 27, 2005

FILED
Date: 11-22-2005 By: JC
This survey consists of:
Map: M148-79
Narrative:
Corner Rpt:
DOUGLAS COUNTY
SURVEYOR

MAP FILE M148-79

SURVEYED FOR: *FRANK LAMACCHIA*
33795 GLORIA ROAD
GONZALES, CA. 93926

SURVEYED BY: *DAVID EDWARDS LAND SURVEYING*
P.O. BOX 361
OAKLAND, OREGON 97462
PHONE: (541) 459-0512

REGISTERED PROFESSIONAL LAND SURVEYOR
David A. Edwards
OREGON
JULY 24, 1998
DAVID A. EDWARDS
2339
RENEWS 12/31/05

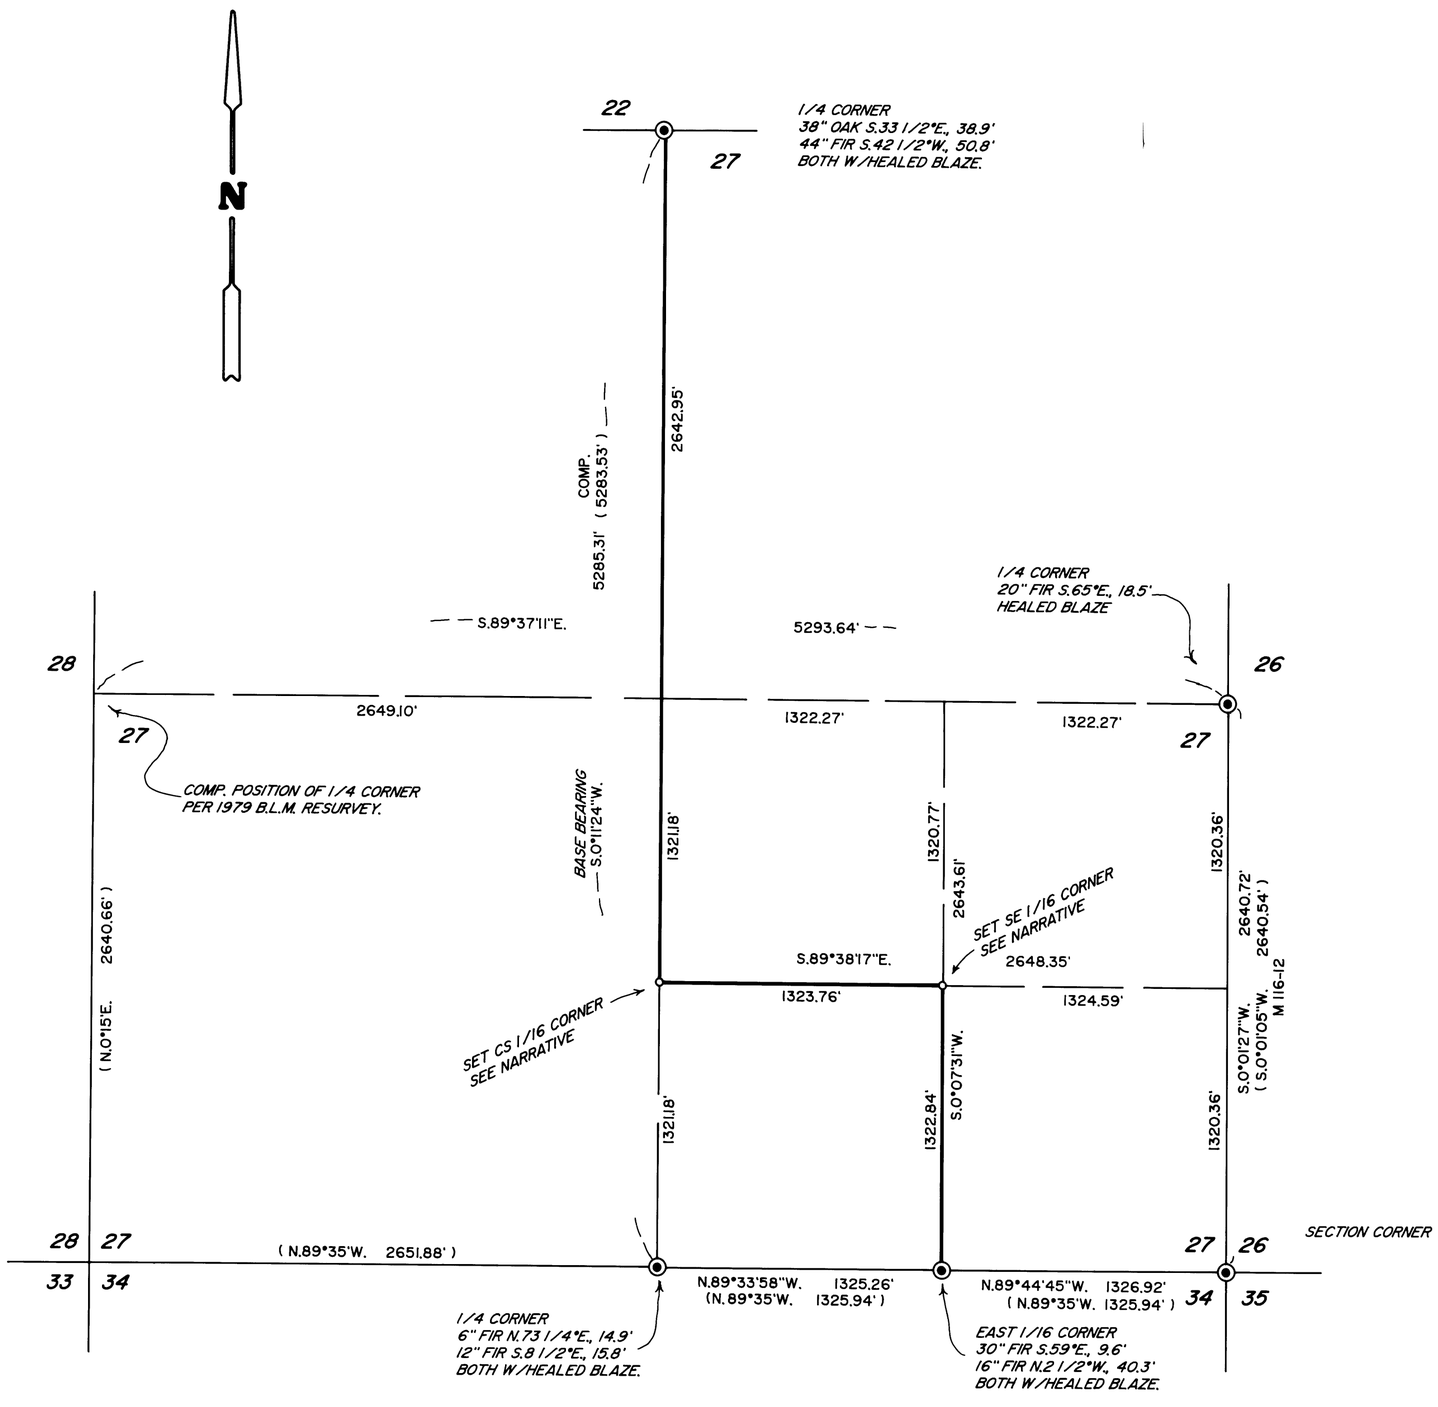

LEGEND

- ◉ INDICATES B.L.M. OR COUNTY SURVEYOR BRASS CAP FOUND.
- o INDICATES 5/8" X 30" STEEL REBAR W/RED PLASTIC CAP MKD. "D.A. EDWARDS-LS 2339" SET.
- ( ) DENOTES B.L.M. RECORD UNLESS NOTED OTHERWISE.

SCALE: 1" = 500' COMP. = COMPUTED

BASIS OF BEARINGS: COMPUTED RECORD PER B.L.M. 1979 RESURVEY BETWEEN NORTH & SOUTH 1/4 CORNERS.

NARRATIVE

THE PURPOSE OF THIS SURVEY IS TO SURVEY AND MARK THE NORTH AND EAST LINES OF THE SW QUARTER OF THE SE QUARTER AND A PORTION OF THE NORTH-SOUTH CENTERLINE OF SECTION 27. TIES WERE MADE TO THE CONTROLLING MONUMENTS SHOWN AS FOUND AND, USING A COMPUTED POSITION FROM THE 1979 B.L.M. RESURVEY FOR THE WEST 1/4 CORNER, THE SUBDIVISION OF THE SE QUARTER COMPUTED. THE SUBJECT BOUNDARIES WERE MARKED BY BLAZING TREES ON EACH SIDE OF LINE, BY SETTING 6 FOOT STEEL POSTS ALONG LINE AND BY HANGING LIBERAL AMOUNTS OF RED FLAGGING ALONG THE TRUE LINE. BEARING TREES ESTABLISHED ON THIS SURVEY WERE SCRIBED ACCORDING TO THE 1973 MANUAL, MEASURED TO CENTER OF TREE AT ROOT CROWN AND ARE SITUATED AS FOLLOWS:

AT THE CS 1/16 CORNER: AN 8" DIAM. FIR BEARS N.32°E., 3.9 FEET.
A 9" DIAM. FIR BEARS S.59°E., 4.9 FEET.
AN UNRECORDED 1/2" DIAM. IRON PIPE BEARS S.49°E., 25.1 FEET.

AT THE SE 1/16 CORNER: A 9" DIAM. FIR BEARS N.35°E., 6.5 FEET.
A 12" DIAM. FIR BEARS N.63°W., 6.8 FEET.

FIELD CREW: BRANT MILLER AND ERIC SPRINKLE.

EQUIPMENT: NIKON TOTAL STATION.

COMPS. AND DRAFTING: DAVID EDWARDS.

MAP FILE M148-79