

# SURVEY FOR BOUNDARY LINE AGREEMENT

## FOR: LONE ROCK TIMBER MANAGEMENT COMPANY AND SHARON A. MAST

TOWNSHIP 22 SOUTH, RANGE 4 WEST, W.M. SECTIONS 29 & 30      MANAGED BY LONE ROCK TIMBER LAND CO.      DATE: MAY 2005


PO BOX 1127    ROSEBURG, OREGON 97470

SURVEY: MAST / JACKSON TRACT

DOUGLAS COUNTY, OREGON


### CORNER INFORMATION:

- 1) THE NORTH 1/4 CORNER OF SECTION 29  
FOUND 1963 BLM BRASS CAP.  
-- 21" DOUGLAS FIR BEARS N49 1/4"W, 30.75 FEET (RECORD N49 1/4"W, 31.02 FEET) WELL HEALED FACE, NO TAG  
-- ROTTEN FIR STUMP BEARS N41"W, 10.5 FEET, (RECORD N42"W, 10.56 FEET) VISIBLE SCRIBING, NO TAG  
-- 19" DOUGLAS FIR BEARS S78"W, 40.6 FEET (RECORD S78 1/4"W, 40.92 FEET) WELL HEALED FACE, NO TAG  
-- FOUND 1 3/4" IRON PIPE S13 1/4"E, 3.6 FEET (RECORD S13 1/2"E, 3.6 FEET)  
CORNER LIES ON NORTH FACING SLOPE, FENCE CORNER BEARS N20"W, 8.5 FEET. FENCE IS UP BEARING SOUTH AND WEST, IT IS DOWN BEARING EAST.
- 2) THE EAST 1/16 CORNER BETWEEN SECTIONS 20 AND 29  
FOUND 1995 BAKER BRASS CAP.  
-- 11" FIR STUMP 7 FOOT TALL BEARS S78"E, 8.4 FEET AS PER RECORD, VISIBLE SCRIBING AND WEYCO TAG  
-- 12" FIR S39"W, 7.4 FEET IS UPROOTED AND OUT OF POSITION, DID NOT MEASURE TO  
-- METAL FENCE POST BEARS APPROXIMATELY 1.0 FEET NORTH  
CORNER LIES AT WEST EDGE OF WEYCO REPROD STAND APPROXIMATELY 10 FEET TALL, MOSTLY BRUSH AND SMALL ALDER WEST OF CORNER.
- 3) THE NORTHEAST 1/16 CORNER OF SECTION 29  
FOUND 1995 BAKER CAP.  
-- 13" DOUGLAS FIR BEARS N22"E, 19.4 FEET (RECORD N17"E, 18.8 FEET) HEALED FACE AND WEYCO TAG  
-- 23" DOUGLAS FIR BEARS S77 1/2"E, 9.3 FEET (RECORD S81"E, 8.7 FEET) HEALED FACE AND WEYCO TAG  
ALUMINUM CORNER LIES ON NORTH FACING SLOPE APPROXIMATELY 2.5 FEET NORTH OF EAST-WEST FENCE LINE.  
NORTH BEARING FENCE LINE CORNERS S88"W, 12.0 FEET FROM ALUMINUM CAP.
- 4) THE CENTER NORTH 1/16 CORNER OF SECTION 29  
SET 5/8" X 40" IRON ROD MARKED LONE ROCK TIMBER CN 1/16 S29 2005 PLS 2291.  
-- 19" DOUGLAS FIR BEARS S9 1/4"E, 22.4 FEET, WE SCRIBE CN 1/16 S29 B.T. AND TAG TREE  
-- 19" HEMLOCK BEARS S83 1/2"W, 20.5 FEET, WE SCRIBE CN 1/16 S29 B.T. AND TAG TREE  
LRT CAP LIES ON STEEP NORTHEAST SLOPE APPROXIMATELY 25 FEET NORTH OF EAST - WEST FENCE LINE.
- 5) THE 1/4 CORNER BETWEEN SECTIONS 29 AND 32  
FOUND 1995 BAKER CAP.  
-- 5/8" IRON ROD IN NORTH-SOUTH FENCE LINE BEARS N20 1/4"E, 9.5 FEET (RECORD N20 1/4"E, 9.6 FEET) ROD IS BENT  
-- 5/8" IRON ROD IN NORTH - SOUTH FENCE LINE BEARS S30 3/4"E, 6.3 FEET AS PER RECORD  
-- DID NOT FIND IRON RODS TO THE SOUTHWEST AND NORTHWEST  
BAKER CAP LIES ON STEEP SOUTHEAST SLOPE APPROXIMATELY 3.5 FEET WEST OF FENCE LINE.
- 6) THE SOUTHWEST CORNER OF SECTION 29  
FOUND 1995 BAKER CAP.  
-- 10" OAK BEARS S31 1/4"E, 327.6 FEET (RECORD S30"E, 326.2 FEET) VISIBLE SCRIBING AND WEYCO TAG  
-- 12" ASH BEARS S22 1/2"W, 272.6 FEET (RECORD S22"W, 272.1 FEET) VISIBLE SCRIBING AND WEYCO TAG  
-- 12" ASH BEARS S55"E, 462.6 FEET (RECORD S56"E, 462.2 FEET) VISIBLE SCRIBING AND WEYCO TAG  
-- 12" ASH BEARS N79 1/4"W, 513.4 FEET (RECORD N82"W, 512.8 FEET) VISIBLE SCRIBING AND WEYCO TAG  
BAKER CORNER LIES IN MIDDLE OF GRASS FIELD NORTH OF ELK CREEK.
- 7) THE SOUTH 1/16 CORNER BETWEEN SECTIONS 29 AND 30  
FOUND 1997 LONE ROCK TIMBER ALUMINUM CAP ON 5/8" IRON ROD.  
-- 10" DOUGLAS FIR BEARS N88 1/4"W, 20.8 FEET AS PER RECORD, HEALED FACE AND LRT TAG  
-- 15" DOUGLAS FIR BEARS S68"E, 7.2 FEET AS PER RECORD, HEALED FACE  
LRT CAP LIES ON SOUTH FACING SLOPE NEAR TOE OF SLOPE.
- 8) PROPERTY CORNER  
FOUND 1997 LONE ROCK TIMBER 5/8" IRON ROD WITH YELLOW PLASTIC CAP.  
-- 15" DOUGLAS FIR BEARS S11"W, 21.4 FEET AS PER RECORD, HEALED FACE
- 9) THE 1/4 CORNER BETWEEN SECTIONS 29 AND 30  
FOUND 1965 DOUGLAS COUNTY CAP.  
-- 22" OAK BEARS N45"W, 76.2 FEET (RECORD N45"W, 77.9 FEET) WELL HEALED FACE AND TAG  
-- 12" OAK BEARS N51 1/4"W, 34.5 FEET (RECORD N52"W, 35.0 FEET) HEALED FACE AND TAG  
-- 29" DOUGLAS FIR BEARS N79 1/2"E, 66.4 FEET (RECORD N79"E, 66.2 FEET) HEALED FACE AND TAG  
COUNTY CAP SITS IN GRASS OPENING APPROXIMATELY 140 FEET SOUTH OF TOP OF RIDGE.
- 10) THE NORTH 1/16 CORNER BETWEEN SECTIONS 29 AND 30  
SET 5/8" X 40" IRON ROD WITH 2 1/2" ALUMINUM CAP MARKED LONE ROCK TIMBER N 1/16 S29 S30 2005 PLS 2291.  
-- 22" DOUGLAS FIR BEARS S20 1/4", 35.85 FEET, WE SCRIBE N 1/16 S29 B.T. AND TAG  
-- 19" DOUGLAS FIR BEARS N14 1/2"W, 6.6 FEET, WE SCRIBE N 1/16 S30 B.T. AND TAG  
LRT CAP LIES ON NORTH SLOPE A FENCE CORNER BEARS S5 1/4"W, 13.2 FEET AND EAST 2.0 FEET FROM A NORTH-SOUTH FENCE LINE.
- 11) THE NORTHWEST SECTION CORNER FOR SECTION 29  
FOUND 1963 BLM CAP.  
-- ROTTEN SNAG BEARS N23"E, 36.4 FEET AS PER RECORD, VISIBLE SCRIBING  
-- ROTTEN SNAG BEARS N13 1/2"W, 27.2 FEET (RECORD N20"W, 26.8 FEET) VISIBLE SCRIBING  
-- 9" OAK BEARS N69 1/4"W, 4.8 FEET (RECORD N75"W, 4.3 FEET) HEALED FACE AND TAG  
-- IRON PIPE BEARS N20"W, 1.7 FEET AS PER RECORD  
BLM CORNER LIES ON STEEP SOUTH SLOPE APPROXIMATELY 250 FEET NORTH OF COX ROAD.
- 12) CENTER NORTH NORTH NORTH 1/256 CORNER OF SECTION 29  
SET 5/8" X 40" IRON ROD WITH YELLOW PLASTIC CAP MARKED LONE ROCK TIMBER PLS 2291.  
-- 19" DOUGLAS FIR BEARS S54 1/2"W, 10.4 FEET, WE SCRIBE B.T. AND TAG (FENCE WRAPS AROUND TREE)  
-- UNRECORDED 1 3/4" IRON PIPE BEARS S2"E, 3.57 FEET  
YELLOW PLASTIC CAP LIES ON NORTHWEST SLOPE. EXISTING FENCE LINES LOOPS AROUND CORNER.
- 13) CENTER NORTH NORTH NORTHWEST 1/256 CORNER FOR SECTION 29  
SET 5/8" X 40" IRON ROD WITH YELLOW PLASTIC CAP MARKED LONE ROCK TIMBER PLS 2291, 0.3 FEET BELOW GROUND LEVEL  
-- 12" DOUGLAS FIR BEARS S70 1/4"E, 32.3 FEET, WE SCRIBE B.T. AND TAG TREE  
-- TREATED RAILROAD TIE GATE POST BEARS S27 3/4"W, 4.7 FEET (TO FINISH NAIL ON TOP OF POST)  
YELLOW PLASTIC CAP LIES AT WEST EDGE OF WEST WHEEL TRACK OF ROCK ROAD.

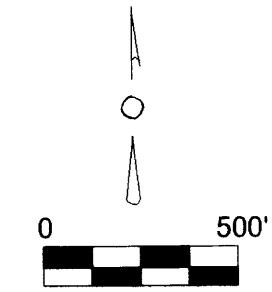

SCALE: 1" = 500'

BASIS OF BEARING IS FROM GPS

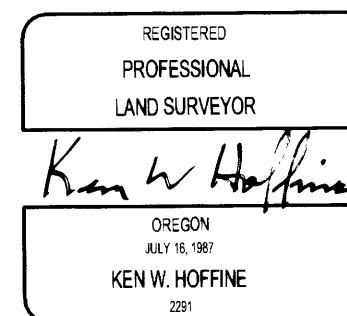

EXPIRES 6-30-05

- 14) THE CENTER 1/4 CORNER FOR SECTION 29  
SET 5/8" X 40" IRON ROD WITH 2 1/2" ALUMINUM CAP MARKED LONE ROCK TIMBER T22S R4W S29 C1/4 2005 PLS 2291.  
-- 15" DOUGLAS FIR BEARS N24"E, 13.0 FEET, WE SCRIBE C 1/4 S 29 B.T. AND TAG TREE  
-- 20" WHITE FIR BEARS N67 3/4"W, 25.0 FEET, WE SCRIBE C 1/4 S 29 B.T. AND TAG TREE  
-- 14" DOUGLAS FIR BEARS S45 1/4"W, 30.3 FEET, WE SCRIBE C 1/4 S 29 B.T. AND TAG TREE  
-- 16" DOUGLAS FIR BEARS S0 1/2"E, 36.5 FEET, WE SCRIBE C 1/4 S 29 B.T. AND TAG TREE  
LRT CAP LIES ON NORTHWEST SLOPE APPROXIMATELY 125 FEET SOUTH OF POWERLINE ROAD.

- 15) PROPERTY CORNER  
SET 5/8" X 40" IRON ROD WITH YELLOW PLASTIC CAPS MARKED LONE ROCK TIMBER PLS 2291.  
-- FENCE CORNER BEARS N82"E, 1.4 FEET, WE TAG  
YELLOW PLASTIC CAP LIES ON STEEP SOUTH SLOPE IN EAST-WEST FENCE LINE.

- 16) PROPERTY CORNER  
SET 5/8" X 40" IRON ROD WITH YELLOW PLASTIC CAP MARKED LONE ROCK TIMBER PLS 2291.  
-- 12" DOUGLAS FIR BEARS S50 3/4"W, 12.8 FEET, WE SCRIBE B.T. AND TAG  
YELLOW PLASTIC CAP LIES AT BEARING BREAK IN FENCE LINE.

- 17) PROPERTY CORNER  
SET 5/8" X 40" IRON ROD WITH YELLOW PLASTIC CAPS MARKED LONE ROCK TIMBER PLS 2291.  
-- 6" DOUGLAS FIR BEARS N79"W, 10.5 FEET, WE SCRIBE B.T. AND TAG  
YELLOW PLASTIC CAP LIES AT BEARING BREAK IN FENCE LINE.

- 18) PROPERTY CORNER  
SET 5/8" X 40" IRON ROD WITH YELLOW PLASTIC CAPS MARKED LONE ROCK TIMBER PLS 2291.  
-- 7" DOUGLAS FIR BEARS S71 1/2"W, 6.8 FEET, WE SCRIBE B.T. AND TAG  
YELLOW PLASTIC CAP LIES AT BREAK IN FENCE LINE.

- 19) PROPERTY CORNER  
SET 5/8" X 40" IRON ROD WITH YELLOW PLASTIC CAPS MARKED LONE ROCK TIMBER PLS 2291.  
-- PROPERTY CORNER (18) BEARS S31 1/4"W, 46.2 FEET  
YELLOW PLASTIC CAP LIES AT BREAK IN FENCE LINE.

- 20) PROPERTY CORNER  
SET 5/8" X 40" IRON ROD WITH YELLOW PLASTIC CAPS MARKED LONE ROCK TIMBER PLS 2291.  
-- 11" DOUGLAS FIR BEARS S11"E, 4.8 FEET, WE SCRIBE B.T. AND TAG  
YELLOW PLASTIC CAP LIES AT BREAK IN FENCE LINE.

- 21) PROPERTY CORNER  
SET 5/8" X 40" IRON ROD WITH YELLOW PLASTIC CAPS MARKED LONE ROCK TIMBER PLS 2291.  
-- 11" DOUGLAS FIR BEARS S84 1/2"E, 13.5 FEET, WE SCRIBE B.T. AND TAG  
YELLOW PLASTIC CAP LIES AT BREAK IN FENCE LINE.

- 22) PROPERTY CORNER  
SET 5/8" X 40" IRON ROD WITH YELLOW PLASTIC CAPS MARKED LONE ROCK TIMBER PLS 2291.  
-- 14" DOUGLAS FIR BEARS S9 1/4"E, 9.0 FEET, WE SCRIBE B.T. AND TAG  
YELLOW PLASTIC CAP LIES AT FENCE CORNER.

- 23) PROPERTY CORNER  
SET 5/8" X 40" IRON ROD WITH YELLOW PLASTIC CAPS MARKED LONE ROCK TIMBER PLS 2291.  
-- 20" DOUGLAS FIR BEARS N40 3/4"W, 10.4 FEET, WE SCRIBE B.T. AND TAG  
YELLOW PLASTIC CAP LIES AT BREAK IN FENCE LINE.

- 24) PROPERTY CORNER  
SET 5/8" X 40" IRON ROD WITH YELLOW PLASTIC CAPS MARKED LONE ROCK TIMBER PLS 2291.  
-- 11" DOUGLAS FIR BEARS N62 3/4"E, 7.4 FEET, WE SCRIBE B.T. AND TAG  
YELLOW PLASTIC CAP LIES AT BREAK IN FENCE LINE.

- 25) PROPERTY CORNER  
SET 5/8" X 40" IRON ROD WITH YELLOW PLASTIC CAPS MARKED LONE ROCK TIMBER PLS 2291.  
-- 13" DOUGLAS FIR BEARS N30 1/4"W, 11.3 FEET, WE SCRIBE B.T. AND TAG  
YELLOW PLASTIC CAP LIES AT BREAK IN FENCE LINE.

- 26) PROPERTY CORNER  
SET 5/8" X 40" IRON ROD WITH YELLOW PLASTIC CAPS MARKED LONE ROCK TIMBER PLS 2291.  
-- 9" DOUGLAS FIR BEARS N 1 1/2"E, 8.0 FEET, WE SCRIBE B.T. AND TAG  
YELLOW PLASTIC CAP LIES AT BREAK IN FENCE LINE

- 27) PROPERTY CORNER  
SET 5/8" X 40" IRON ROD WITH YELLOW PLASTIC CAPS MARKED LONE ROCK TIMBER PLS 2291.  
-- 13" DOUGLAS FIR BEARS N4"W, 13.4 FEET, WE SCRIBE B.T. AND TAG  
YELLOW PLASTIC CAP LIES AT BREAK IN FENCE LINE.

- 28) PROPERTY CORNER  
SET 5/8" X 40" IRON ROD WITH YELLOW PLASTIC CAPS MARKED LONE ROCK TIMBER PLS 2291.  
-- 30" OAK BEARS S45"E 1.5 FEET TO CENTER WE SCRIBE BT AND TAG  
YELLOW PLASTIC CAP LIES AT END OF FENCE LINE.

- 29) PROPERTY CORNER  
SET 5/8" X 40" IRON ROD WITH YELLOW PLASTIC CAPS MARKED LONE ROCK TIMBER PLS 2291.  
-- 30" OAK BEARS S1 1/2"E 43.9 FEET THIS IS THE SAME OAK AS FOR PROPERTY CORNER # 28  
YELLOW PLASTIC CAP LIES ON 1/64 LINE.

- 30) PROPERTY CORNER  
FOUND 5/8" IRON ROD SET 1997 LRT SURVEY MAP M124-47  
-- 20" DEAD WHITE FIR BEARS N23 3/4"E, 10.2 FEET (RECORD N23 1/2"E, 10.0 FEET) HEALED FACE AND TAG  
YELLOW PLASTIC CAP LIES IN RIGHT-OF-WAY NORTHEAST - SOUTHWEST FENCE LINE FOR INTERSTATE 5.

- 31) IRON ROD ON LINE  
SET 5/8" X 40" IRON ROD WITH YELLOW PLASTIC CAP MARKED LONE ROCK TIMBER PLS 2291  
-- 23" DOUGLAS FIR BEARS N14 1/4"E, 21.0 FEET WE SCRIBE BT AND TAG TREE  
YELLOW PLASTIC CAP LIES ON NORTH SIDE OF MAIN RIDGE.

- 32) THE EAST 1/4 CORNER FOR SECTION 29  
FOUND HAINES "T" IRON 0.6 FEET ABOVE GROUND LEVEL  
-- 50" FIR STUMP BEARS S69 1/2"W 51.9 FEET AS PER RECORD CHOPPED OUT FACE  
-- 22" TALL DOUGLAS FIR STUMP BEARS S75 3/4"W 26.5 FEET (RECORD S76 1/4"W 26.6 FEET) HEALED FACE NO TAG  
-- 14" DOUGLAS FIR BEARS N69"W 13.2 FEET (RECORD N62"W 12.7 FEET) HEALED FACE AND WEYCO TAG  
-- 17" WHITE FIR BEARS N7 3/4"W 27.0 FEET (RECORD N7"W 26.4) VISIBLE SCRIBING AND WEYCO TAG  
-- 38" CEDAR STUMP BEARS N59"E 56.4 FEET (RECORD N58 3/4"E 56.5 FEET HEALED FACE  
CORNER LIES ON WEST BOUNDARY OF RECENT WEYCO CLEARCUT. ROCK ROAD BEARS APPROX. 80 FEET SOUTH OF CORNER.

FILED

Date: 7-11-2005 P.M. AW

This survey consists of:

Map: M148-9A13

Narrative: \_\_\_\_\_

Corner Rpt: \_\_\_\_\_

DOUGLAS COUNTY  
SURVEYOR

MAP FILE M148-9A13

MAP FILE M148-9A13