FILED
Date: 2-8-2006 By: JC
This survey consists of:
Map: M149-50
Notes:
Corner Rpt:
DOUGLAS COUNTY
SURVEYOR

MAP FILE M149-50

PROPERTY SURVEY

Located in the:
S. E. 1/4 of SECTION 21,
TOWNSHIP 30 SOUTH, RANGE 5 WEST,
WILLAMETTE MERIDIAN, DOUGLAS COUNTY, OREGON

JAN., 2006
SCALE: 1" = 40'

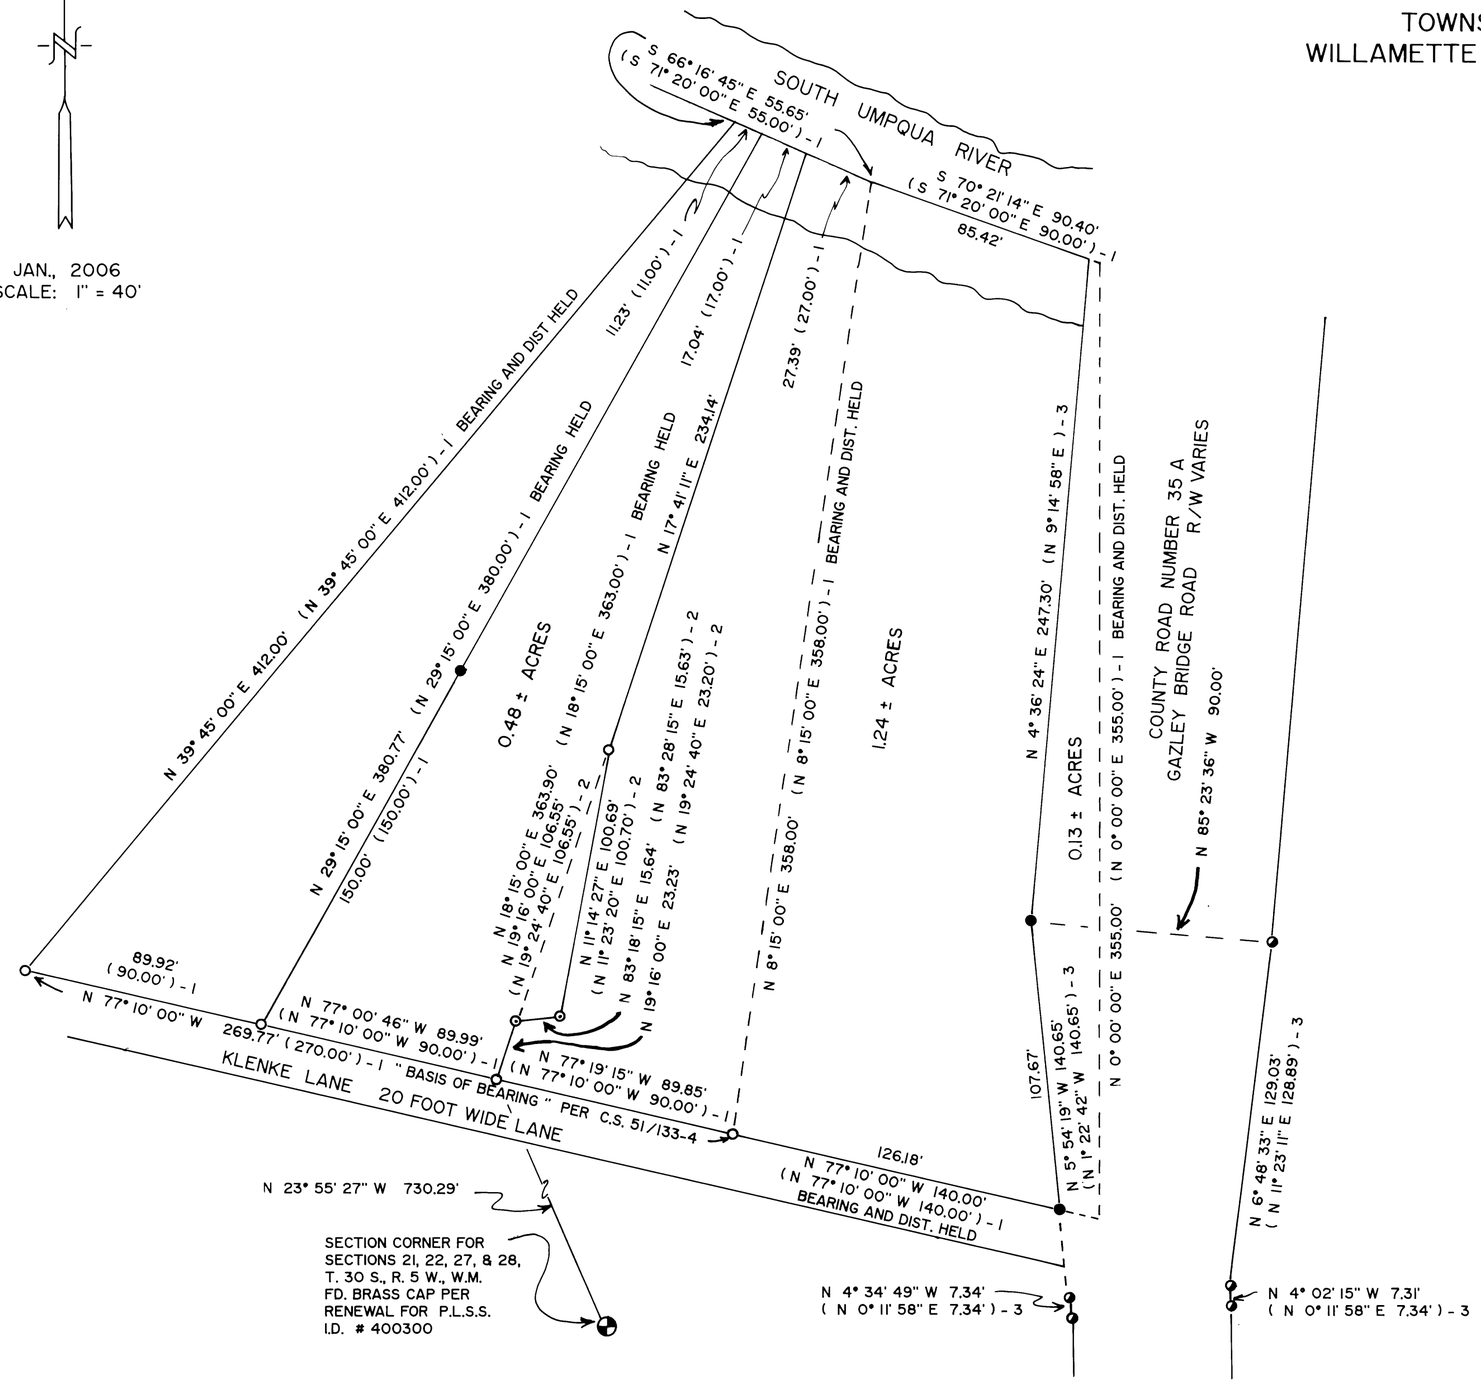

PREPARED FOR:
COW CREEK BAND of the
UMPQUA TRIBE of INDIANS,
2371 N.E. STEPHENS ST., SUITE 100
ROSEBURG, OREGON 97470

PREPARED BY:
RAYMOND F. BROWN, P.L.S. #2391
P. O. BOX 539
CANYONVILLE, OREGON 97417
PHONE: (541) 839 - 6185

REGISTERED
PROFESSIONAL
LAND SURVEYOR
OREGON
JULY 23, 1999
RAYMOND F. BROWN
2391

EXP. 12/31/07

NARRATIVE:

PURPOSE OF THE SURVEY WAS TO DEFINE THE PROPERTIES AS SHOWN. FIELD INVESTIGATION LOCATED THE SAID FOUND MONUMENTS AND CONDITIONS. FOUND MONUMENTS AND CALLS PER SURVEY'S C.S. 51/133-4, C.S. 58/156-3, AND CO. RD. #35A, CONTROLLED THE SURVEY.

LEGEND:

○	FD. 3/4" IRON PIPE PER C.S. 51/133-4.
⊙	FD. 3/4" IRON ROD PER C.S. 58/156-3.
◕	FD. 5/8" IRON ROD PER CO. RD. #35A.
●	SET 5/8" X 30" IRON ROD WITH PLASTIC CAP ATTACHED, MKD. " R. BROWN, PLS 2391 ".
( ) - 1	RECORD AS PER C.S. 51/133-4.
( ) - 2	RECORD AS PER C.S. 58/156-3.
( ) - 3	RECORD AS PER CO. RD. #35A.

MAP FILE M149-50