MAP FILE M149-56

FILED
Date: 2/15/2006 By: MW
This survey consists of:
Map: M 149-56
Narrative:
Corner Rpt:
DOUGLAS COUNTY SURVEYOR

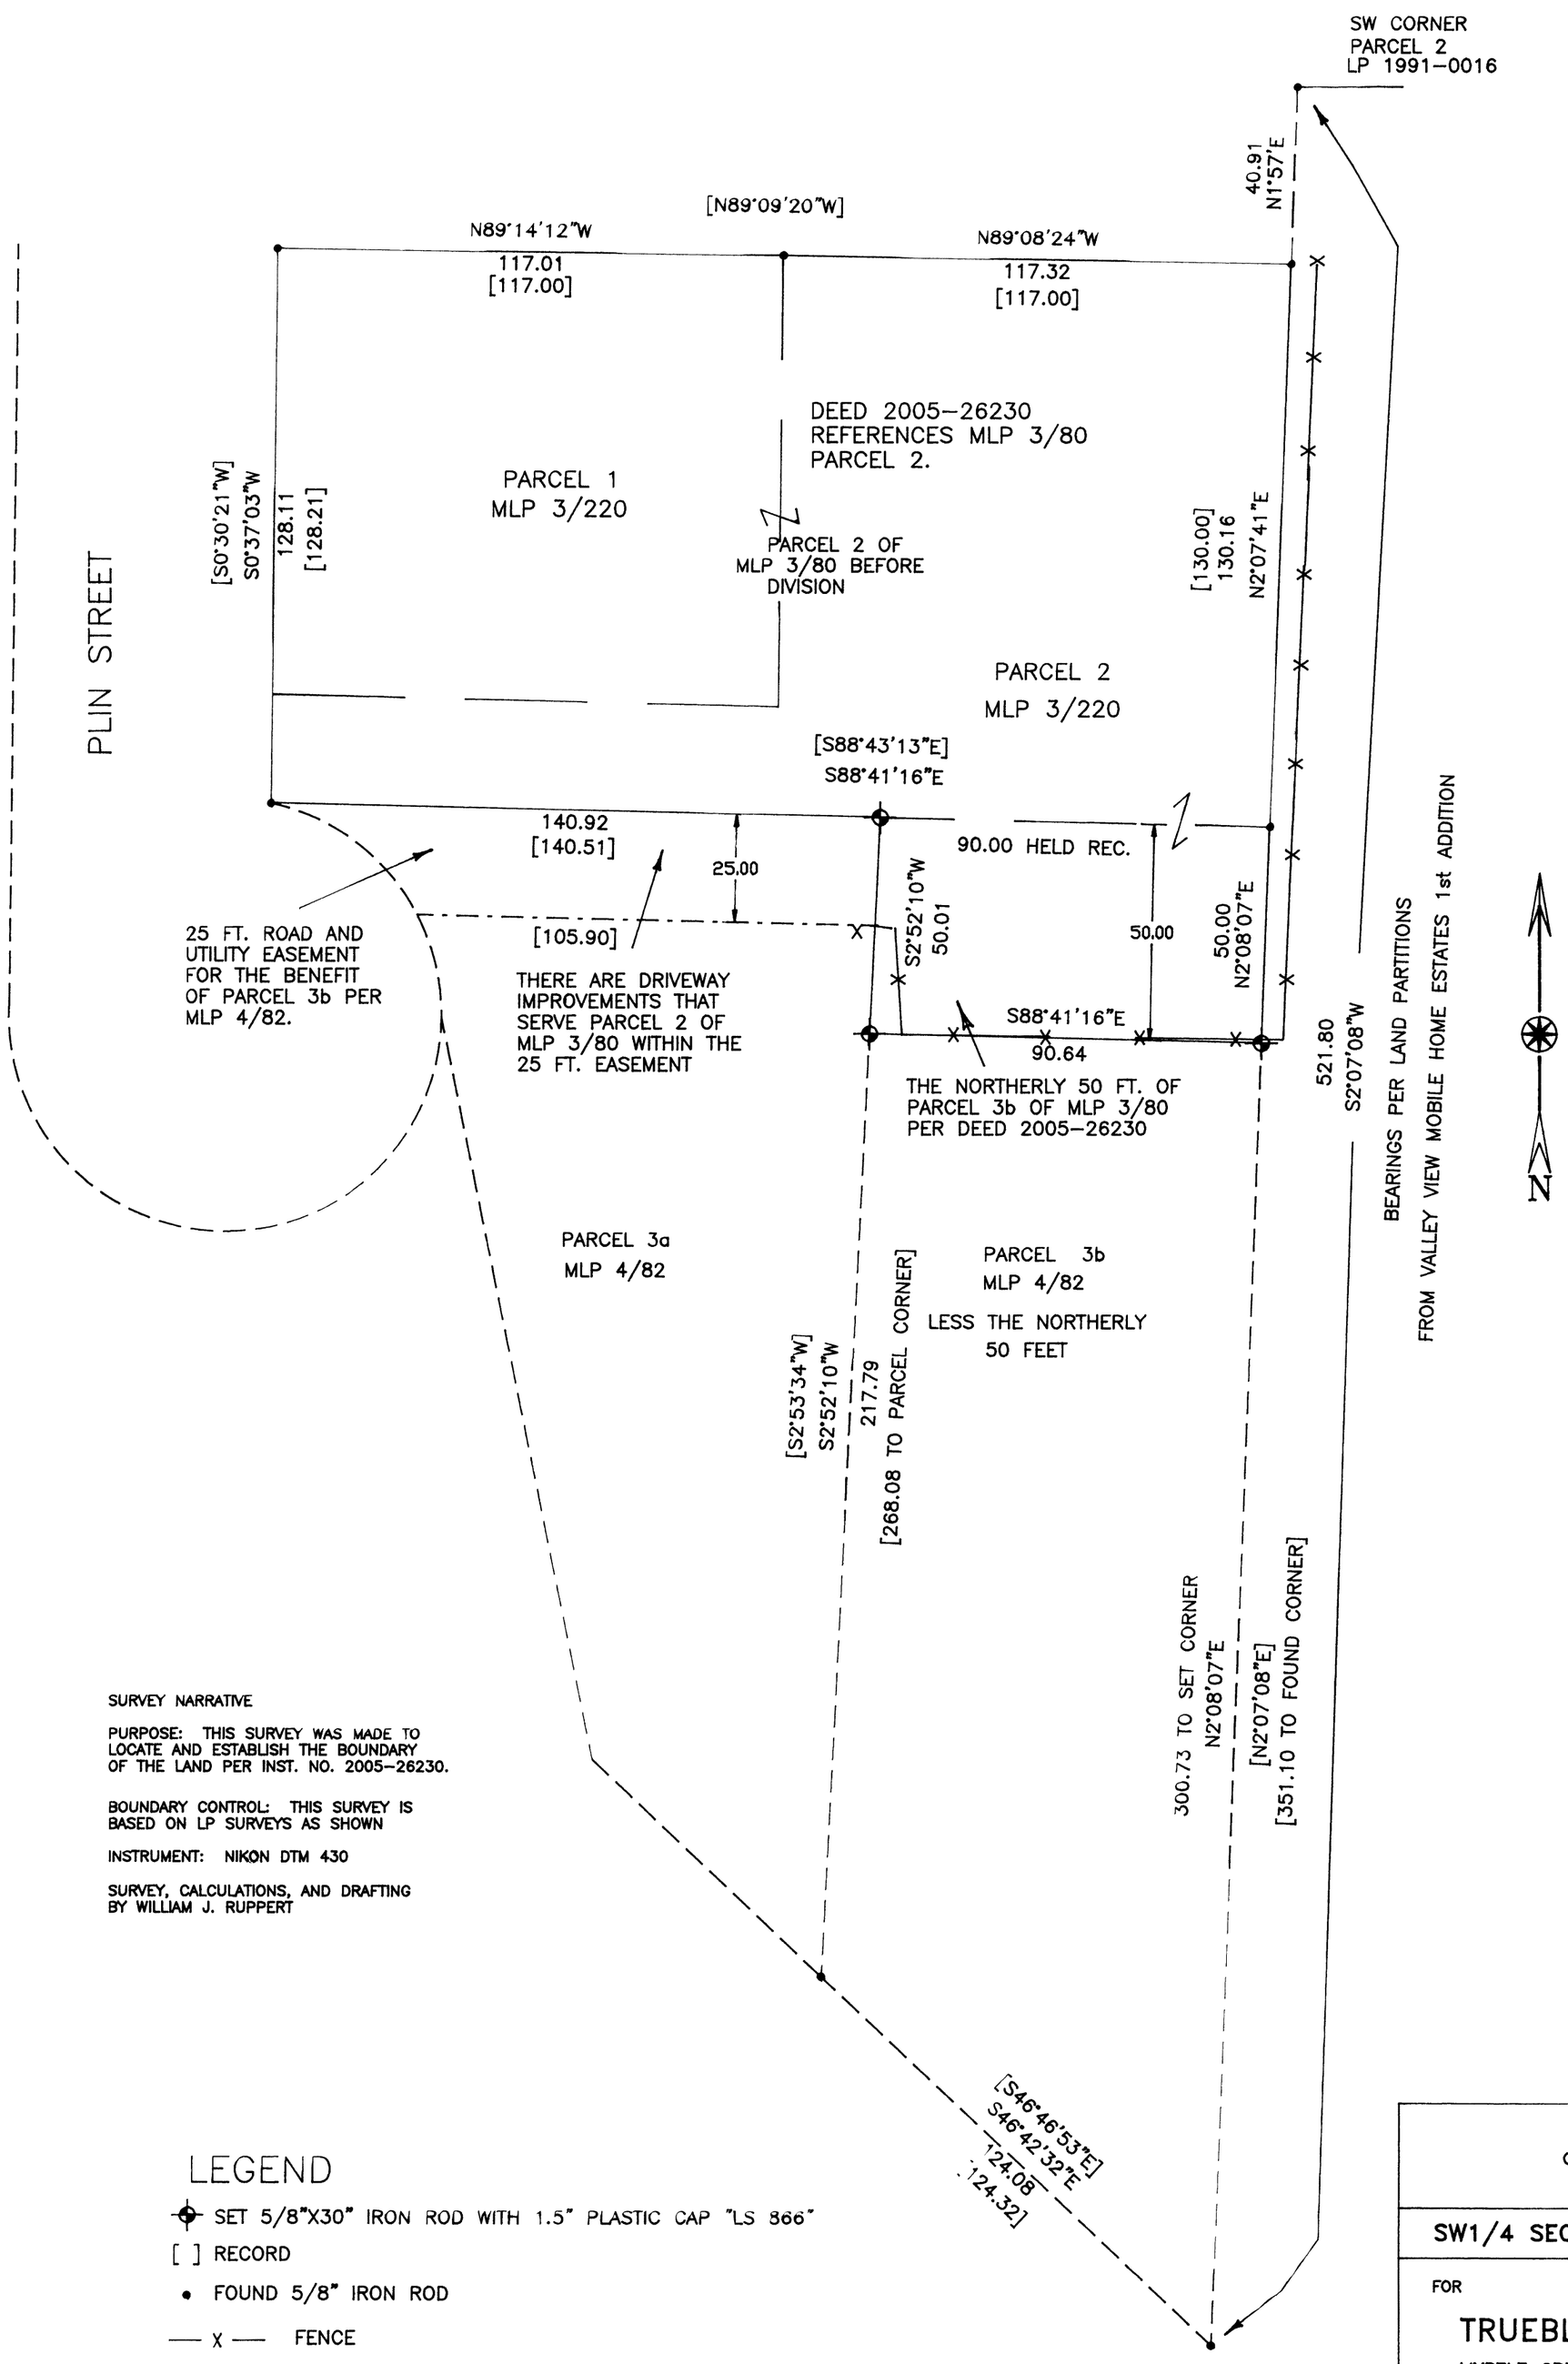

SURVEY NARRATIVE

PURPOSE: THIS SURVEY WAS MADE TO LOCATE AND ESTABLISH THE BOUNDARY OF THE LAND PER INST. NO. 2005-26230.

BOUNDARY CONTROL: THIS SURVEY IS BASED ON LP SURVEYS AS SHOWN

INSTRUMENT: NIKON DTM 430

SURVEY, CALCULATIONS, AND DRAFTING BY WILLIAM J. RUPPERT

LEGEND

- SET 5/8"X30" IRON ROD WITH 1.5" PLASTIC CAP "LS 866"
- [ ] RECORD
- • FOUND 5/8" IRON ROD
- — X — FENCE

SURVEY

OF DEED INST. NO. 2005-26230

IN

SW1/4 SECTION 08, T. 30 S. R. 5 W.

FOR

TRUEBLOOD REALTY

MYRTLE CREEK, OR 97457

REGISTERED
OREGON
LAND SURVEYOR

JULY 12, 1968
WILLIAM J. RUPPERT
866

MY REGISTRATION EXPIRES 12/31/2006

Surveyed by:

WILLIAM J. RUPPERT
P.O. BOX 1564
MYRTLE CREEK, OR 97457

SCALE 1"=30'

FEB. 2006

SHEET 1 OF 1

MAP FILE M149-56