

RECORD OF SURVEY  
 FOR: SENECA JONES TIMBER COMPANY  
 NW1/4, SECTION 33, T21S, R5W, W.M.  
 DOUGLAS COUNTY, OREGON  
 11 AUGUST 2006

FILED  
 Date: 8-16-2006 By: JC  
 This survey consists of:  
 Map: M151-24  
 Narrative: \_\_\_\_\_  
 Corner Rpt: \_\_\_\_\_  
**DOUGLAS COUNTY**  
**SURVEYOR**

SECTION CORNER  
 SECTIONS 28,29,32,33  
 FOUND 3-1/4" BLM ALUMINUM CAP  
 DATED 1981 WITH THE FOLLOWING  
 ACCESSORIES:

WC 2-1/2" COUNTY SURVEYORS OFFICE BRASS CAP  
 DATED 1962 BEARS NORTH 20.9' - RECORD 20.0'  
 26" GRAND FIR BEARS S6-1/4°E 36.3' - HEALED FACE  
 65" D. FIR BEARS N63°E 35.0' - FAINT BARK SCRIBING  
 38" I. CEDAR BEARS S50-1/2°E 67.3' - HEALED FACE

ALL BT'S HAVE RED PAINTED BAND AND FACE PLUS  
 BEARING TREE TAG. GALVANIZED POST SET ADJACENT  
 TO CORNER MONUMENT.

**NARRATIVE:**


THE PURPOSE OF THIS SURVEY WAS TO MARK THE SECTION OF LINE  
 SHOWN AS POSTED ON THIS RECORD OF SURVEY WITH RED PAINTED  
 QUARTER BLAZES, PLACE 5-1/2' GALVANIZED STEEL POSTS ON LINE AT  
 INTERVALS NOT TO EXCEED 200', AND FLAG WITH RED PLASTIC  
 FLAGGING.

CONTROL FOR THIS SURVEY WAS ESTABLISHED BY TYING EXISTING  
 CORNER MONUMENTS IN A CLOSED LOOP TRAVERSE.  
 THE NORTH SIXTEENTH CORNER TO SECTIONS 32 AND 33 WAS SET AT  
 PROPORTIONATE MEASURE BETWEEN AS-TIED CORNERS AS SHOWN  
 ON THIS MAP.

THE BASIS OF BEARING FOR THIS SURVEY WAS THE 1984 BLM  
 DEPENDANT RESURVEY OF SECTION 33, TOWNSHIP 21 SOUTH,  
 RANGE 5 WEST, WILLAMETTE MERIDIAN.

THIS SURVEY WAS PERFORMED USING A NIKON TOTAL STATION.

N1/16 CORNER  
 SECTIONS 32, 33  
 SET 5/8" X 30" REBAR WITH  
 2-1/2" ALUMINUM CAP MARKED  
 AS SHOWN WITH THE FOLLOWING  
 ACCESSORIES:

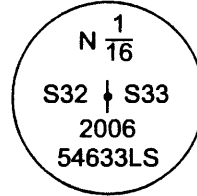

9" D. FIR BEARS N70°E 17.4' - BLAZED, SCRIBED "N1/16 S33 BT"  
 21" D. FIR BEARS S19°W 12.1' - BLAZED, SCRIBED "N1/16 S32 BT"

ALL BT'S HAVE RED PAINTED BAND AND FACE PLUS  
 BEARING TREE TAG. GALVANIZED POST SET ADJACENT  
 TO CORNER MONUMENT.

**LEGEND**

- FOUND SECTION CORNER AS NOTED
- FOUND QUARTER CORNER AS NOTED
- SET SIXTEENTH CORNER AS NOTED
- POSTED LINE AS DEFINED IN NARRATIVE
- RECORD DATA  
1984 BLM DEPENDANT RESURVEY

1/4 CORNER  
 SECTIONS 32, 33  
 FOUND 3-1/4" BLM BRASS CAP  
 DATED 1981 WITH THE FOLLOWING  
 ACCESSORIES:

30" D. FIR BEARS N63-1/4°E 30.4' - HEALED FACE  
 25" D. FIR BEARS N34°W 2.6' - HEALED FACE  
 36" ORIGINAL OAK BEARS N63°W 363' - DOWN  
 AND ROTTED

ALL BT'S HAVE RED PAINTED  
 BAND AND FACE PLUS  
 BEARING TREE TAG.  
 GALVANIZED POST SET ADJACENT  
 TO CORNER MONUMENT.




**Ward NorthWest, Inc.**

P.O. BOX 105 FLORENCE, OR 97439  
 (541) 997-9201 FAX: 541-997-3546

FILE NAME 06-67.TRV		
SCALE 200 Ft/In	DATE 8-11-2006	DRAWN BY JR
JOB 06-67	REVISION -----	SHEET 1/1

This map drawn with TRAVERSE PC, Software

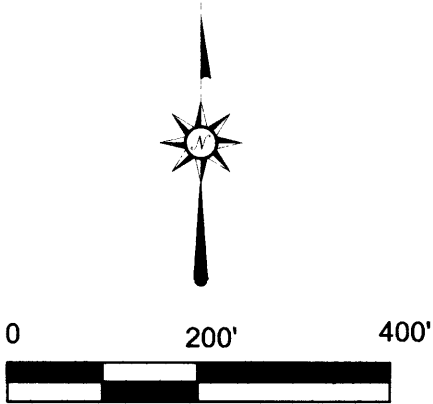

BASIS OF BEARING  
 1984 BLM DEPENDANT RESURVEY OF SECTION 33  
 (N0°14'00"W 40.16 CH.) N0°14'00"W 2649.79'

N0°14'00"W 1324.89'

N0°14'00"W 1324.89'



REGISTERED  
 PROFESSIONAL  
 LAND SURVEYOR  
*Ronald L. Rice*  
 OREGON  
 JULY 9, 2002  
 RONALD L. RICE  
 54633LS

EXPIRES: 12-31-2006