PLAT OF SURVEY

LOCATED IN

SW 1/4, NE 1/4, SEC. 5, T. 33 S., R. 6 W., W.M.

BLOCK 36, LOT 1 & LOT 2, CITY OF GLENDALE

DOUGLAS COUNTY, OREGON

APRIL 3, 2007

FILED
Date: 4/23/2007 By: JC
This survey consists of:
Map: M152-72
Narrative:
Corner Rpt:
DOUGLAS COUNTY
SURVEYOR

MAP FILE M152-72

REGISTERED
PROFESSIONAL
LAND SURVEYOR
Raymond W Wytcherley
OREGON
JULY 25, 1995
RAYMOND W. WYTCHERLEY
2724
EXPIRES JUNE 30, 2008

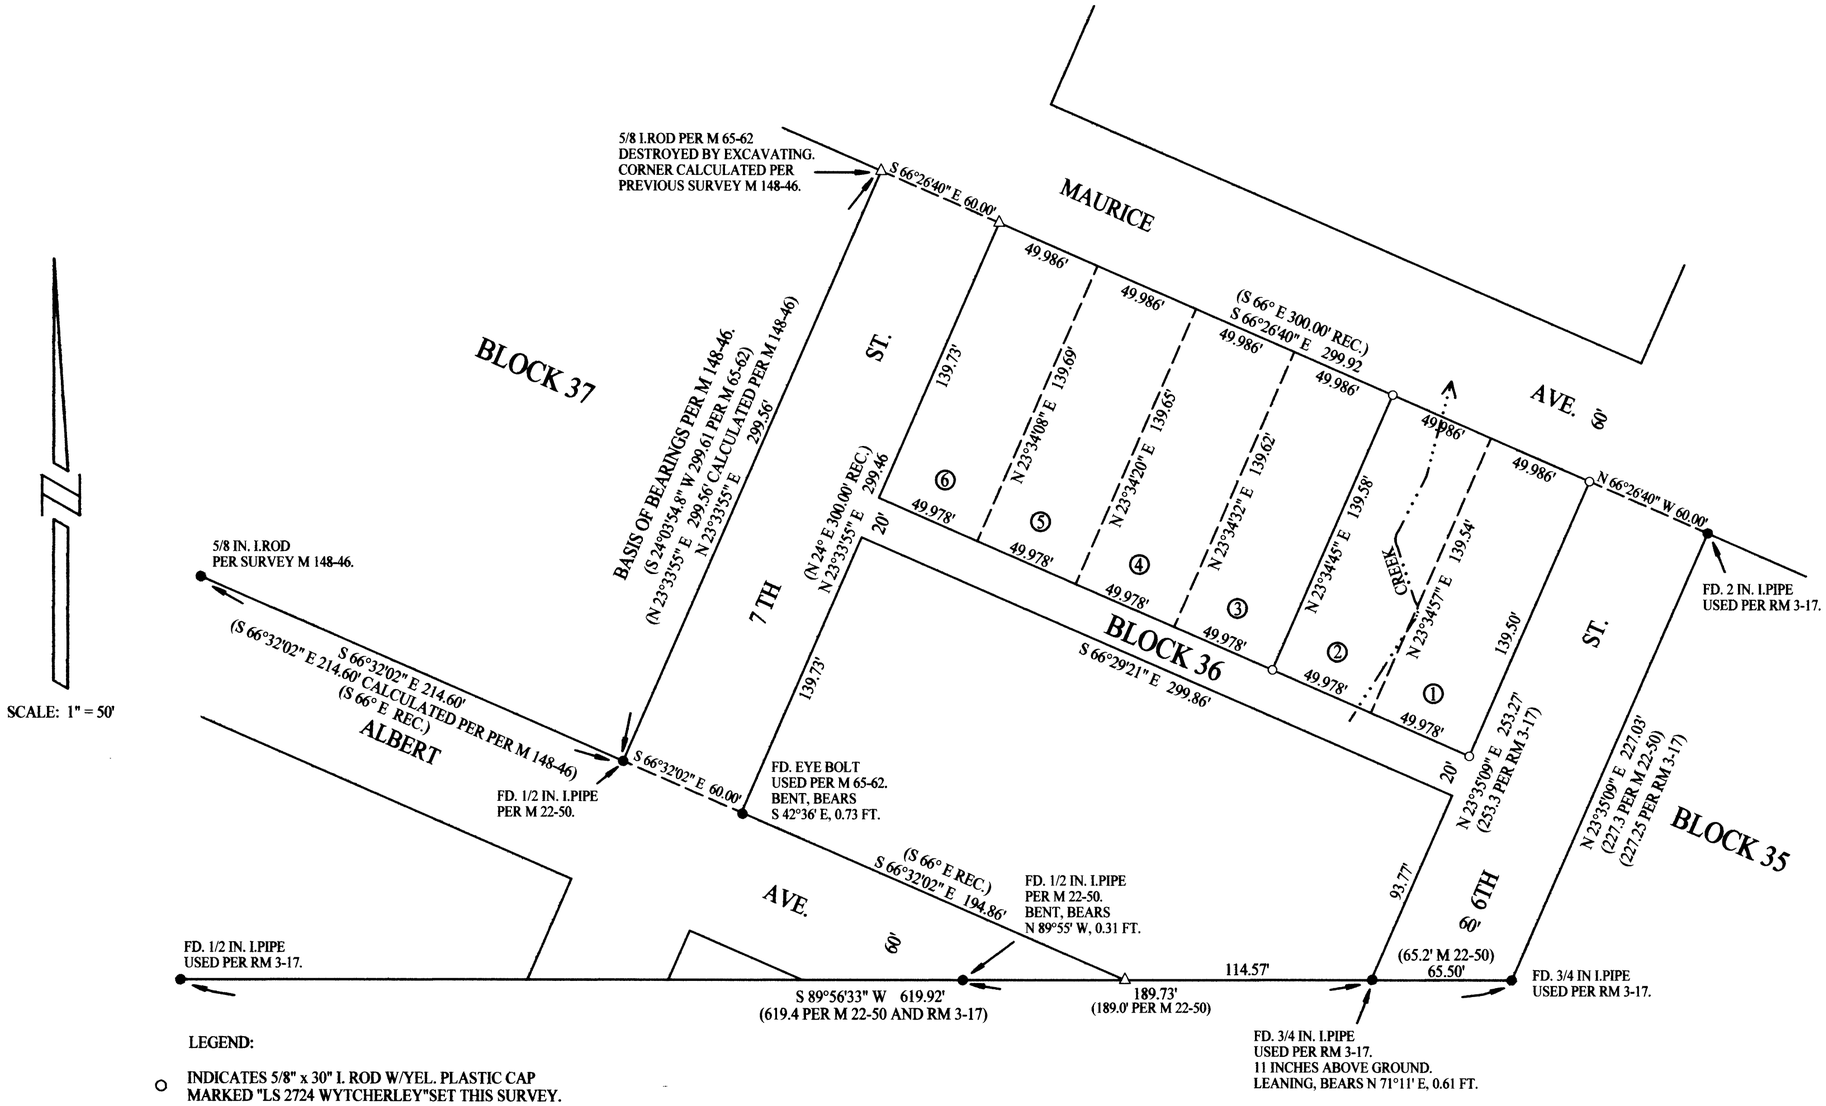

SCALE: 1" = 50'

LEGEND:

- ○ INDICATES 5/8" x 30" I. ROD W/YEL. PLASTIC CAP MARKED "LS 2724 WYTCHERLEY"SET THIS SURVEY.
- ● INDICATES MONUMENT FOUND AS INDICATED.
- △ INDICATES CALCULATED POINT.
- ( ) INDICATES RECORD AS INDICATED.

BASIS OF BEARINGS PER M 148-46.

PLOTTED BY A HP DESIGNJET 500 ON MILANO IMAGING # JPC4M2 POLYESTER FILM WITH HP CARTRIDGE # 4844A.

THE PURPOSE OF THIS SURVEY IS TO MONUMENT THE CORNERS OF LOTS 1 & 2, BLOCK 36, CITY OF GLENDALE, DOUGLAS COUNTY, OREGON. I FOUND AND HELD THE MONUMENTS AS SHOWN ON THIS PLAT. CONTROL POINTS AND DATA FROM MY PREVIOUS SURVEY M 148-46 WAS USED TO CALCULATE BLOCK 37.

THIS SURVEY WAS PERFORMED WITH A NIKON DTM 520 TOTAL STATION WITH A RECON TDS DATA COLLECTOR USING A FULL SET OF DIRECTIONAL ANGLES.

SURVEYED FOR:
BOB AND GERRI HICKS
3700 S WESTPORT AVE. # 2703,
SIOUX FALLS, SD 57106

SURVEYED BY:
RAYMOND WYTCHERLEY
WYTCHERLEY SURVEYING
P.O. BOX 888
GLENDALE, OR 97442
541-832-3286
541-660-2648

MAP FILE M152-72