MAP OF SURVEY

LOCATED in the NW 1/4 of Section 24, T. 24 S., R. 7 W., W.M.
in Douglas County, Oregon.

July 17, 2007

FILED
Date: 7-18-2007 By: JC
This survey consists of:
Map: M153-56
Narrative:
Corner Rpt:
DOUGLAS COUNTY SURVEYOR

MAP FILE M153-56

SURVEYED FOR: *ROSEBURG RESOURCES CO.*
P.O. BOX 1088
ROSEBURG, OREGON 97470

SURVEYED BY: *DAVID EDWARDS LAND SURVEYING*
P.O. BOX 361
OAKLAND, OREGON 97462
PHONE: (541) 459-0512

REGISTERED PROFESSIONAL LAND SURVEYOR
David A. Edwards
OREGON
JULY 24, 1986
DAVID A. EDWARDS
2339
RENEWS 12/31/07

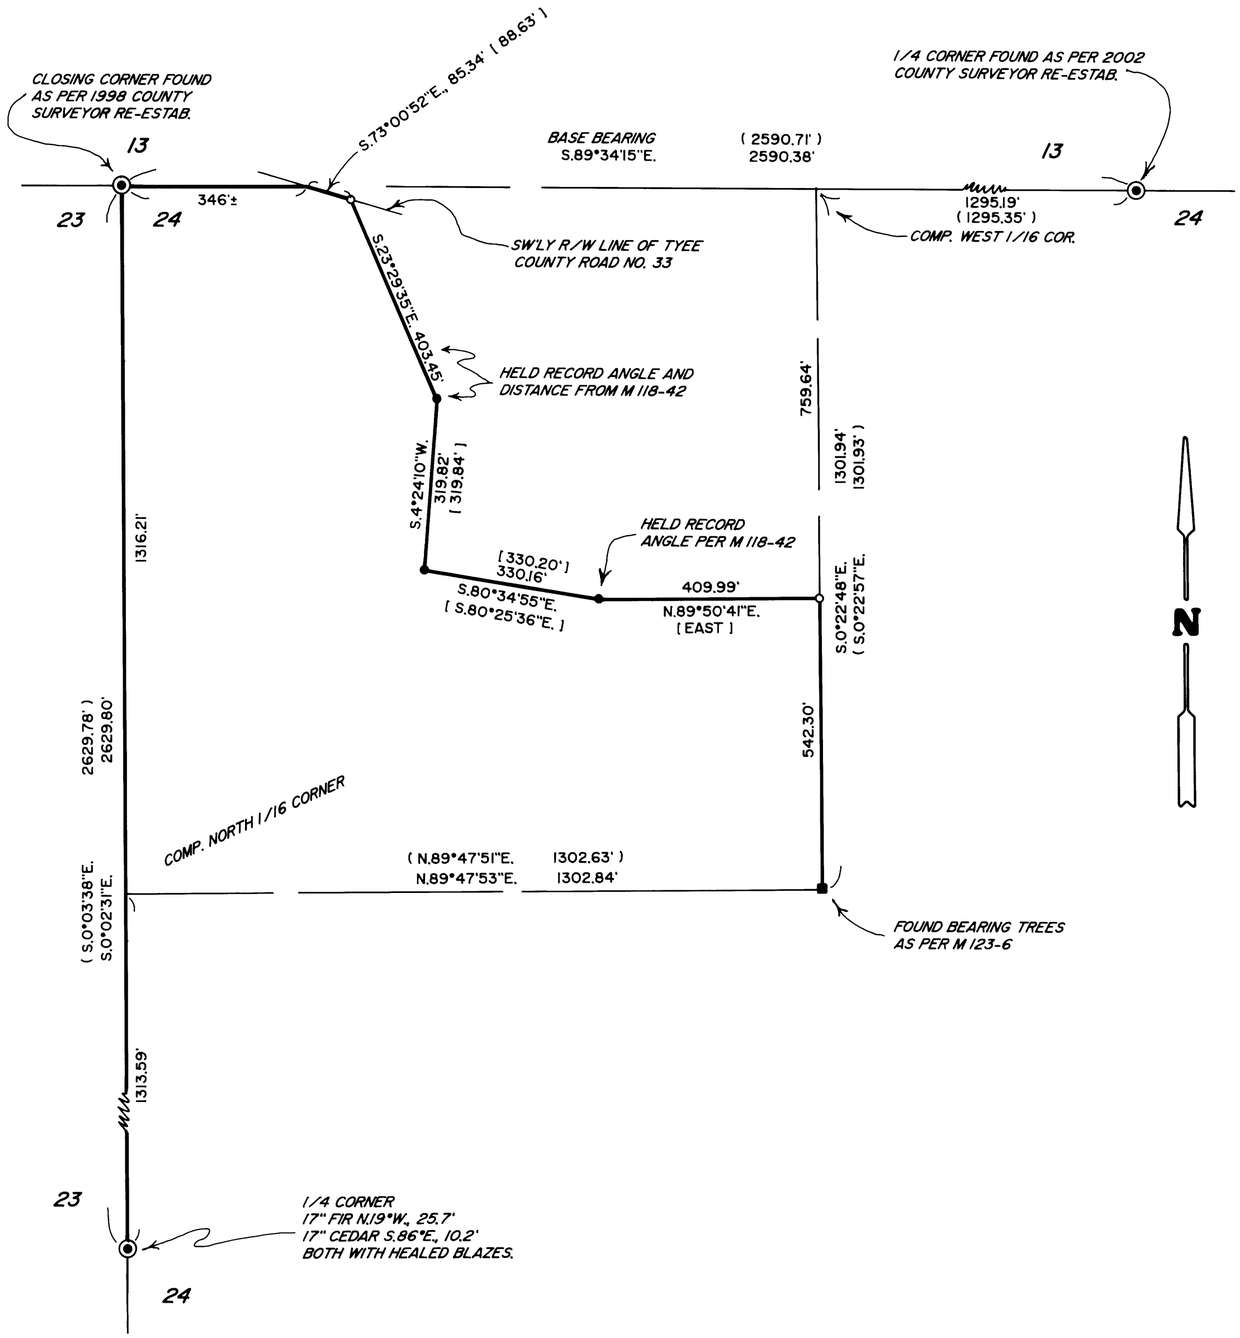

LEGEND

- ◉ INDICATES DOUGLAS COUNTY SURVEYOR OR B.L.M. BRASS CAP FOUND.
- ● INDICATES 5/8" DIAM. IRON ROD WITH CAP FOUND PER M 118-42.
- ■ INDICATES 5/8" DIAM. IRON ROD WITH CAP FOUND AT NW 1/16 CORNER PER M 123-6.
- ○ INDICATES 5/8" X 30" STEEL REBAR W/RED PLASTIC CAP MKD. "D.A. EDWARDS-LS 2339" SET.
- ( ) DENOTES RECORD DATA PER M 123-6 UNLESS NOTED OTHERWISE.
- [ ] DENOTES RECORD DATA PER M 118-42.
- ——— INDICATES LINE BLAZED, POSTED AND FLAGGED THIS SURVEY.

SCALE: 1" = 200' COMP. = COMPUTED.

BASIS OF BEARINGS: M 123-6 AS SHOWN.

NARRATIVE

THE PURPOSE OF THIS SURVEY IS TO BLAZE, POST AND FLAG THOSE BOUNDARIES SHOWN AS BOLD LINES HEREON.

THE LINES WERE MARKED BY BLAZING TREES ON EACH SIDE OF LINE, BY SETTING 6 FOOT STEEL POSTS ON TRUE LINE AT INTERVALS OF 200 FEET OR LESS AND BY HANGING LIBERAL AMOUNTS OF RED FLAGGING ALONG TRUE LINE.

THE WEST LINE OF THE SW 1/4 OF SECTION 24 WAS ALSO BLAZED, POSTED AND FLAGGED. WE FIND THE SOUTHWEST CORNER OF SECTION 24 AS DESCRIBED IN C.S. 65/36-4.

FIELD CREW: BRANT MILLER AND ERIC SPRINKLE.

EQUIPMENT: NIKON TOTAL STATION.

COMPUTATIONS AND DRAFTING: DAVID EDWARDS.

MAP FILE M153-56