

PLSS ID. NO. 600700  
S35 | S36

S2 | S1

FILED

Date: 7/23/2007 By: JC

This survey consists of:

Map: M153-59

Narrative: \_\_\_\_\_

Corner Rpt: \_\_\_\_\_

DOUGLAS COUNTY  
SURVEYOR

SILVER BUTTE  
NE 1/4  
22-5-2-00200

(N 00°03' E 38.87 Ch.)  
N 00°03'37" E 2566.60'

# RECORD OF SURVEY

LOCATED IN  
SECTION 2, T.22S., R.5W., W.M.  
DOUGLAS COUNTY, OREGON

**NARRATIVE:**

THE PURPOSE OF THIS SURVEY IS TO POST AND BLAZE THE EAST LINE OF SECTION 2. THE SECTION CORNER OF 1, 2, 11, AND 12, THE 1/4 CORNER OF 1 AND 2, AND THE SECTION CORNER OF 1, 2, 35, AND 36 WERE ACCEPTED PER THE BLM DEPENDENT RESURVEY IN 1984.

A CONTROL SURVEY WAS PERFORMED UTILIZING A STATIC GPS CONTROL SURVEY WITH RTK AND CONVENTIONAL TRAVERSE LOOPS AND TIES SURVEYED TO CONTROLLING CORNERS AND ALONG BOUNDARY LINES POSTED. ALL SURVEY OBSERVATIONS WERE TAKEN WITH A LEICA TCRP 1203 TOTAL STATION AND LEICA SYSTEMS 1200 GPS RECEIVERS AND WERE ADJUSTED BY LEAST SQUARES METHODS. THIS SURVEY WAS PERFORMED BY LESTER FANNING, ADAM DEGROOT, AND JOEL HERZBERG WITH COMPUTATIONS AND DRAFTING BY KRIS DEGROOT AND JOEL HERZBERG.

1/4 PLSS ID. NO. 600640

**LEGEND:**

● = FOUND 1 1/4" IRON POST WITH BRASS CAP  
PER PLSS ID. NO. 600600

● = FOUND 2 1/2" ALUMINUM POST WITH ALUMINUM CAP  
PER PLSS ID. NO. 600640

◆ = FOUND 2 1/2" IRON POST WITH BRASS CAP  
PER PLSS ID. NO. 600700

— PL — = PROPERTY LINE BLAZED & POSTED w/5 1/2' STEEL POSTS

( ) = RECORD PER THE BLM DEPENDENT RESURVEY IN 1984


(N 00°03' E 39.87 Ch.)  
N 00°02'05" E 2631.62'

SILVER BUTTE  
SE 1/4  
22-5-2-00200

S2 | S1  
S11 | S12

PLSS ID. NO. 600600

GPS OBSERVATION

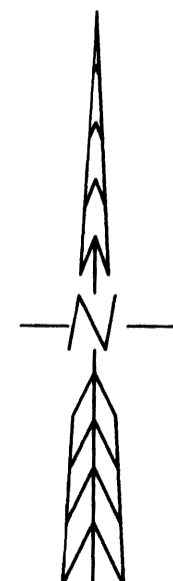

B.T.S.

REGISTERED  
PROFESSIONAL  
LAND SURVEYOR

*Kristian O. Degroot*

OREGON  
JULY 17, 1981  
KRISTIAN O. DEGROOT  
1941

RENEWAL DATE: 12-31-07

**BTS ENGINEERING & SURVEYING, INC.**

431 S.E. MAIN ST., ROSEBURG, OR 97470  
PHONE (541) 673-0966 FAX (541) 673-0105

SCALE: 1" = 400'

DATE: JULY 18, 2007

FOR:

SILVER BUTTE TIMBER CO.  
P.O. BOX 4  
RIDDLE, OR 97469

JOB #: 07-026

FILE: 06-098 JOHNSON CRK.DWG

SHEET 1 OF 1