A SURVEY FOR HARVEY HANSEN

LOCATED IN ALL FOUR 1/4 SECTIONS OF SECTION 1,
T29S, R5W, W.M., DOUGLAS COUNTY, OREGON

FILED
Date: 9-5-2007 By:
This survey consists of
Map: M154-7
Narrative:
Corner Rpt:
DOUGLAS COUNTY SURVEYOR

MAP FILE M154-7

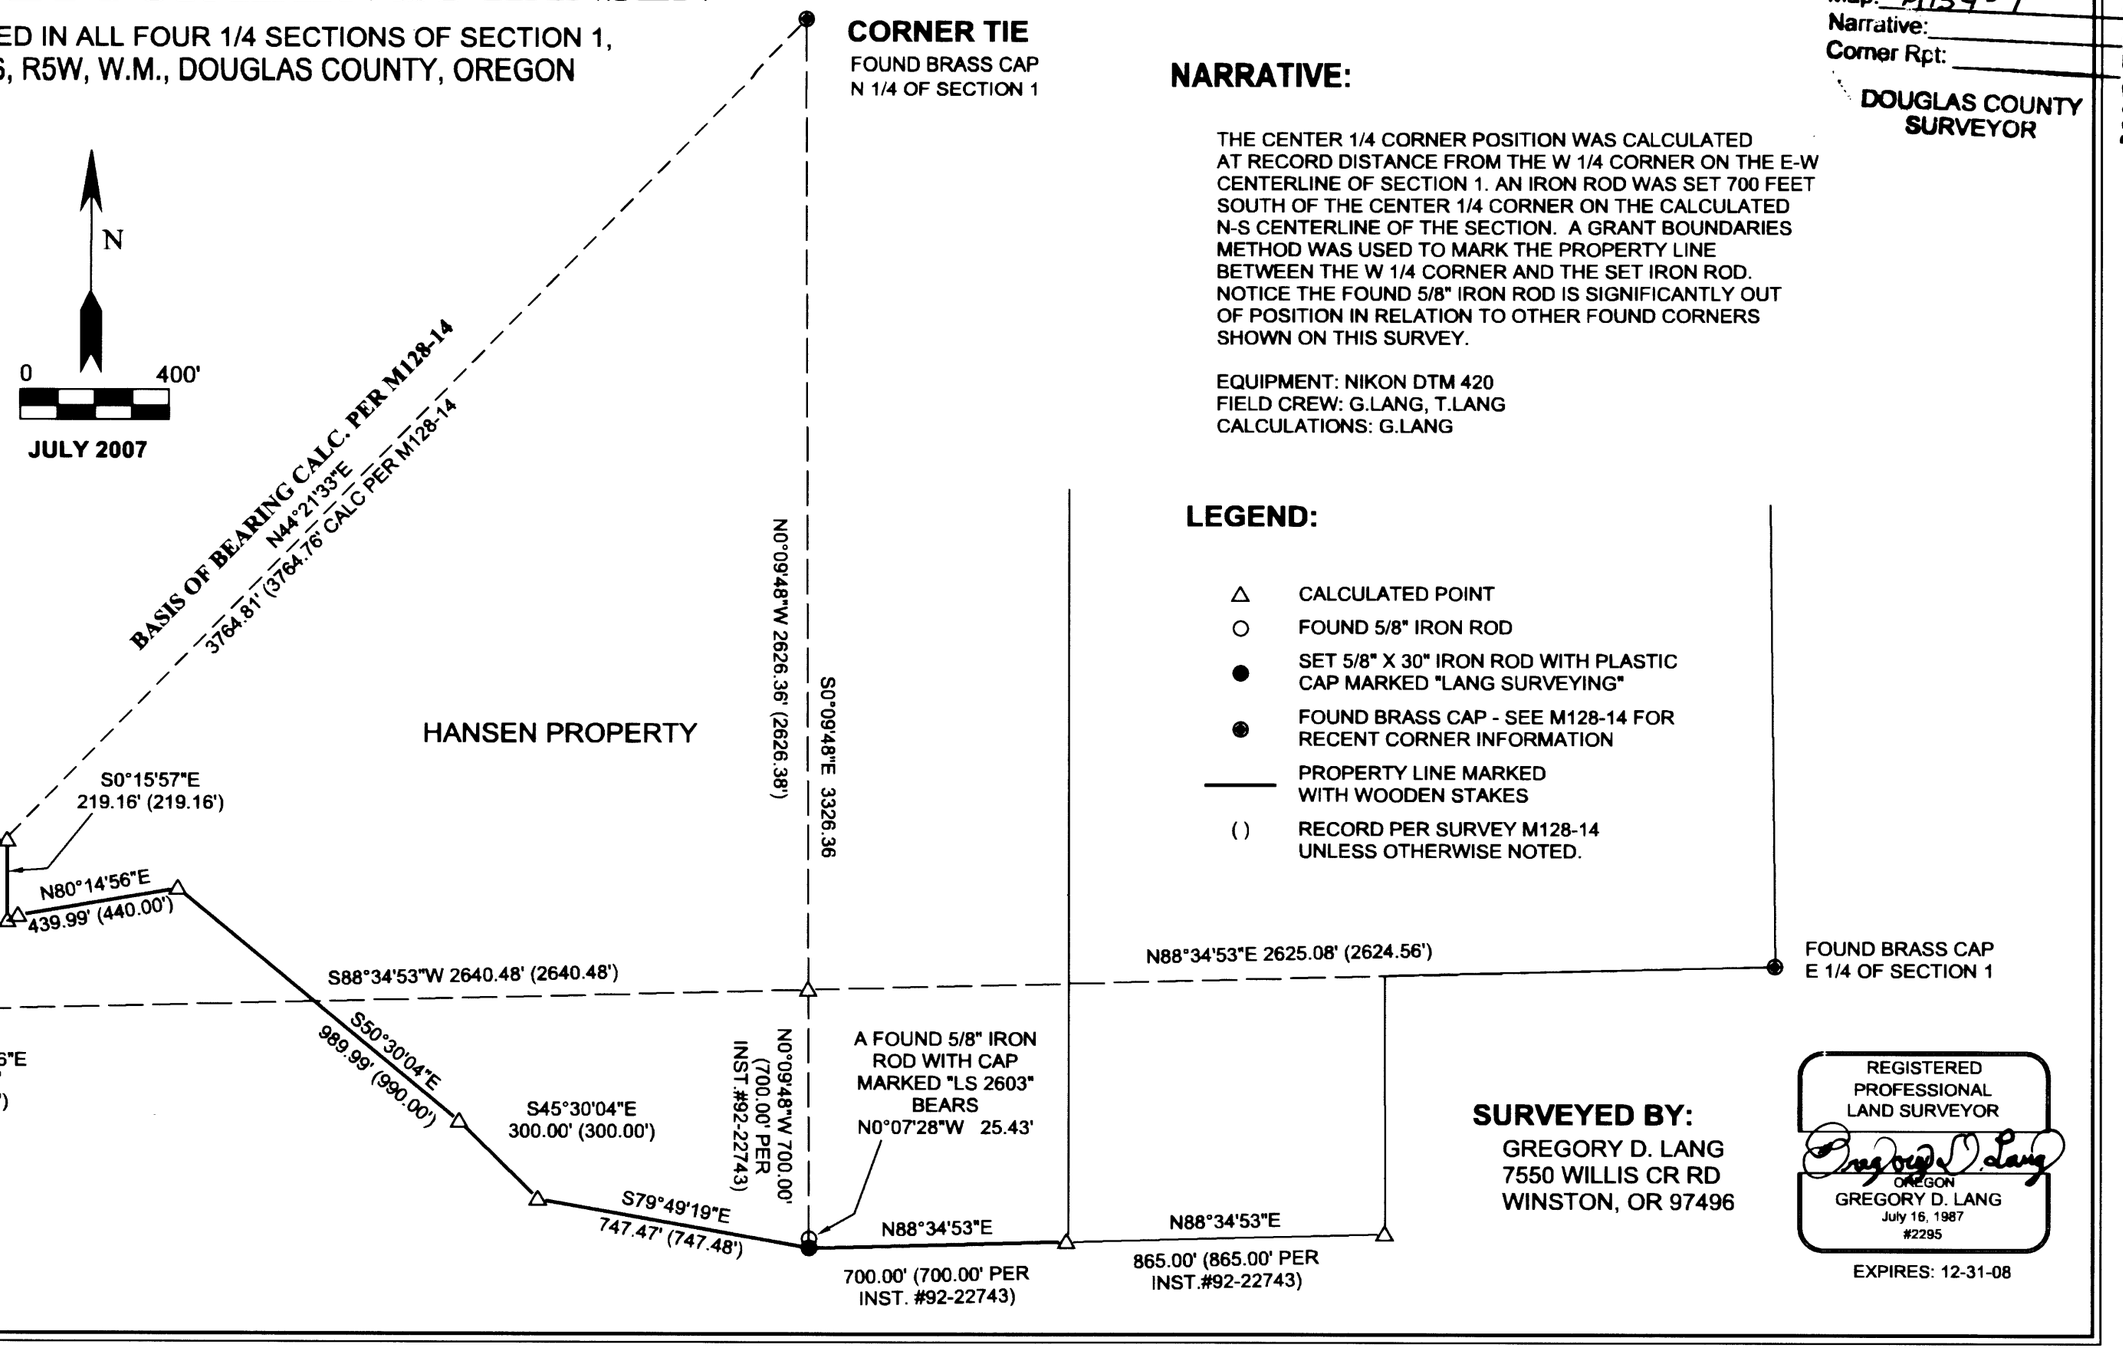

NARRATIVE:

THE CENTER 1/4 CORNER POSITION WAS CALCULATED AT RECORD DISTANCE FROM THE W 1/4 CORNER ON THE E-W CENTERLINE OF SECTION 1. AN IRON ROD WAS SET 700 FEET SOUTH OF THE CENTER 1/4 CORNER ON THE CALCULATED N-S CENTERLINE OF THE SECTION. A GRANT BOUNDARIES METHOD WAS USED TO MARK THE PROPERTY LINE BETWEEN THE W 1/4 CORNER AND THE SET IRON ROD. NOTICE THE FOUND 5/8" IRON ROD IS SIGNIFICANTLY OUT OF POSITION IN RELATION TO OTHER FOUND CORNERS SHOWN ON THIS SURVEY.

EQUIPMENT: NIKON DTM 420
FIELD CREW: G.LANG, T.LANG
CALCULATIONS: G.LANG

LEGEND:

- △ CALCULATED POINT
- ○ FOUND 5/8" IRON ROD
- ● SET 5/8" X 30" IRON ROD WITH PLASTIC CAP MARKED "LANG SURVEYING"
- ◉ FOUND BRASS CAP - SEE M128-14 FOR RECENT CORNER INFORMATION
- —— PROPERTY LINE MARKED WITH WOODEN STAKES
- ( ) RECORD PER SURVEY M128-14 UNLESS OTHERWISE NOTED.

SURVEYED BY:
GREGORY D. LANG
7550 WILLIS CR RD
WINSTON, OR 97496

REGISTERED
PROFESSIONAL
LAND SURVEYOR
Gregory D. Lang
OREGON
GREGORY D. LANG
July 16, 1987
#2295

EXPIRES: 12-31-08

MAP FILE M154-7

Traverse PC